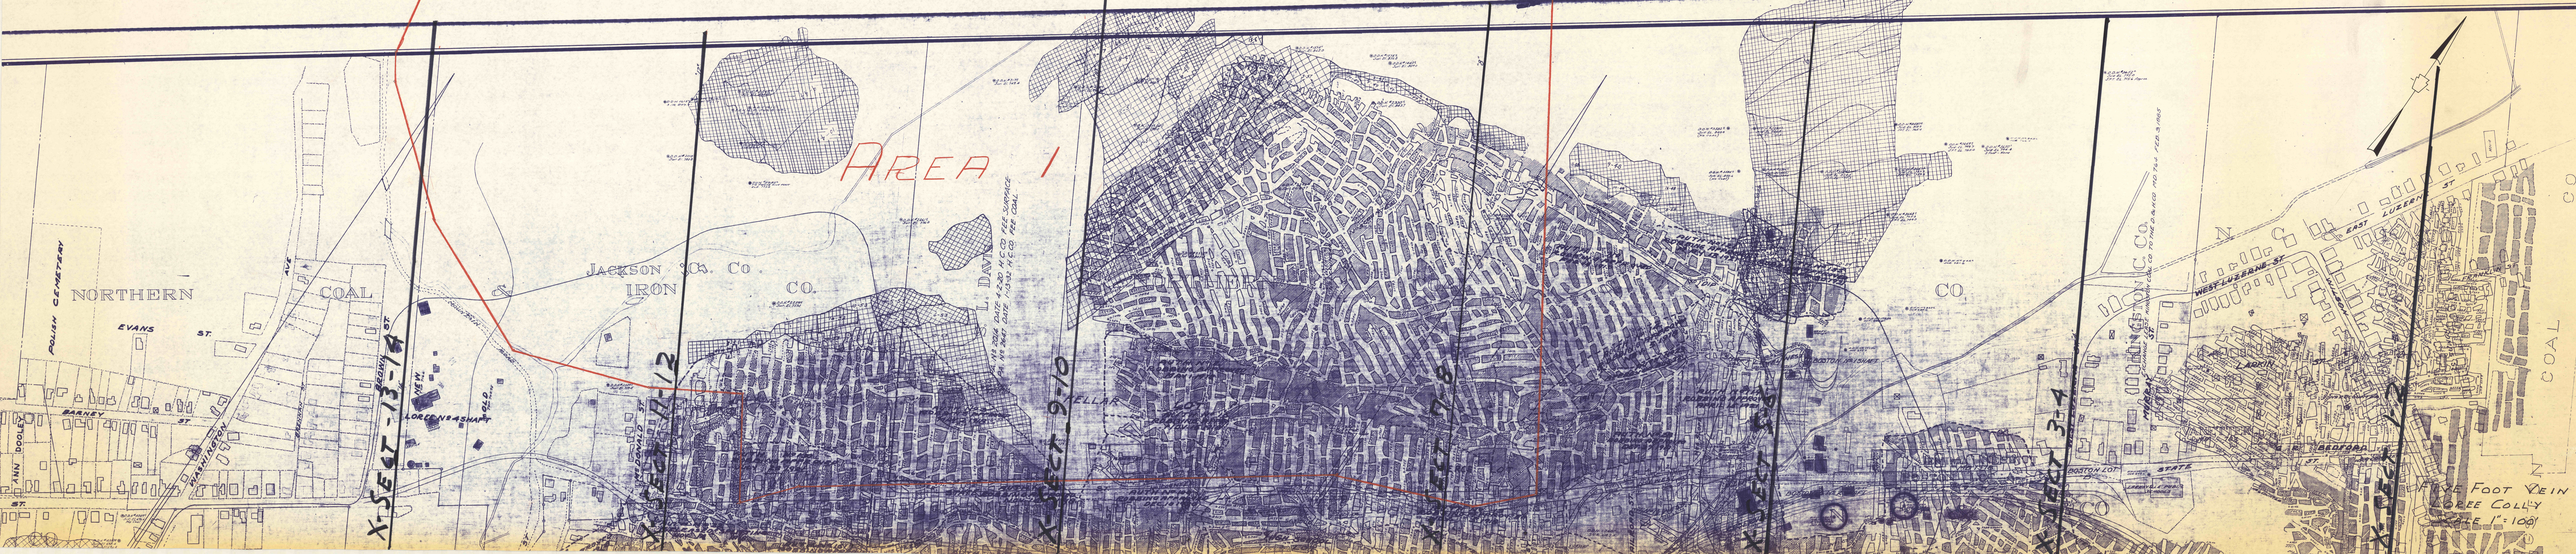
AREA 1
NORTHERN
COAL
JACKSON Co. Co
IRON
CO.
POLISH CEMETERY
EVANS ST.
BARNEY ST.
ANN DOOLEY ST.
DARLINGTON
LORCENASHAW
OLD
NEW
L. DAVIS
KELLER
BOSTON LOT
STATE
WEST LUZERNE ST
EAST LUZERNE ST
COAL
X-SECT 13-14
X-SECT 11-12
X-SECT 9-10
X-SECT 7-8
X-SECT 5-6
X-SECT 3-4
X-SECT 1-2
FOOT VEIN
COLLY
SCALE 1" = 100'