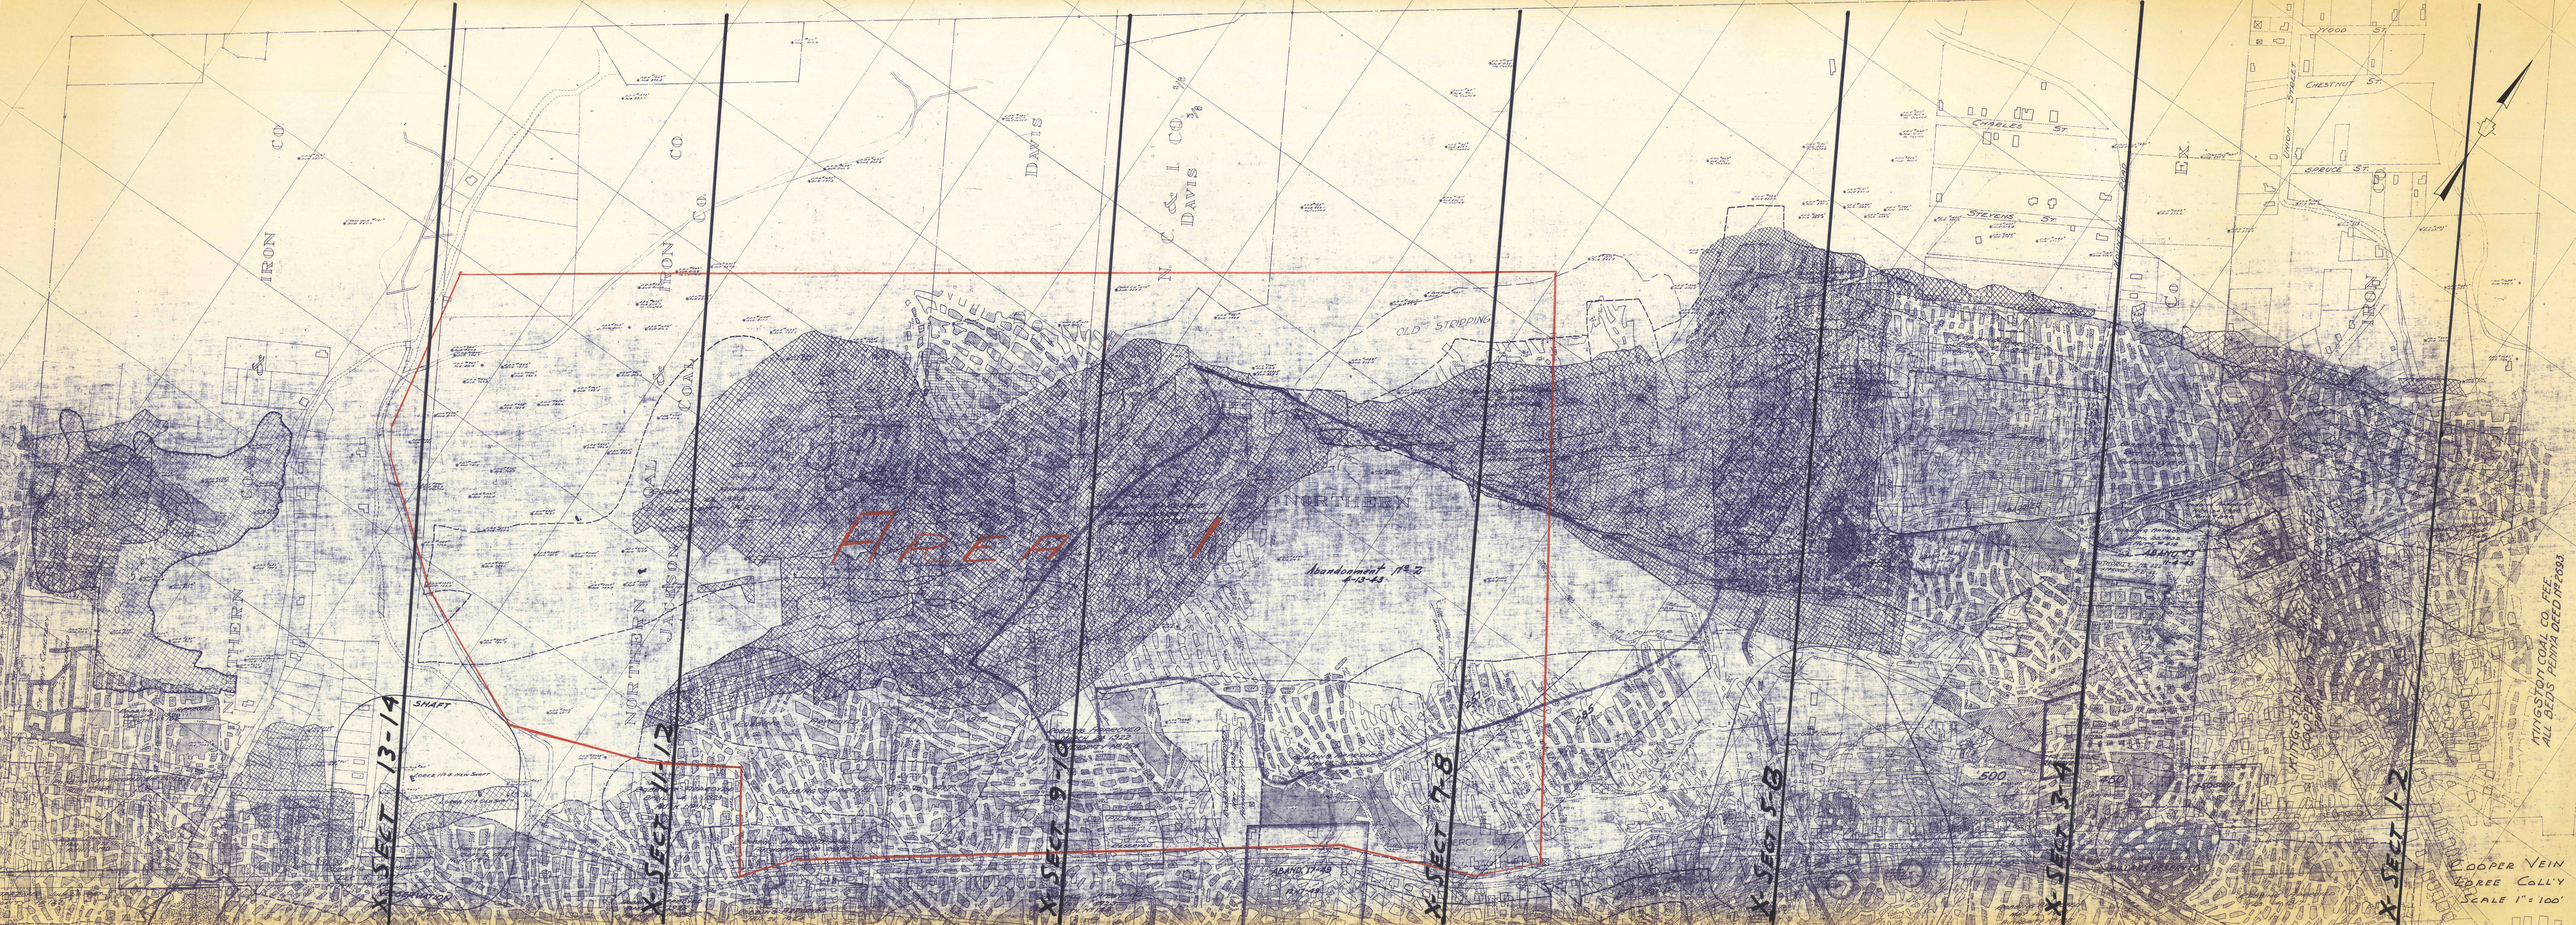
Area 1
X-SECT 13-14
X-SECT 11-12
X-SECT 9-10
X-SECT 7-8
X-SECT 5-6
X-SECT 3-4
X-SECT 1-2
SHAFT
NORTHERN
Abandonment 11-4-43
4-13-43
ABAND 11-4-43
ABAND 17-48
IRON CO
DAVIS
C & I CO
JACKSON COAL CO
OLD STRIPPING
CHARLES ST.
STEVENS ST.
SPRUCE ST.
CHESTNUT ST.
WOOD ST.
COOPER VEIN
EDREE COAL
SCALE 1" = 100'