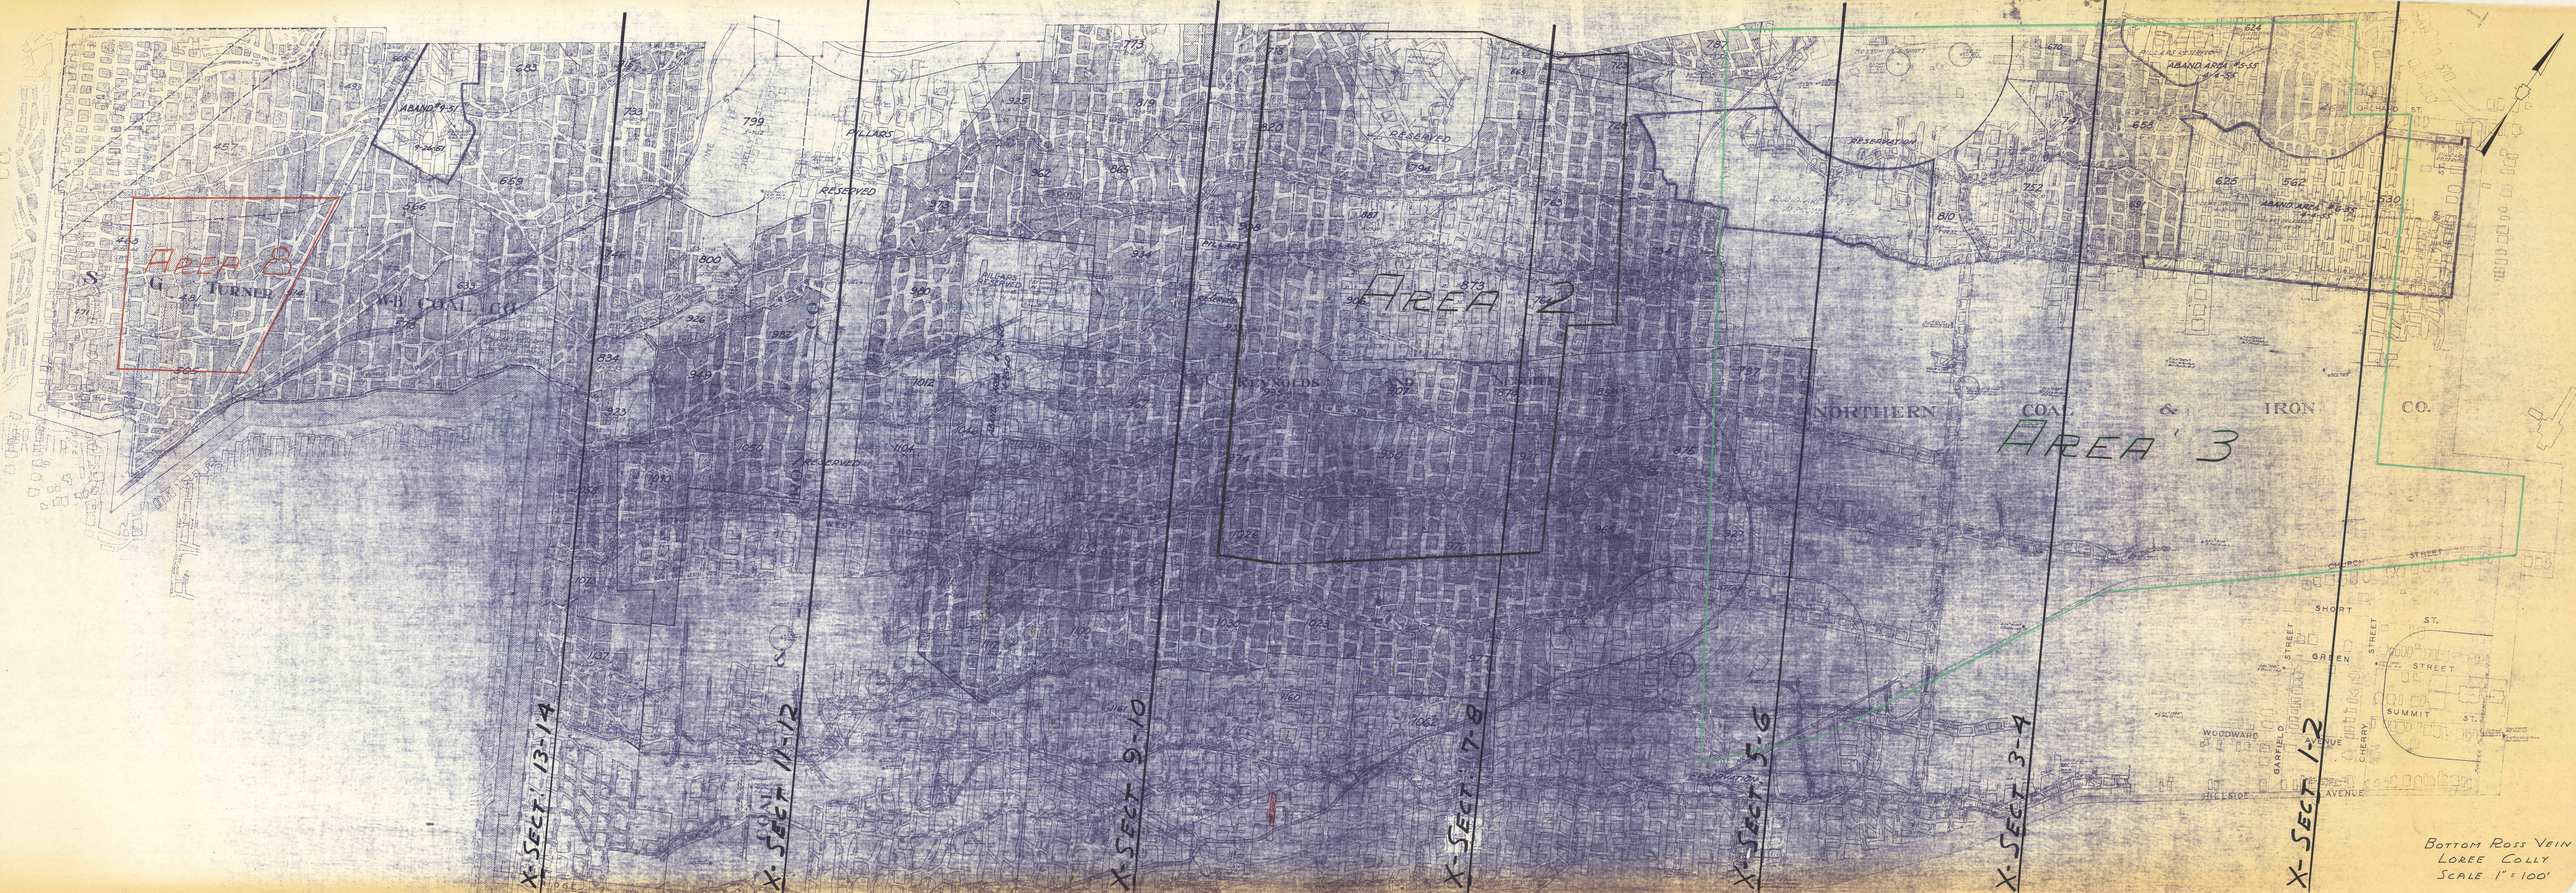

AREA 1
AREA 2
AREA 3
S. G. TURNER
W.B. COAL CO.
NORTHERN COAL & IRON CO.
REYNOLDS
RESERVATION
ABAND AREA 45-55
PILLARS RESERVED
X-SECT 13-14
X-SECT 11-12
X-SECT 9-10
X-SECT 7-8
X-SECT 5-6
X-SECT 3-4
X-SECT 1-2
CHURCH STREET
SHORT STREET
GREEN STREET
SUMMIT ST.
WOODWARD AVENUE
HILLSIDE AVENUE
GARFIELD
CHERRY
ORCHARD ST.
Bottom Ross Vein
Loree Colly
Scale 1" = 100'