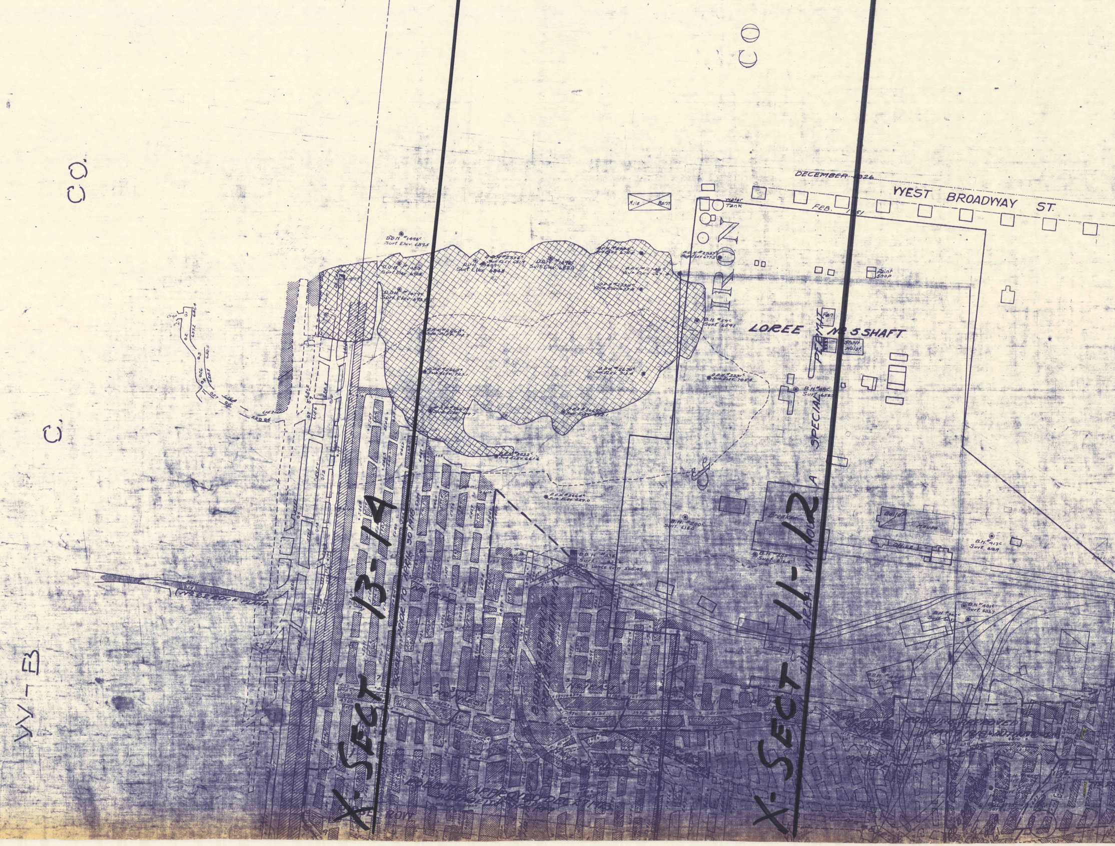

CO.
C.
W-B
CO
IRON
DECEMBER 1926
WEST BROADWAY ST.
FEB. 1951
Mule Barn
Water Tank
Paint Shop
Fan
LOREE No. 5 SHAFT
Shaft Hoist
SPECIAL PERMIT
B.H. #59C Surf. 6591
B.H. #49C Surf. 6587
D.D.H. #2737C Surf. Elev. 6772
D.D.H. #2231C Surf. Elev. 7054
D.D.H. #1496C Surf. Elev. 6895
D.D.H. #1479C Surf. Elev. 6935
D.D.H. #1498C Surf. Elev. 6829
B.H. #200C Surf. 6182
B.H. #417C Surf. 6189
B.H. #401C Surf. 6037
Breaker
Boiler House
Office
Dump
No. 22 ROCK PLANE
No. 17 PLANE
ROBBED PRIOR TO APRIL 30 1918
ROBBING APPROVED
THIS AREA WITHOUT A SPECIAL PERMIT
X-SECT 13-14
X-SECT 11-12

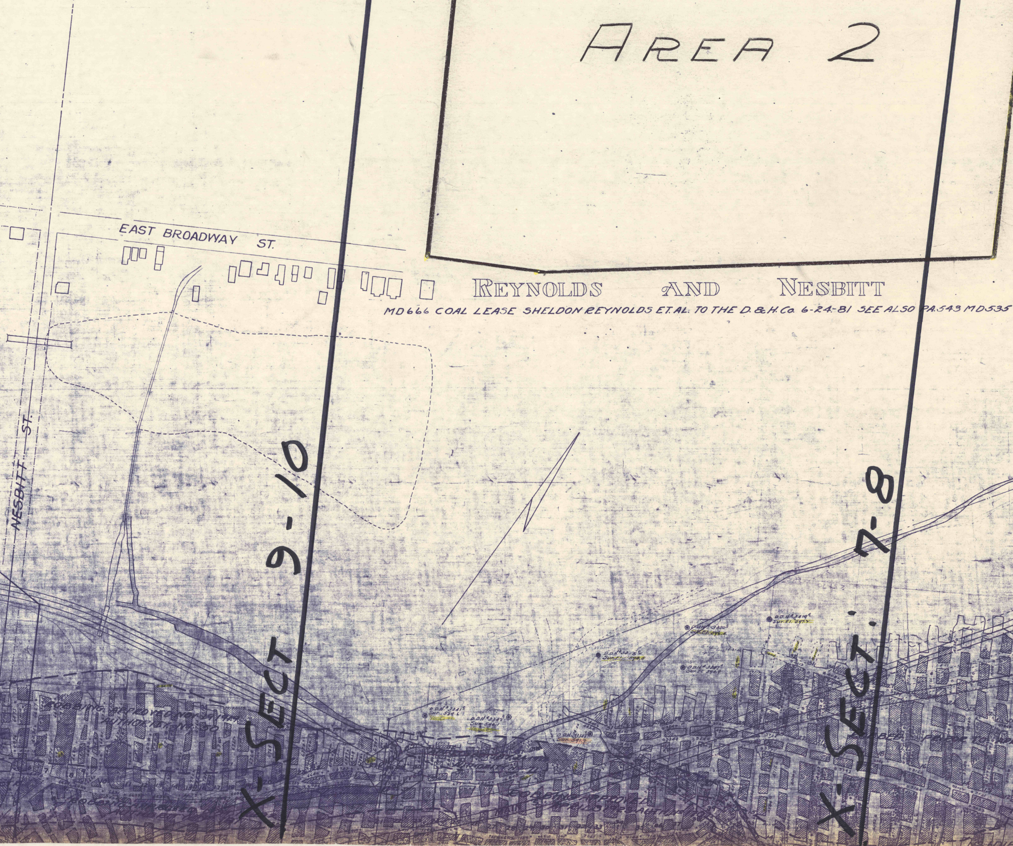
AREA 2
EAST BROADWAY ST.
NESBITT ST.
REYNOLDS AND NESBITT
MD666 COAL LEASE SHELDON REYNOLDS ET.AL. TO THE D.&H.Co. 6-24-81 SEE ALSO PA.543 MD535
X-SECT 9-10
X-SECT 7-8
D.D.H. 3419
Sur. El. 597.4
D.D.H. 3350
Sur. El. 596.4
D.D.H. 3215
Sur. El. 594.5
D.D.H. 3347
Sur. El. 594.4
D.D.H. 3341
Sur. 589.6
D.D.H. 3347
Sur. 590.1
D.D.H. 3343
Sur. 591.7

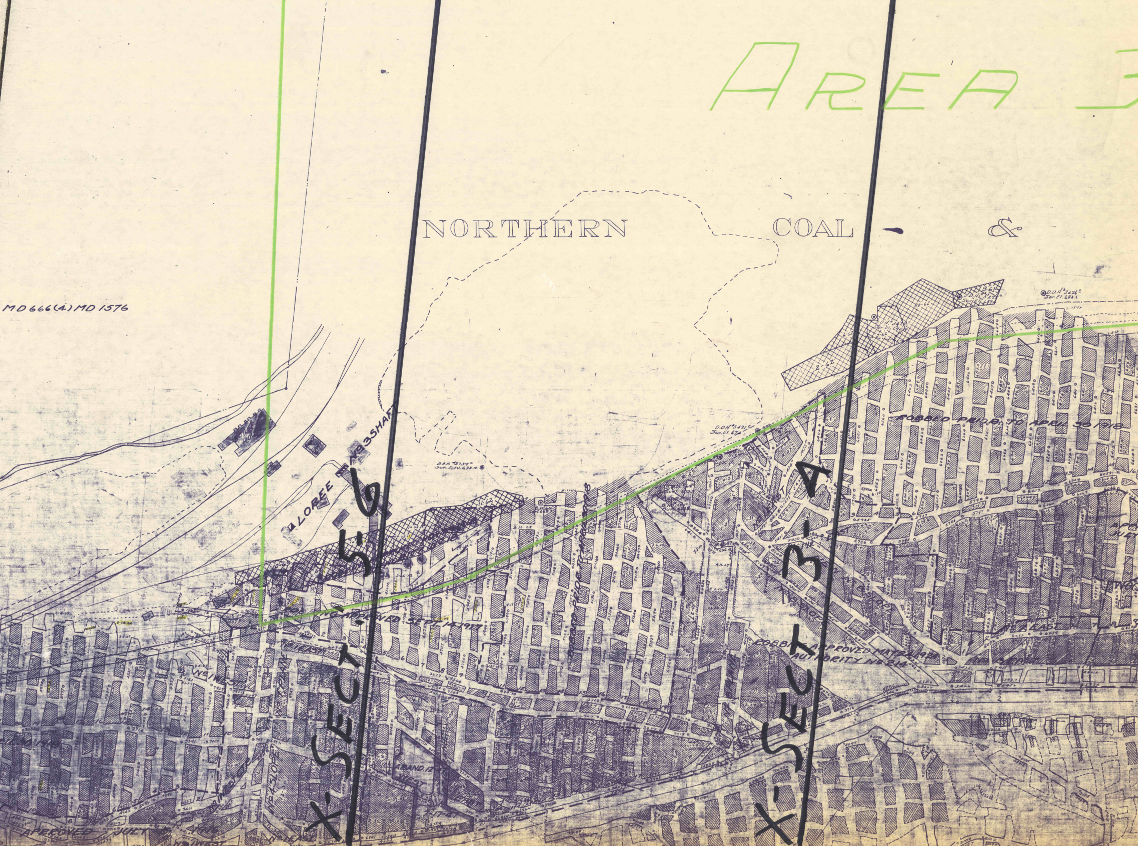
AREA 3
NORTHERN COAL &
MD 666(4) MD 1576
BOILER HOUSE
LOREE
No3 SHAFT
D.D.H. 2739
Sur. Elev. 673.4
D.D.H. 3421
Sur. El. 674
X-SECT 5-6
X-SECT 3-4
ROBBED PRIOR TO APRIL 30 1918
ROBBING APPROVED SEPT 14 1917
ROBBING APPROVED MAY 24 1928
AUTHORITY No 214
No 1 EAST
No 1 WEST
2-62
11-62
10-63
APPROVED JULY

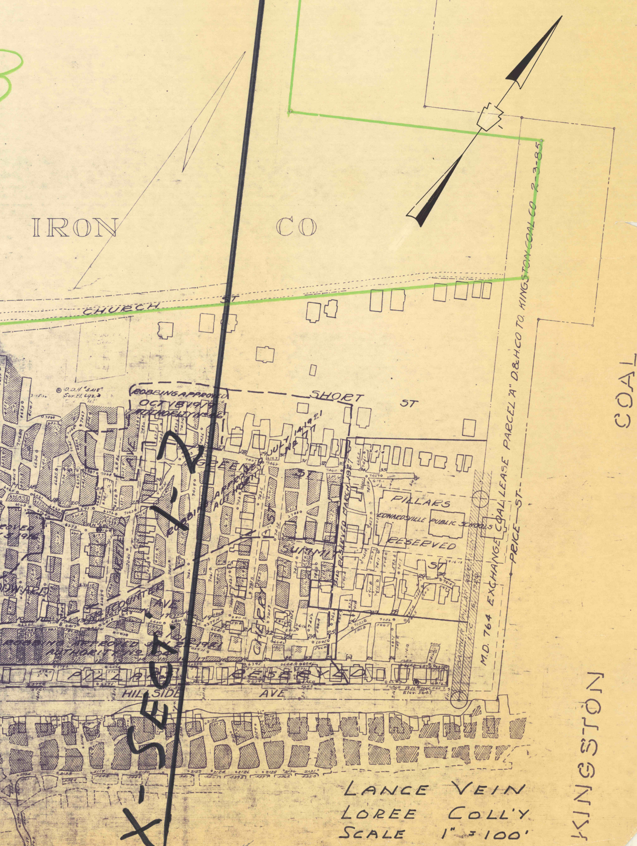
IRON CO
COAL
KINGSTON
CHURCH ST
SHORT ST
GREEN ST
SUMMIT ST
CHERRY ST
COUNTER AVE
HILLSIDE AVE
PRICE ST
PILLARS
EDWARDSVILLE PUBLIC SCHOOLS
RESERVED
ROBBING APPROVED OCT 18 1916 AUTHORITY No 26
ROBBING APPROVED JULY 14 1921 AUTHORITY No 77
RESERVED MARCH 1927
ROBBING APPROVED JAN 25 1921 AUTHORITY No 104
PILLARS RESERVED
BARRIER PILLAR AGREEMENT DEC 16 1919
M.D. 764 EXCHANGE COAL LEASE PARCEL "A" D.&H.CO TO KINGSTON COAL CO 2-3-85
B.H. 711AC
Elev. 5647
X-SECT. 1-2

LANCE VEIN
LOREE COLL'Y
SCALE 1" = 100'