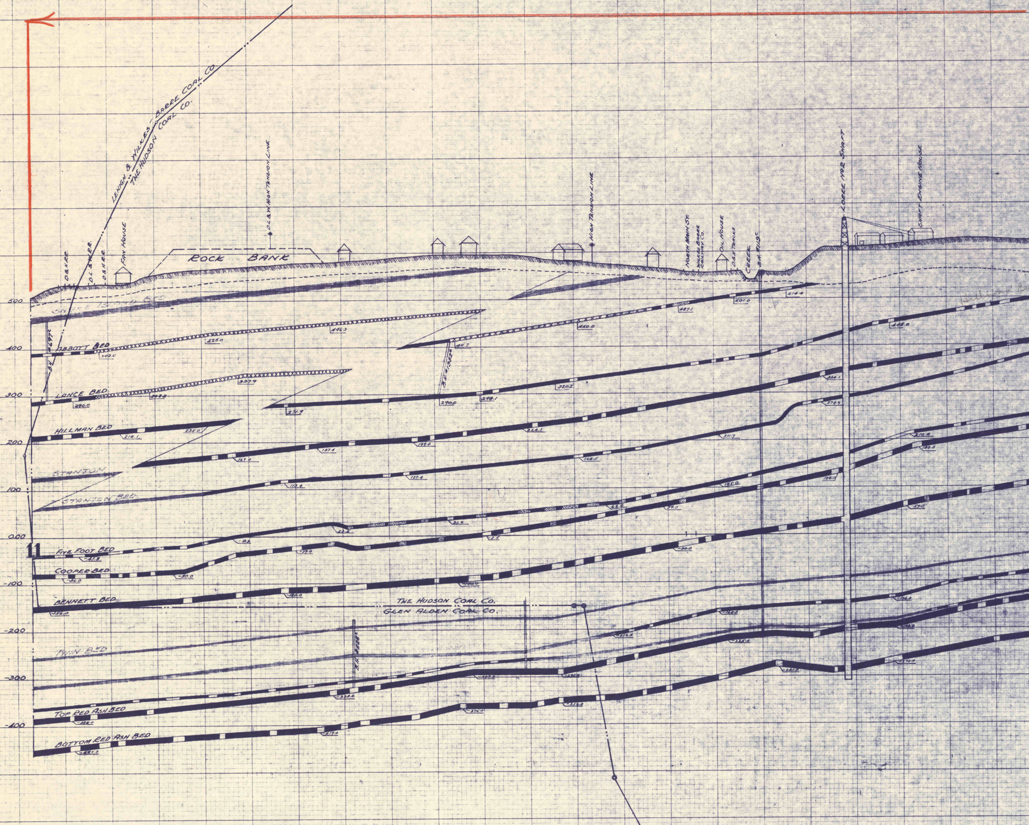

LEHIGH & WILKES-BARRE COAL CO.
THE HUDSON COAL CO.
D.&H.R.R.
D.L.&W.R.R.
D.&H.R.R.
FAN HOUSE
D.L.&W. HIGH TENSION LINE
ROCK BANK
HIGH TENSION LINE
NORTH MAIN ST.
WILKES BARRE RAILWAY CO.
OIL HOUSE
D.&H. TRACKS
CREEK
B.H. #119
LOREE No2 SHAFT
SHAFT ENGINE HOUSE
500
400
300
200
100
0.00
-100
-200
-300
-400
11
SNAKE ISLAND BED
ABBOTT BED
LANCE BED
HILLMAN BED
STANTON
STANTON BED
FIVE FOOT BED
COOPER BED
BENNETT BED
TWIN BED
TOP RED ASH BED
BOTTOM RED ASH BED
THE HUDSON COAL CO.
GLEN ALDEN COAL CO.
B.H. #697
B.H. #1352
B.H. #828
Hillman Bed
514.4
501.0
487.1
450.0
446.3
425.0
411.7
392.0
445.0
337.9
308.2
334.1
320.2
298.1
290.0
290.0
271.9
278.9
235.0
224.1
218.1
211.7
199.0
187.4
169.4
166.5
127.4
113.4
128.0
105.0
210.4
192.0
62.0
59.0
59.0
31.9
23.5
-2.5
-8.2
-29.0
-30.0
-41.8
-80.0
-86.0
-100.0
-120.0
-136.0
-156.0
-165.0
-190.0
-212.4
-225.0
-275.0
-281.0
-296.0
-297.0
-338.0
-356.0
-376.0
-388.0
-417.0
-465.0

SOUTH SECTION

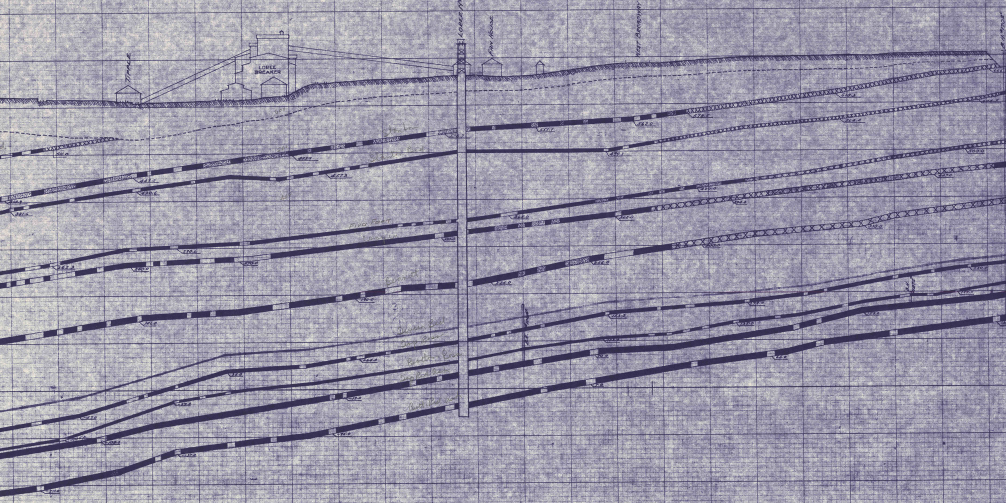
TIPPLE
LOREE BREAKER
LOREE No 5 SHAFT
FAN HOUSE
WEST BROADWAY
B.H. #1105
Stanton
Stanton Bed
Five Foot
Cooper
Bennett
Duncan Bed
Top Ross
Bottom Ross
Top Red Ash
Bott. Red Ash
60°
50°
40°
511.0
449.0
420.6
408.9
381.6
495.9
457.3
536.7
551.1
562.0
578.5
618.3
499.3
564.4
604.5
500.0
420.0
394.8
447.0
365.0
362.0
339.0
298.6
262.3
260.0
270.0
320.0
300.0
266.0
224.0
190.0
146.0
250.0
199.0
179.0
153.0
155.0
135.0
35.0
64.0
-57.0
-37.0
-100.0
-108.0
-17.0
-95.0
-137.0
-211.0
70.0
66.0
7.0
D.H. 106
D.H. 1072

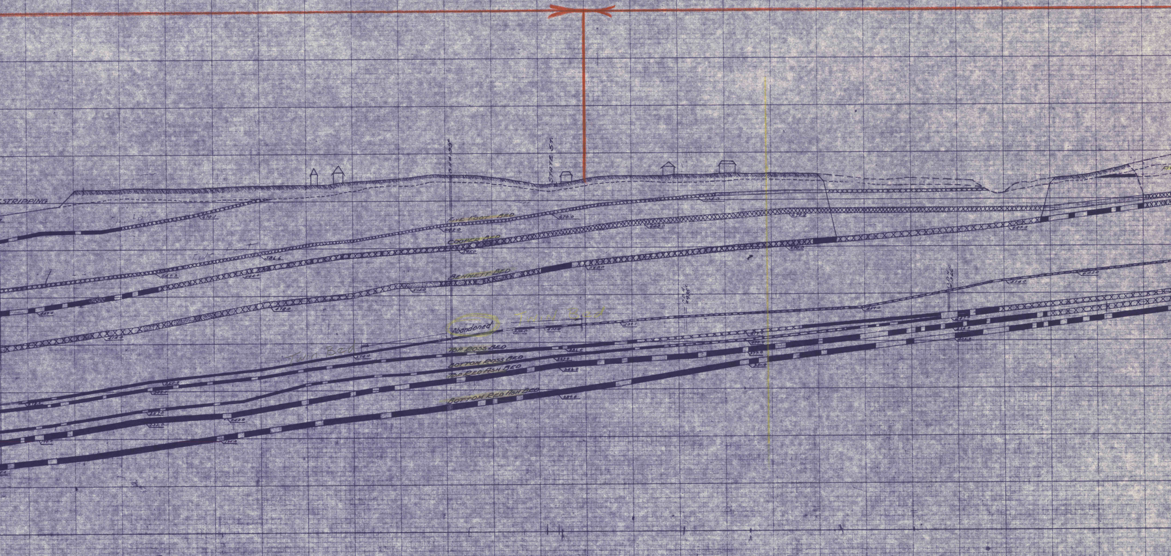
STRIPPING
STATE ST.
FIVE FOOT BED
COOPER BED
BENNETT BED
Abandoned
Twin Bed
Twin Bed
TOP ROSS BED
BOTTOM ROSS BED
TOP RED ASH BED
BOTTOM RED ASH BED
670.1
586.6
549.3
544.0
469.0
478.0
414.0
512.0
595.0
642.0
670.0
376.0
320.0
282.0
257.0
232.0
242.0
195.0
386.0
362.0
346.0
289.0

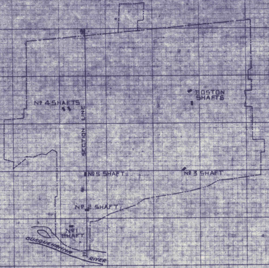
Nº 4 SHAFTS
BOSTON SHAFTS
SECTION LINE
Nº 5 SHAFT
Nº 3 SHAFT
Nº 2 SHAFT
Nº 1 SHAFT
SUSQUEHANNA RIVER

X-SECTION 11-12

THE HUDSON COAL CO.
LOREE COLLIERY
CROSS SECTION
THRU COAL MEASURES

SCALE 1 INCH - 100 FT

MINING ENGINEER'S OFFICE ——— SEPTEMBER 1928

POSTED	
9-25-45	K.M.
3-1-47	K.M.

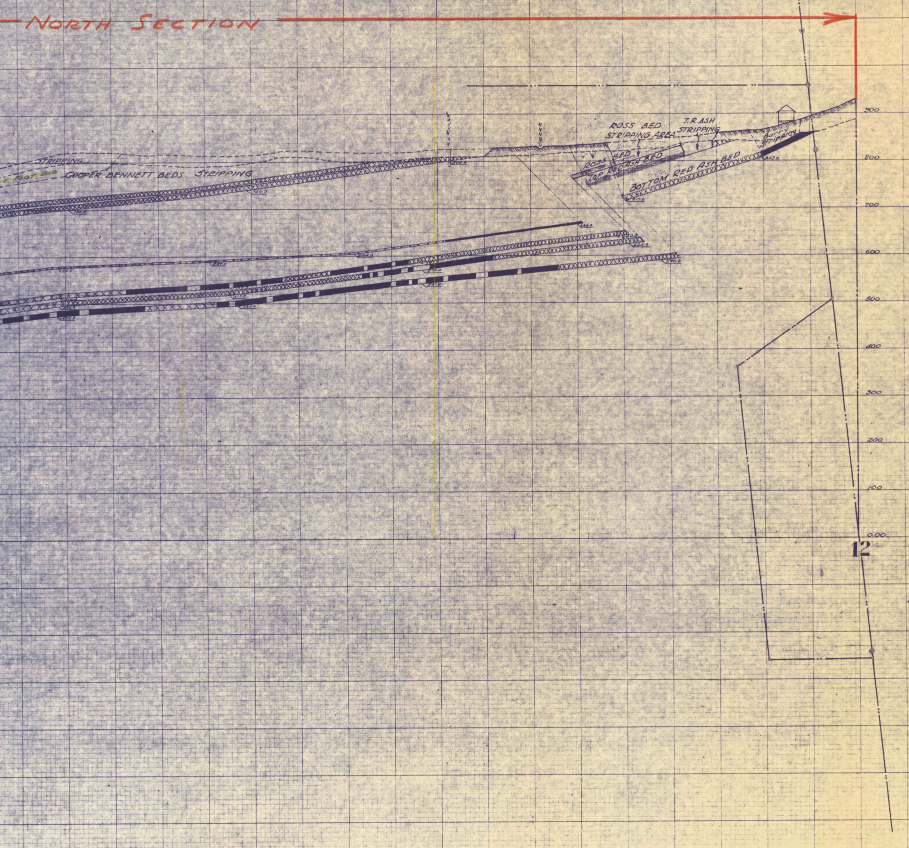
NORTH SECTION
STRIPPING
…E FOOT BED
COOPER-BENNETT BEDS STRIPPING
3.4 FT/0.3 FT
800.0
CREEK
ROSS BED
STRIPPING AREA
T.R. ASH
STRIPPING
Barry
Stripping
ROSS BED
TOP RED ASH BED
BOTTOM RED ASH BED
807.0
717.0
750.0
700.0
666.0
640.0
625.0
590.0
604.0
589.0
575.0
587.0
570.0
541.0
517.0
495.0
475.0
900
800
700
600
500
400
300
200
100
0.00
12