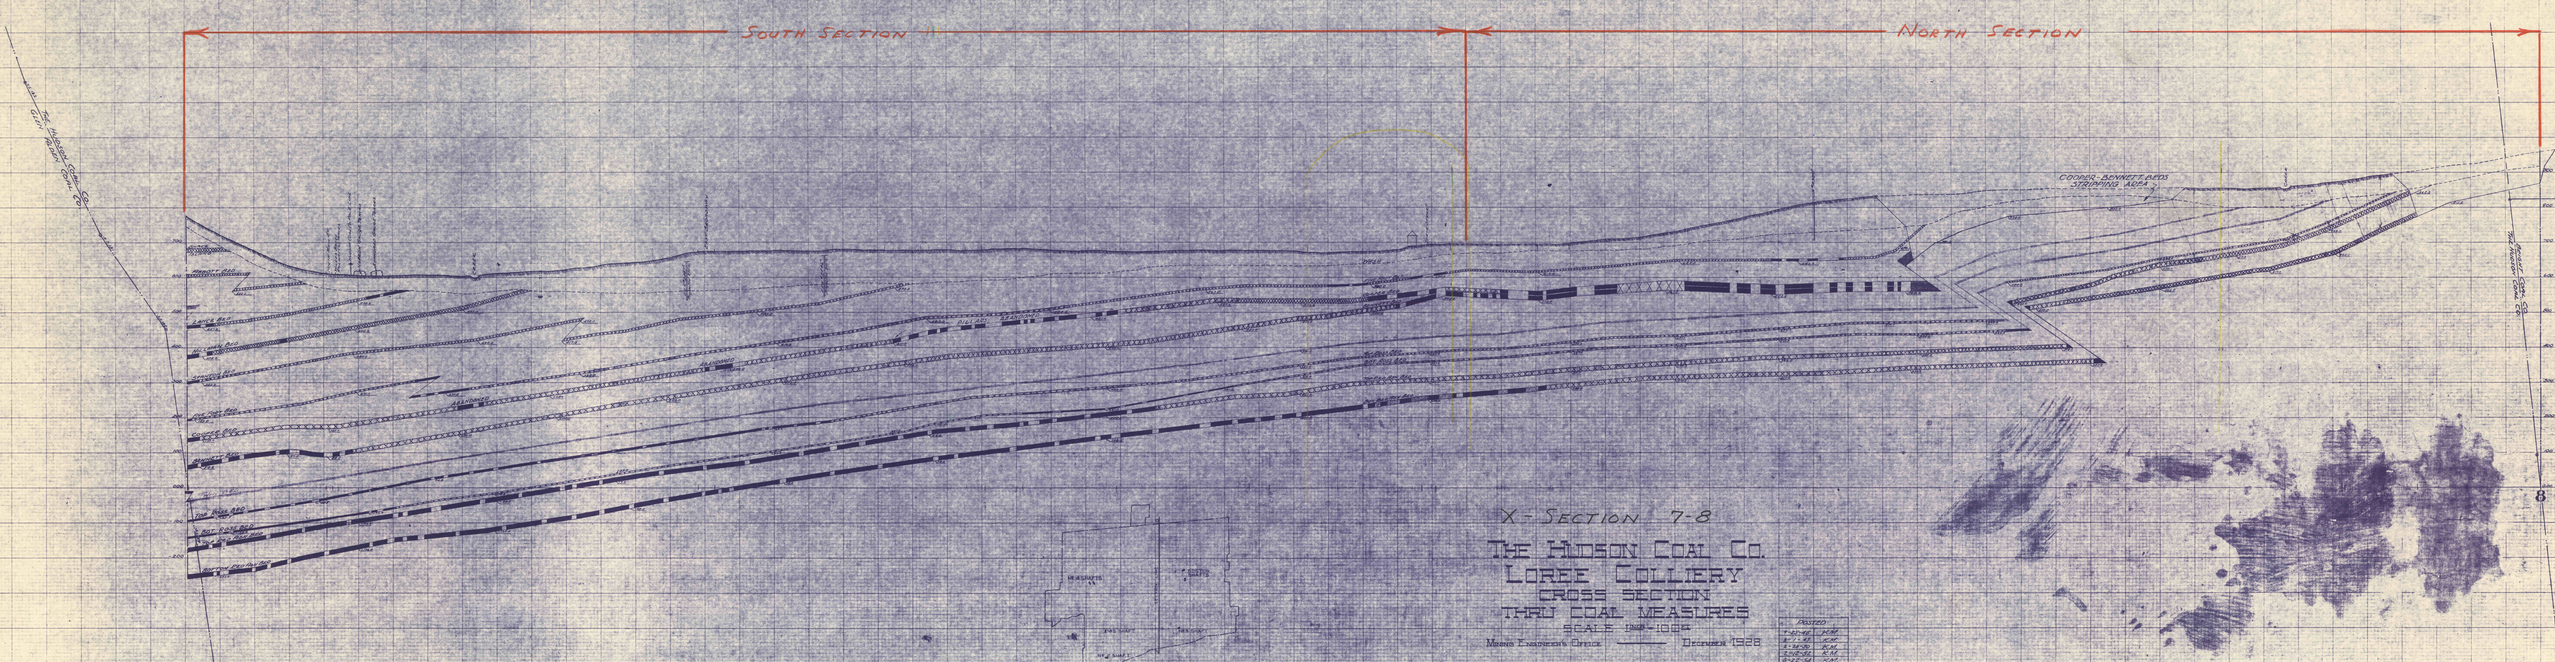
South Section
North Section
Cooper-Bennett Beds Stripping Area
X - Section 7-8
The Hudson Coal Co.
Loree Colliery
Cross Section
Thru Coal Measures
Scale 1"=100'
Mining Engineer's Office
December 1928
Posted
7-12-46 K.M.
8-1-48 K.M.
8-24-50 K.M.
2-12-52 K.M.
8-26-54 K.M.
12-21-57 K.M.
7-22-58 K.M.