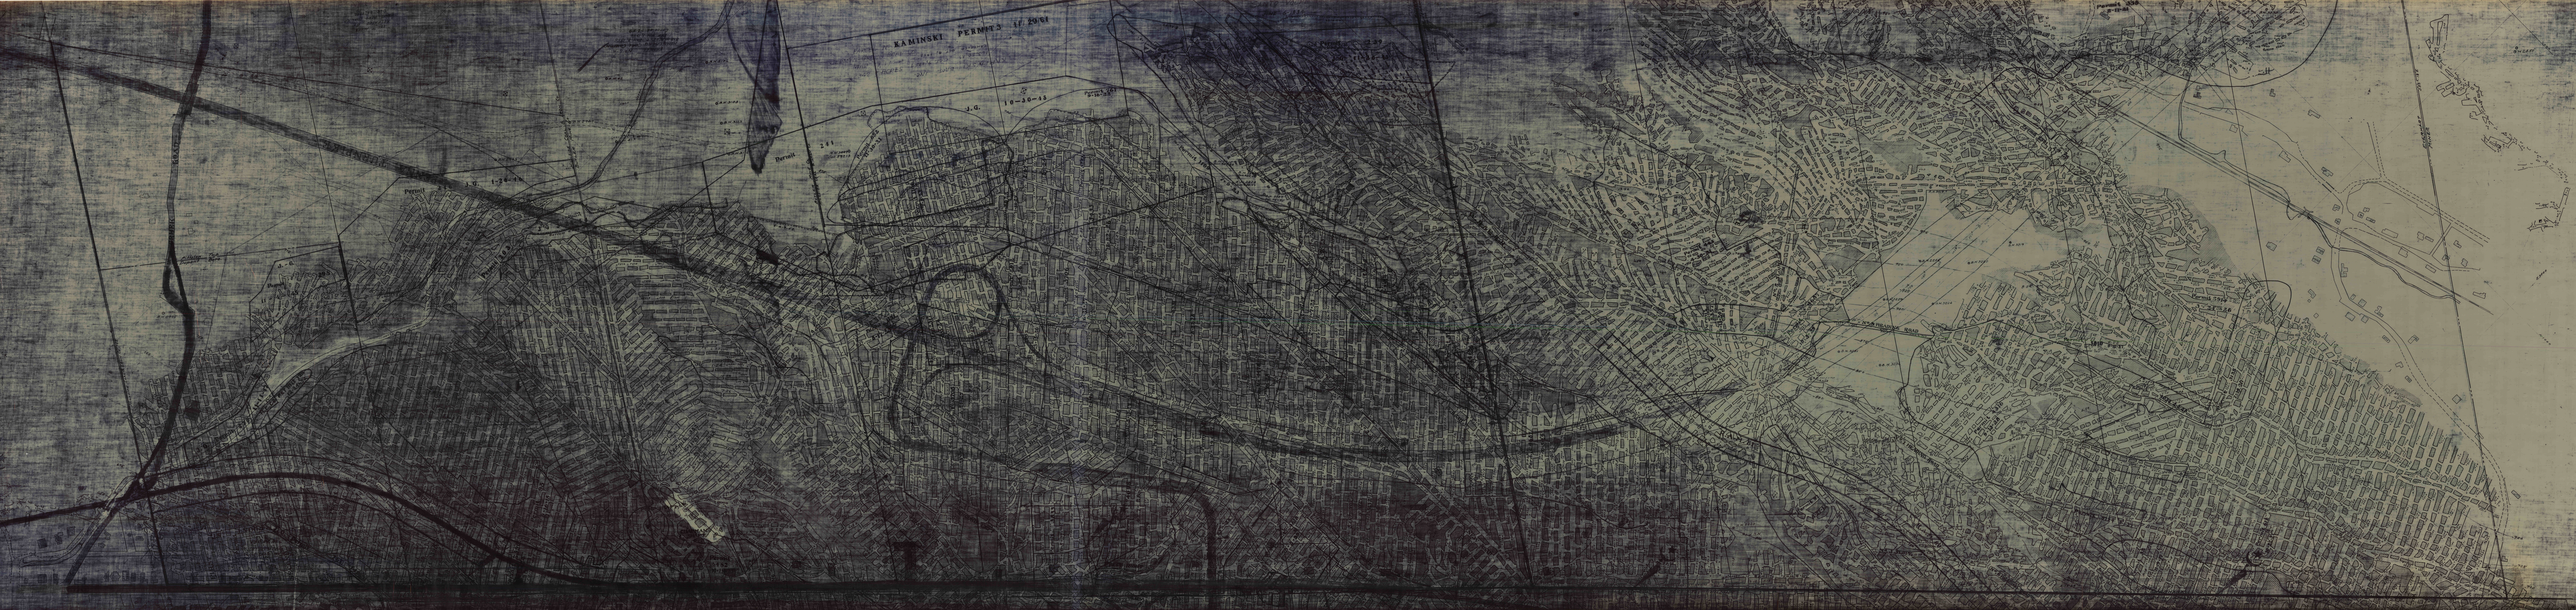
KAMINSKI
PERM-2
17 29 61
10-30-13
Perm
Perm'
Perm II
Perm I
