
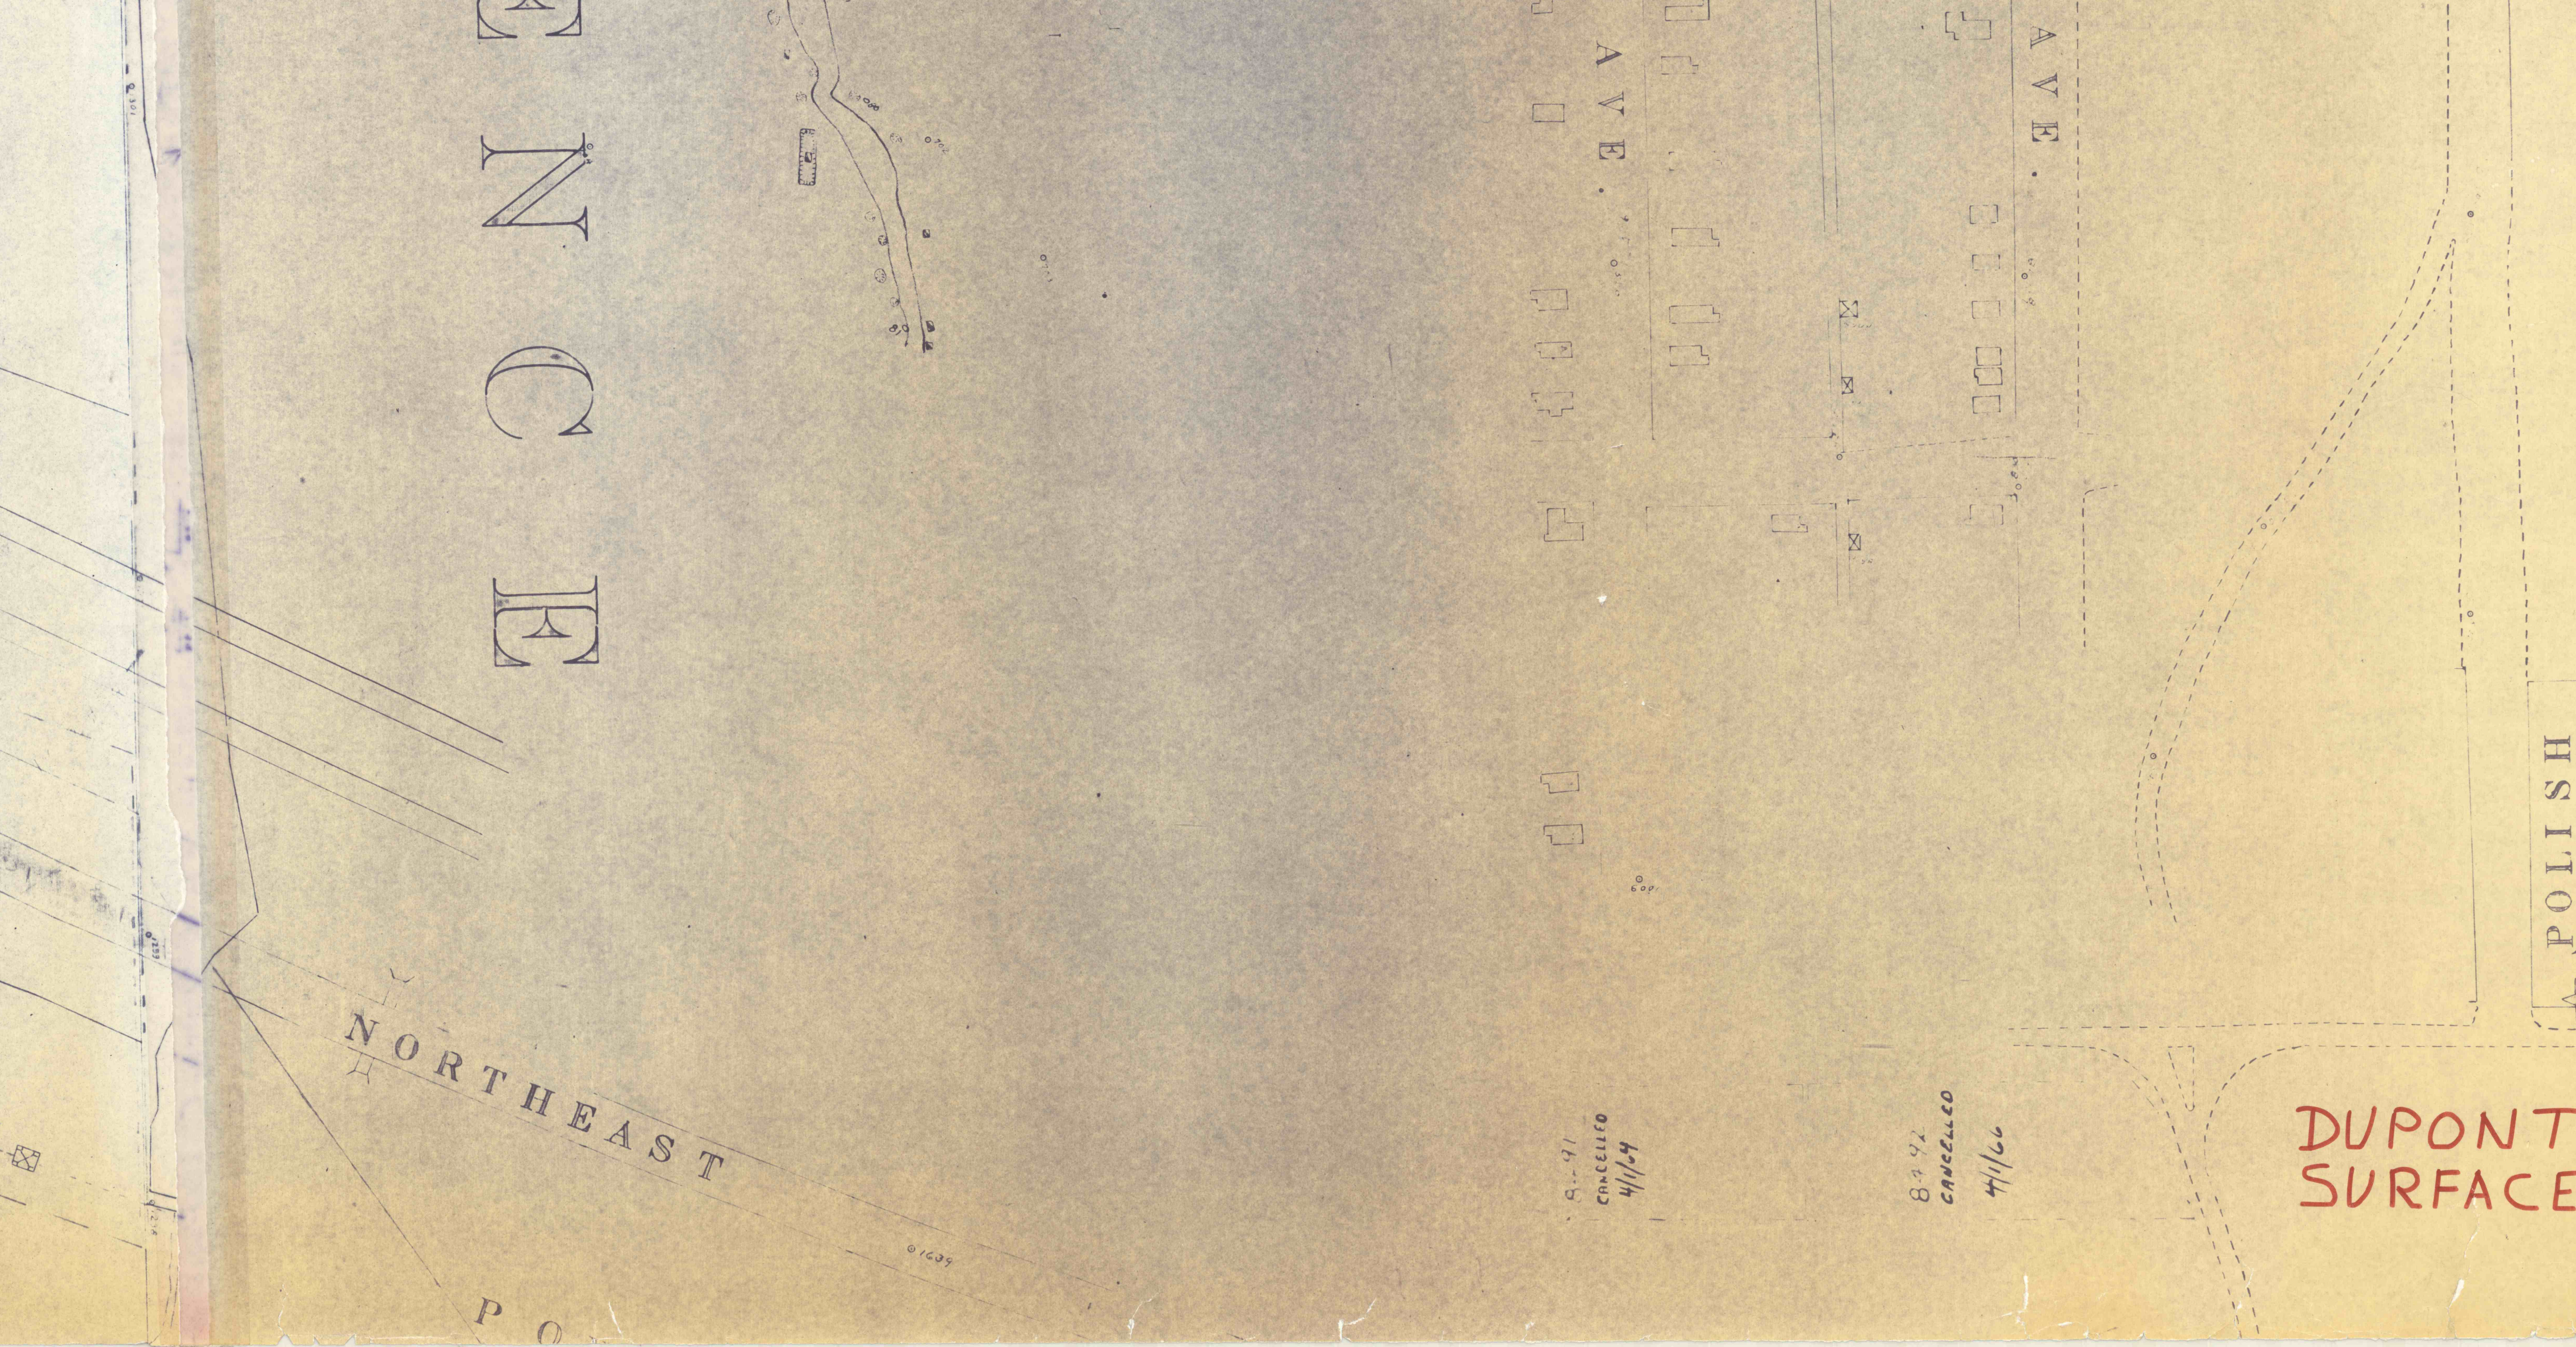
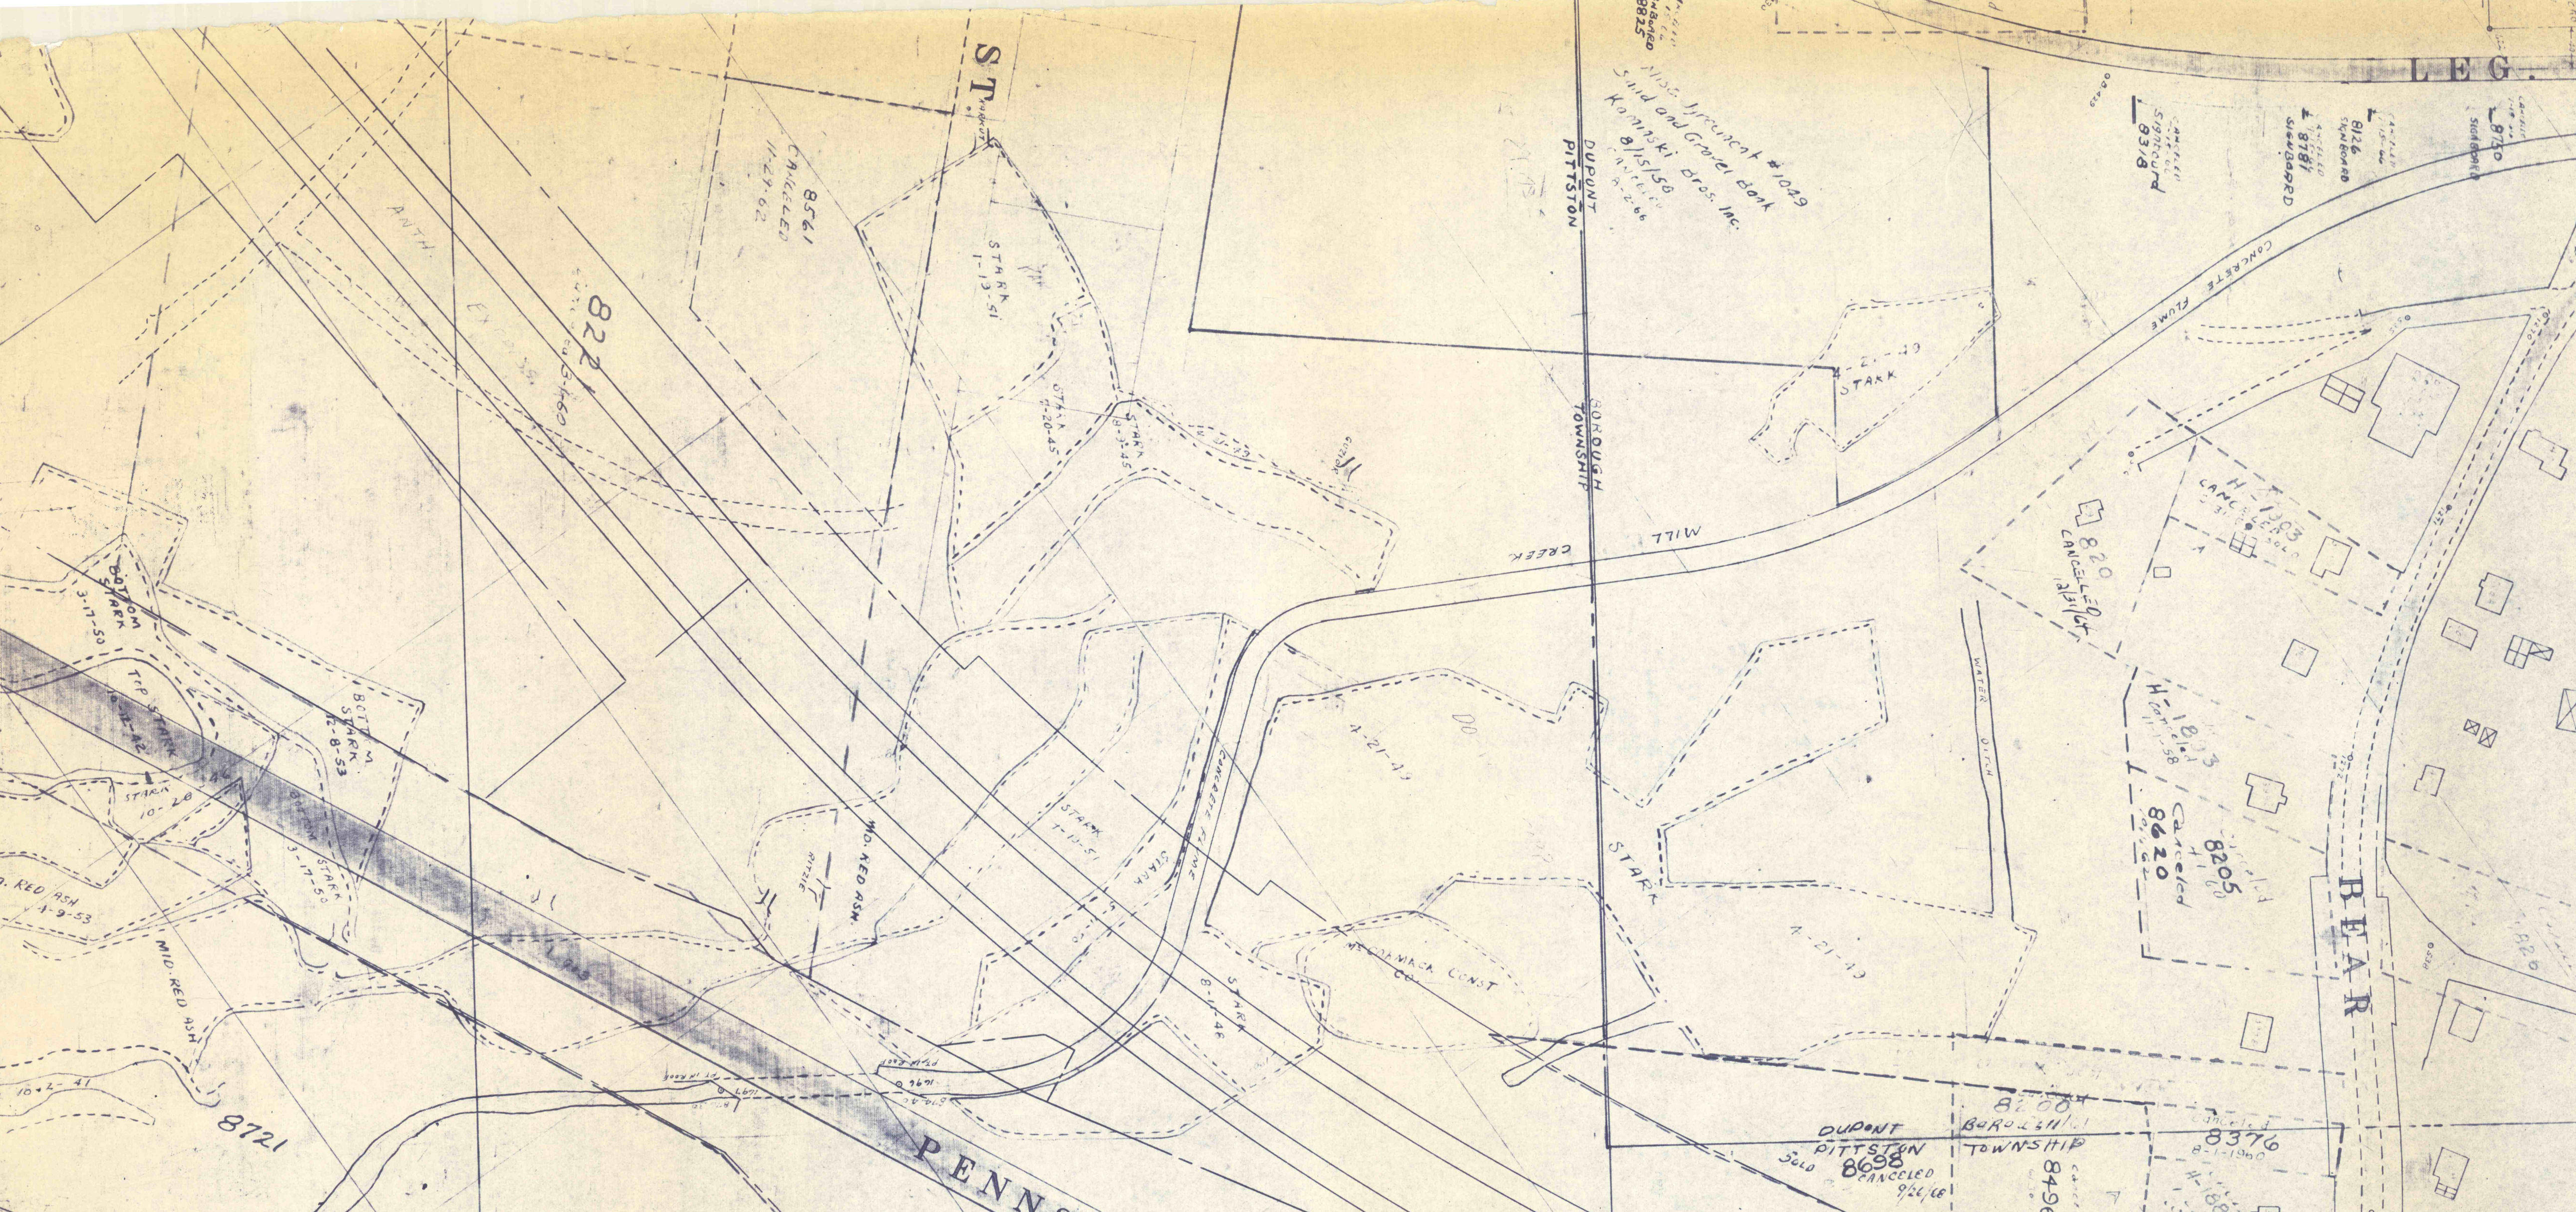


BUTLER

FLORENCE

DUPONT SURFACE

 

POLISH CEMETERY

CHURCH

CHESTNUT ST

WALNUT ST

WYOMING AVE

SPRUCE ST

ST

FIM

ST

LEG. ROUTE 515

PARALLEL

COLLINS CREEK

BEAR CREEK

TURNPIKE

HIGH ROAD

TENSION

NORTHEAST

PENNSYLVANIA

ST

822

872

872

806

837

820

820

820

822

822

