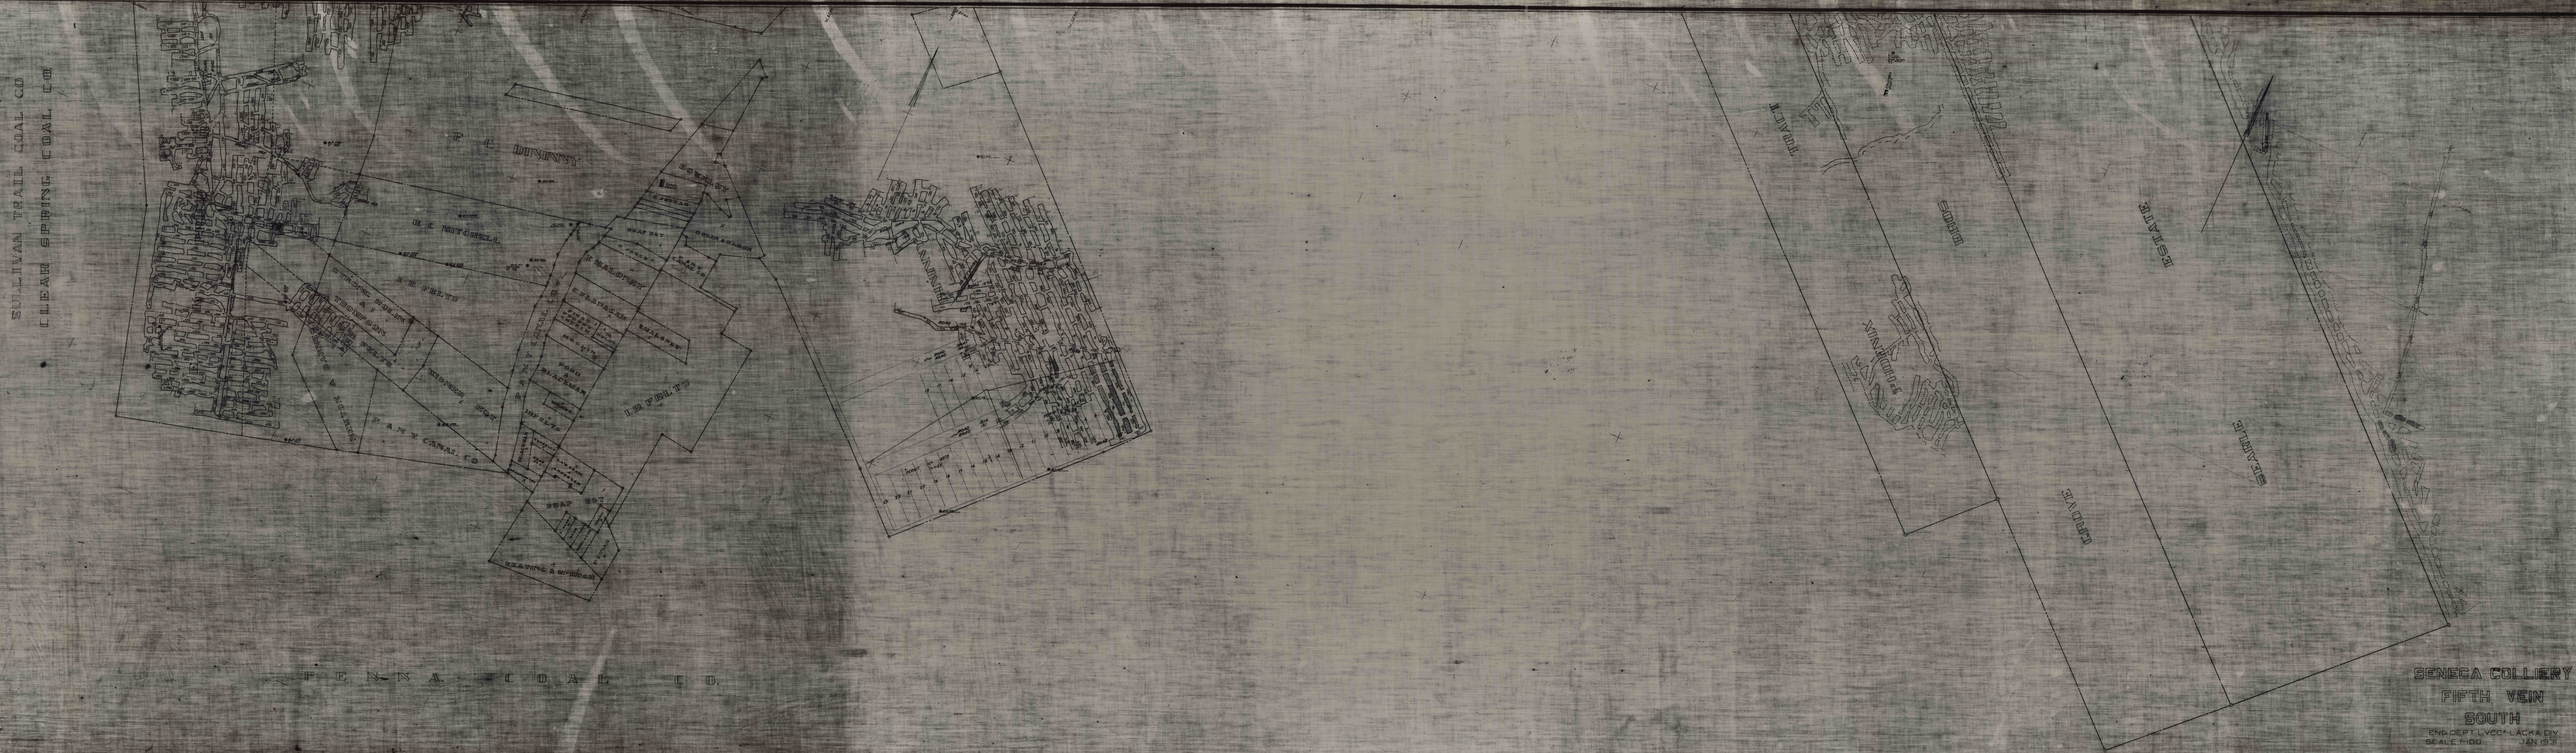

SULLIVAN TRAIL COAL CO
CLEAR SPRING COAL CO
DE MITCHELL
DE WITT
