


UNDERWOOD COLLIERY
DUNMORE SHAFT
ROCK VEIN
SCALE 1"=100'

UNDERWOOD COLLIERY
DUNMORE SHAFT
ROCK VEIN
SCALE 1"=100'

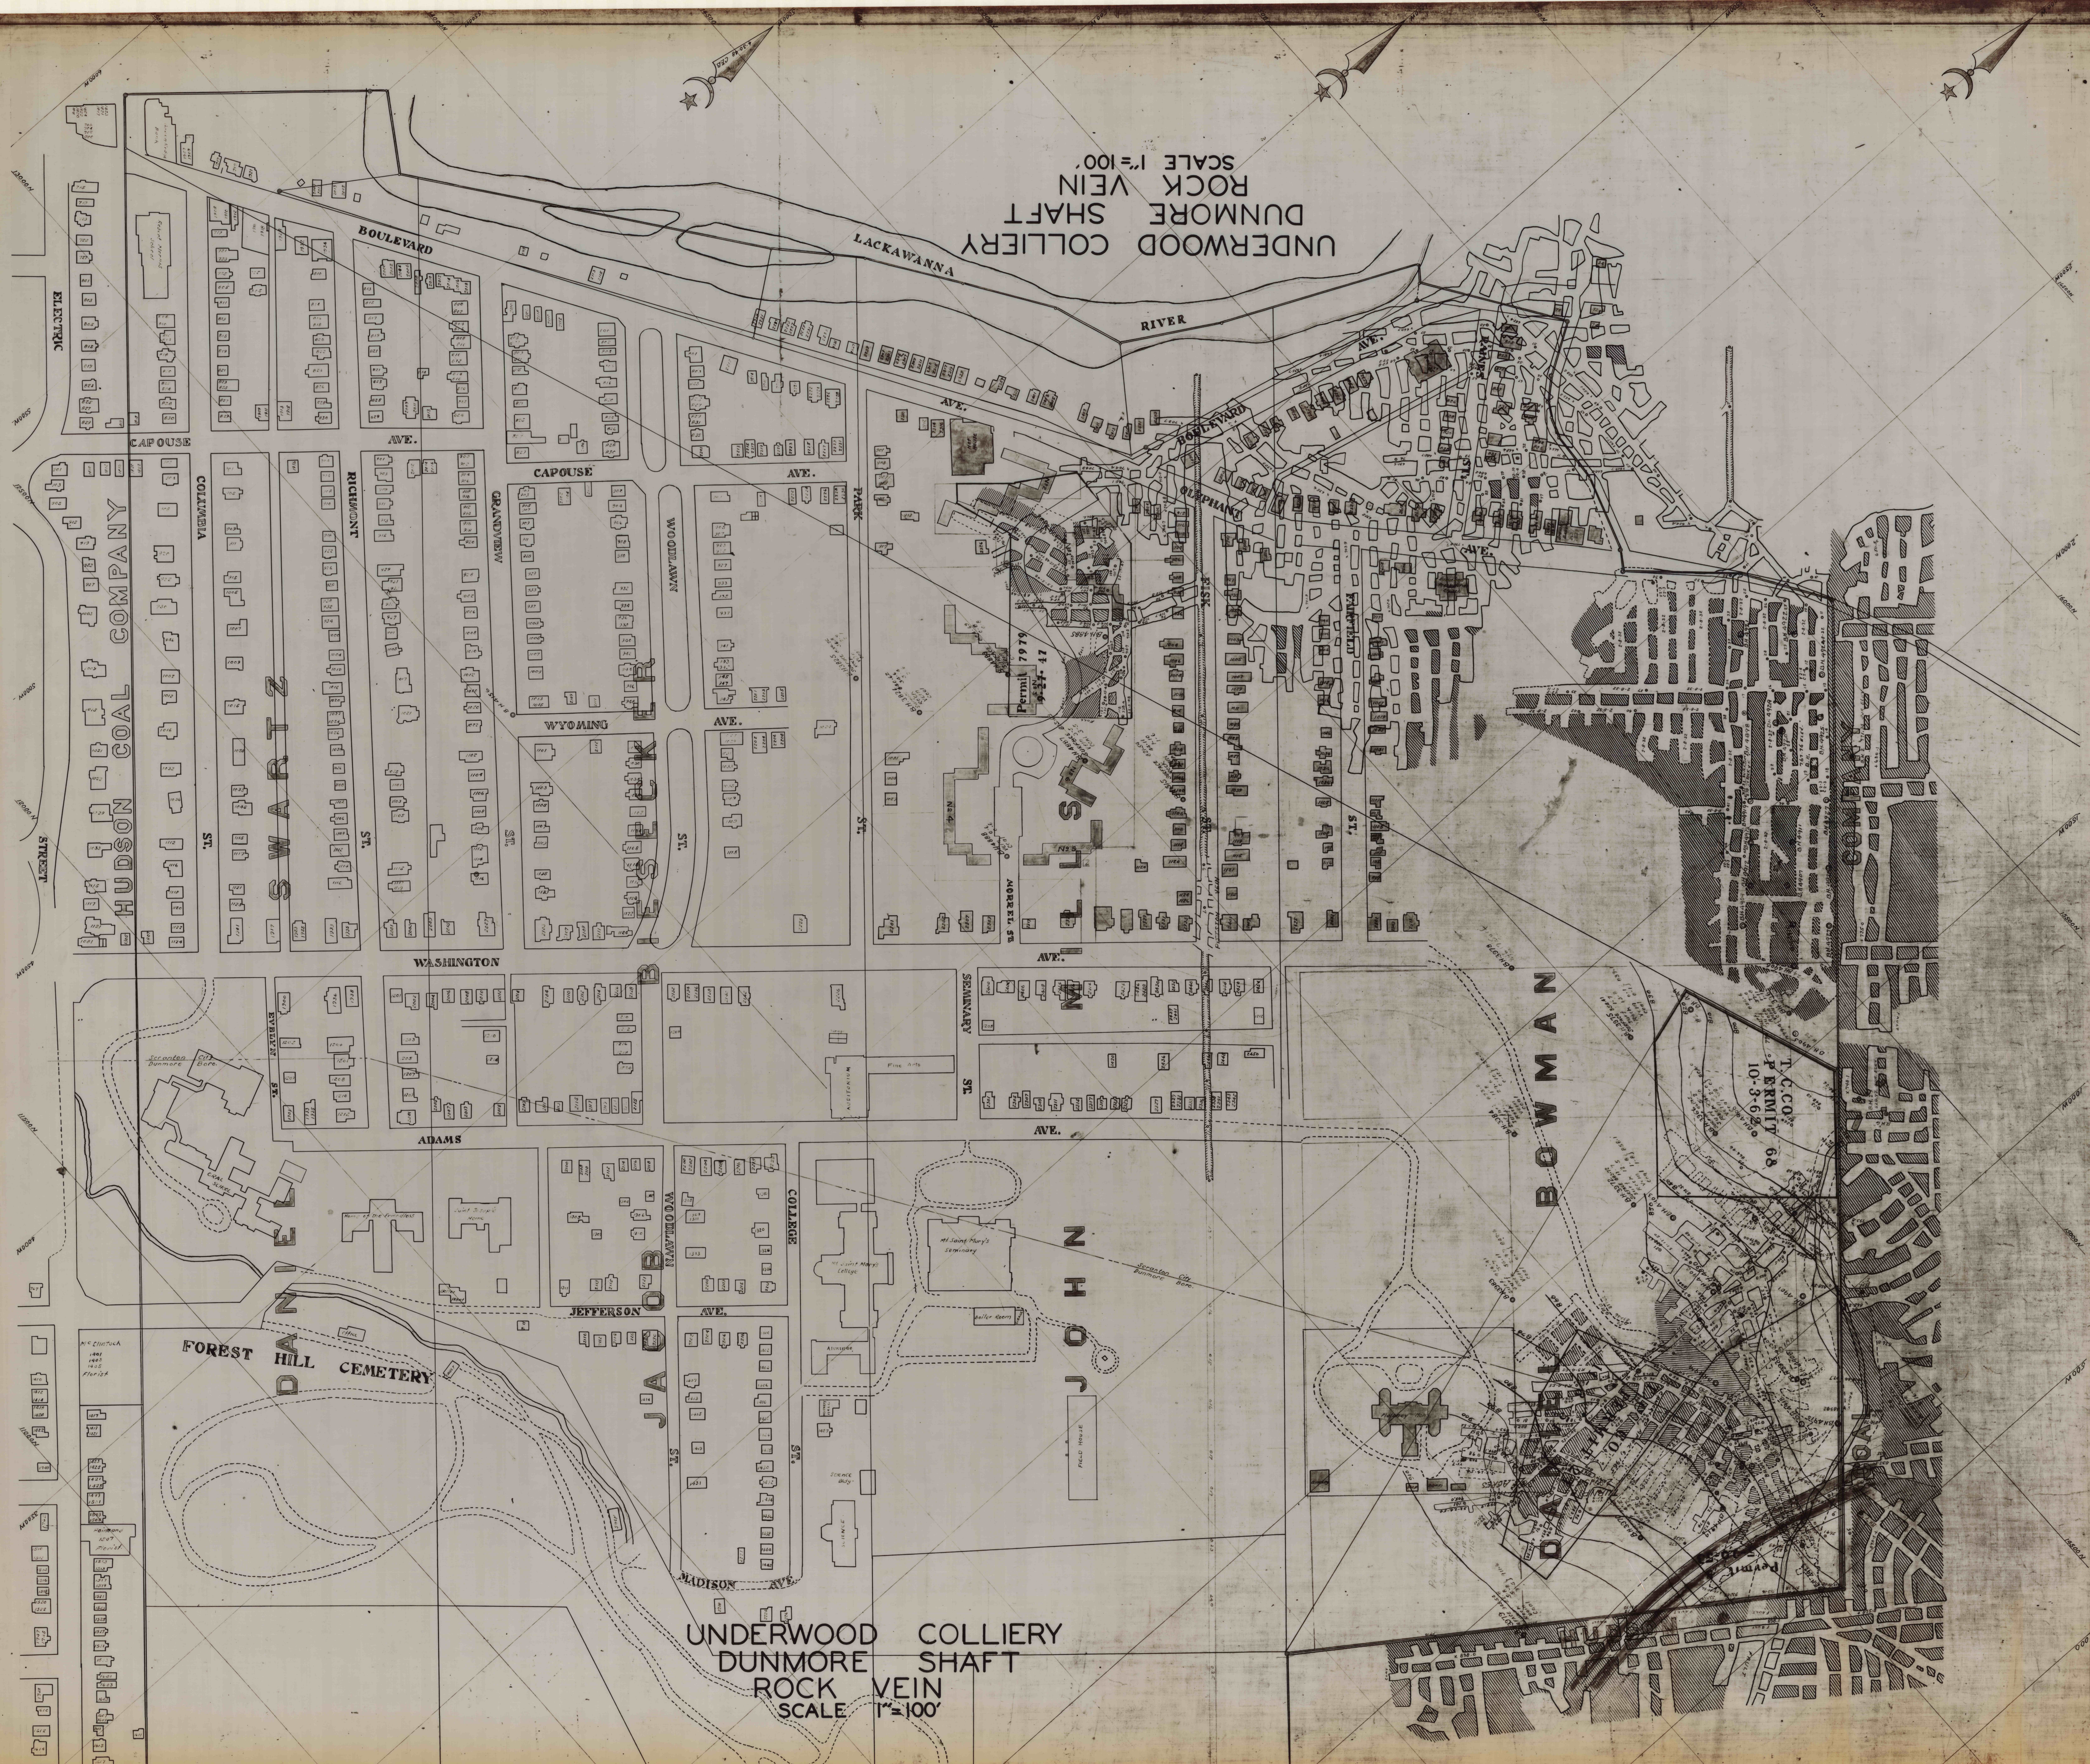

ELECTRIC

CAPOUSE

HUDSON COAL COMPANY

WASHINGTON

ADAMS

FOREST HILL CEMETERY

JEFFERSON

MADISON

BOULEVARD

CAPOUSE

VIEWMONT

RICHMOND

WASHINGTON

ADAMS

JEFFERSON

MADISON



































































































BOWMAN



T.C. CO.
PERMIT 68
10-3-62




