
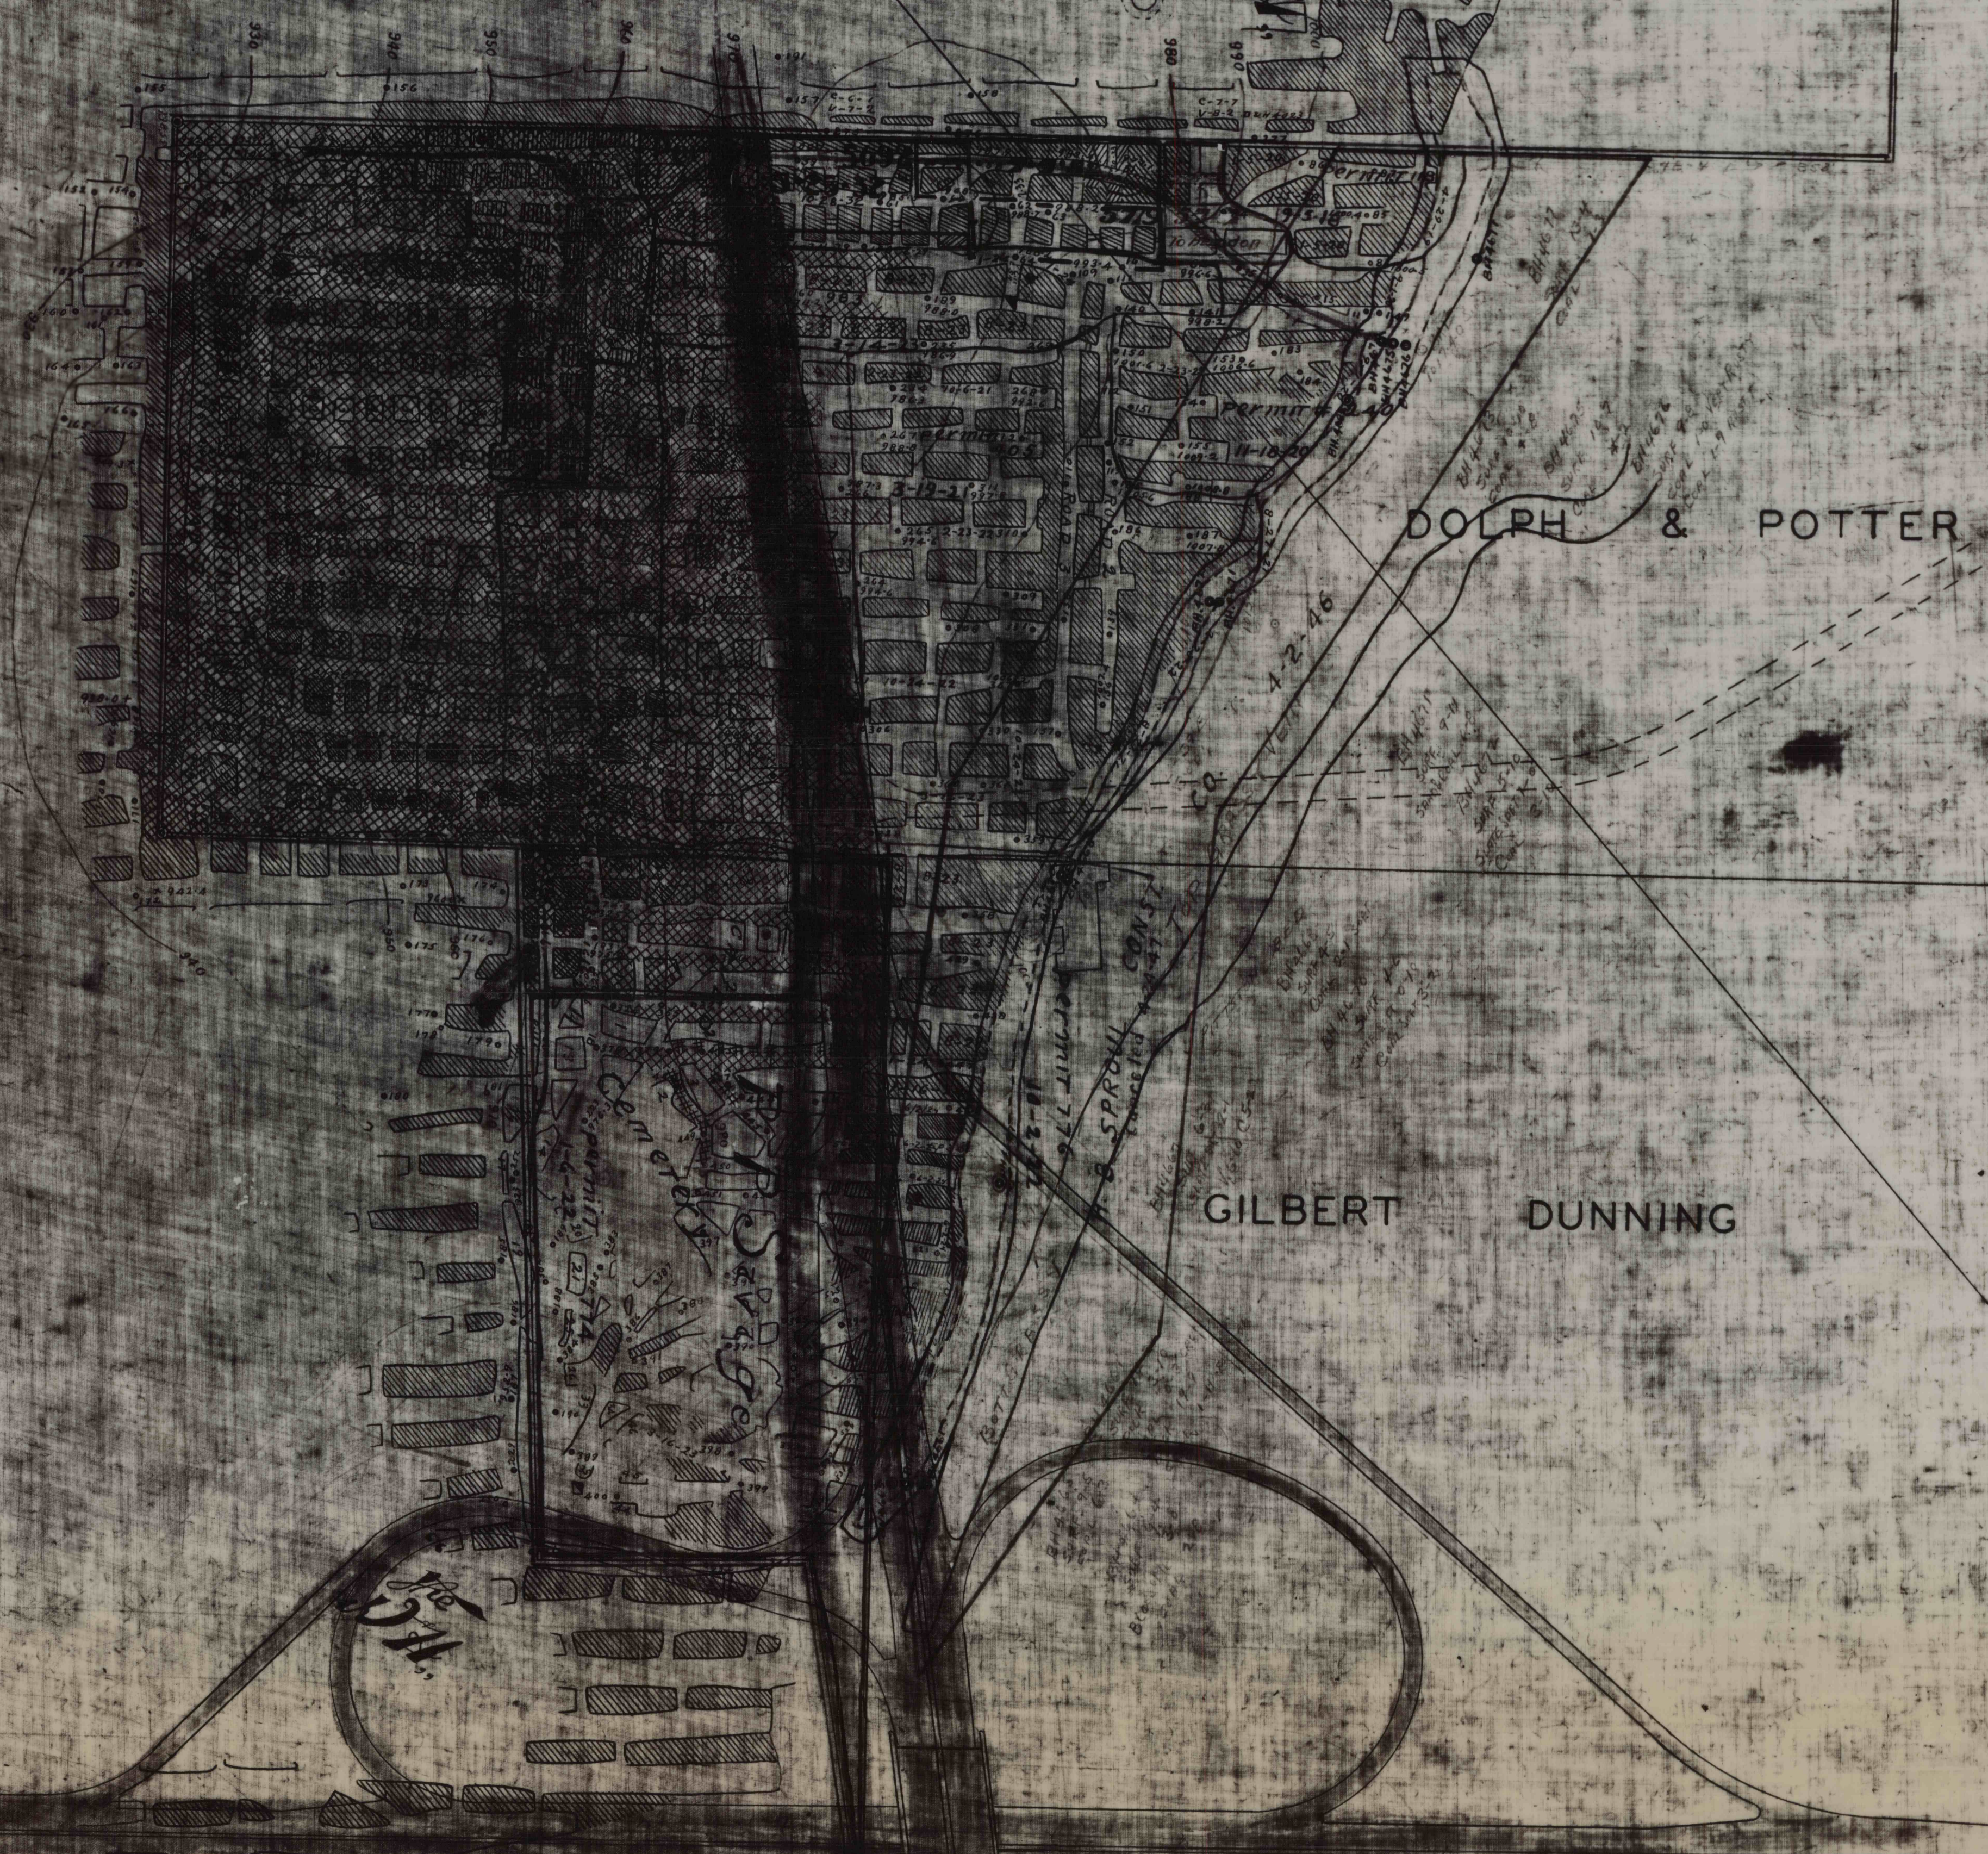
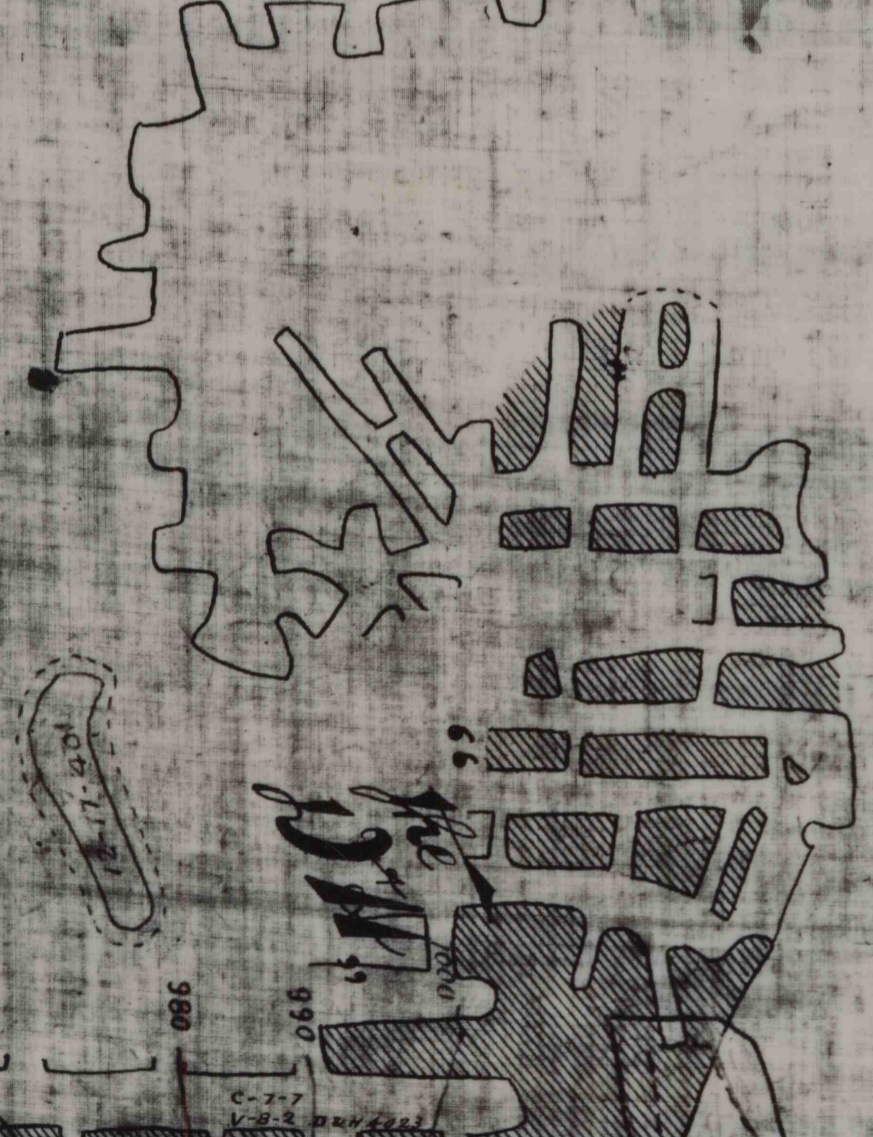
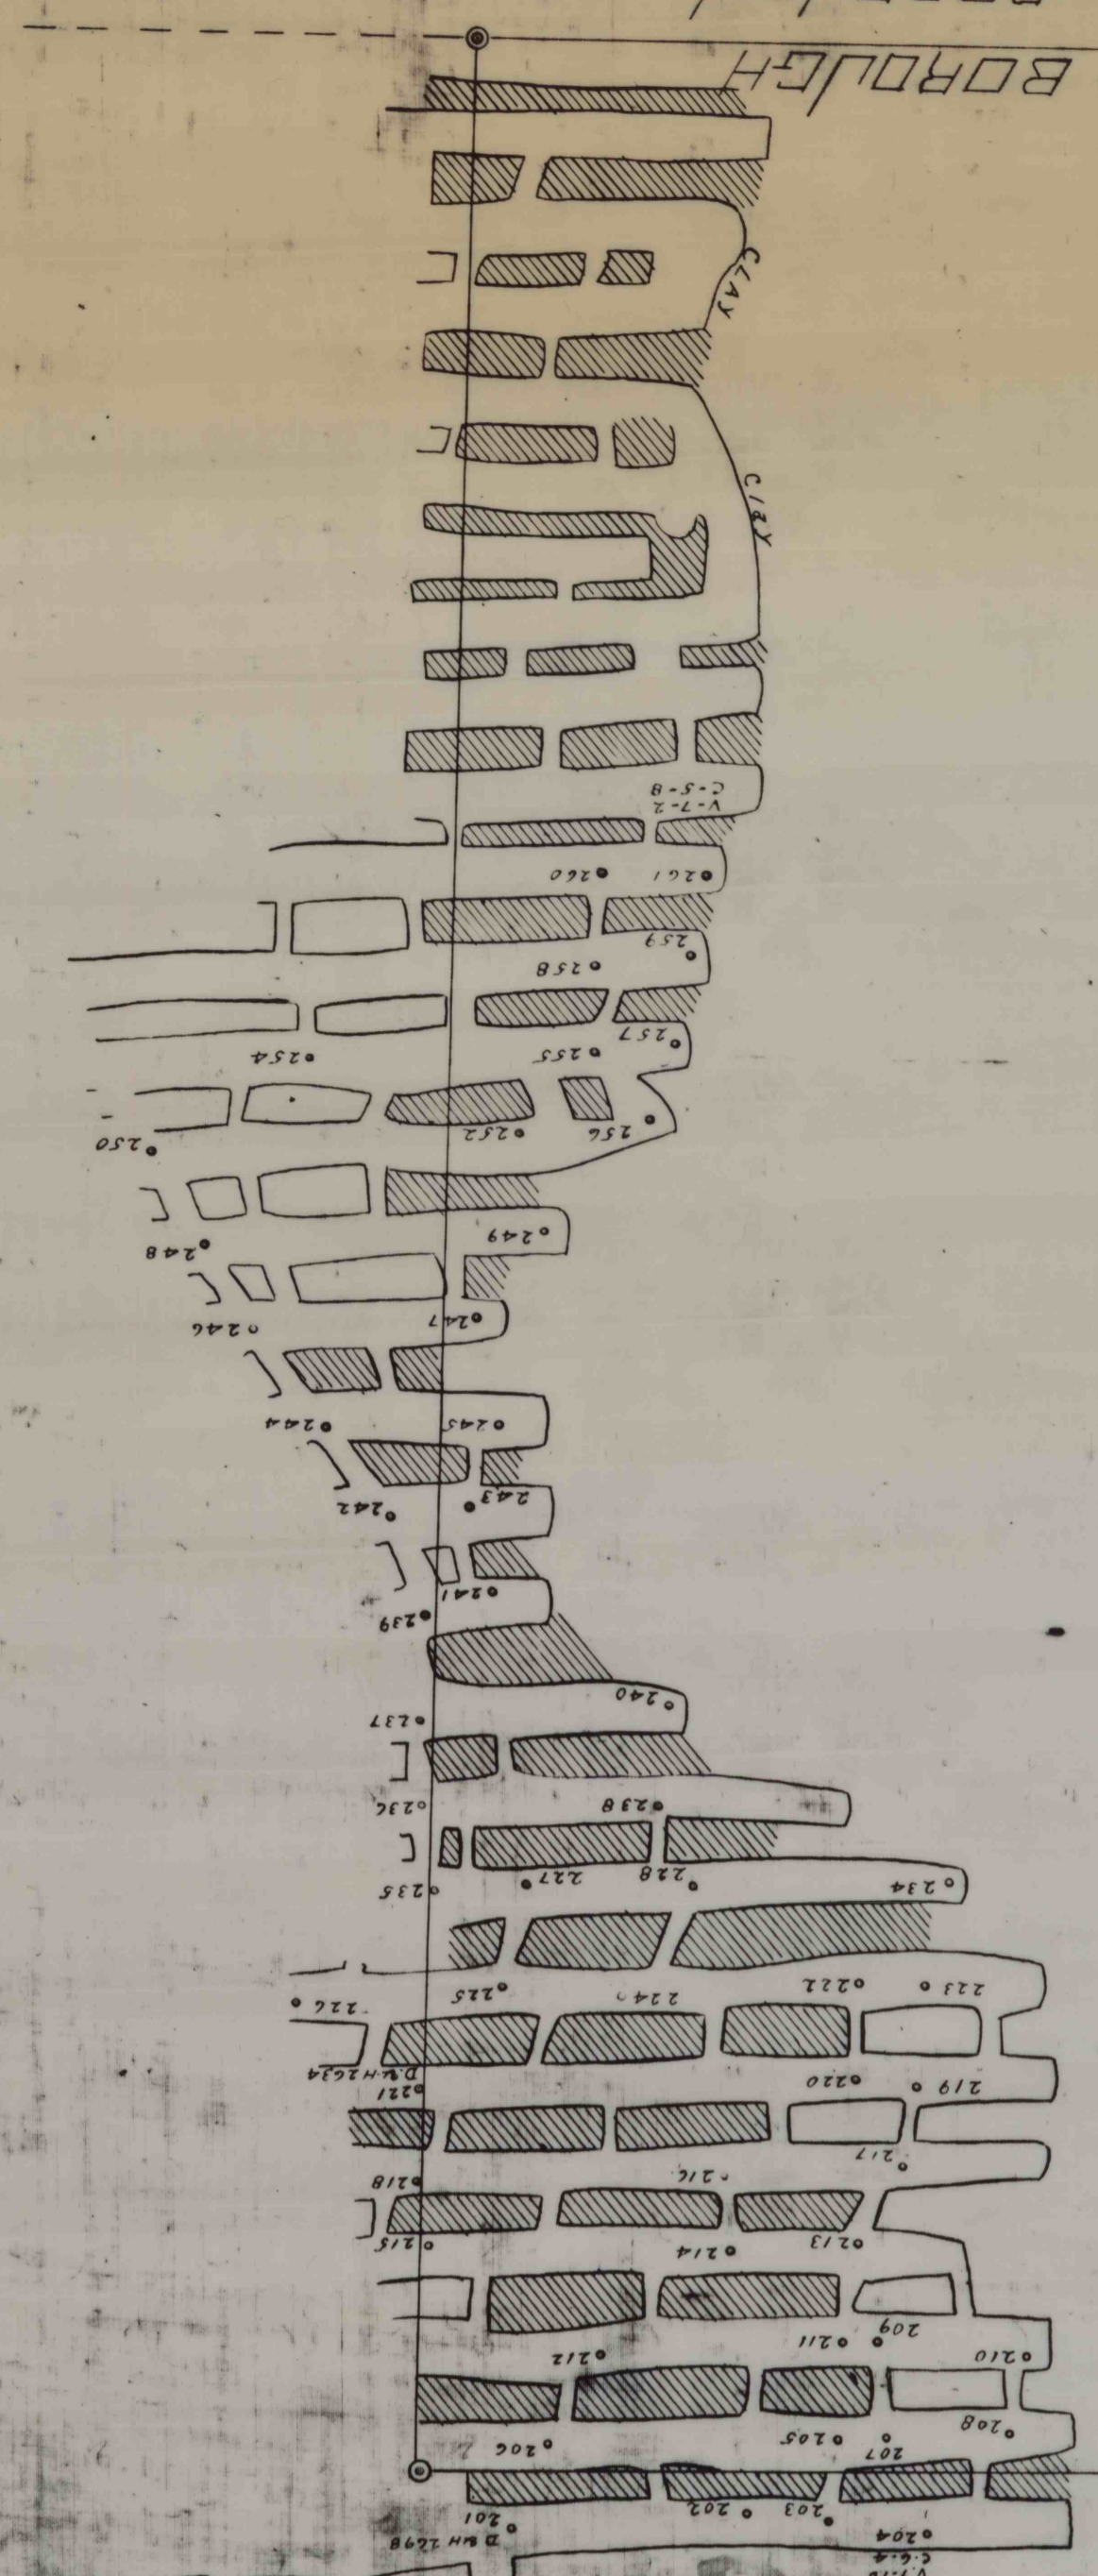


DUNMORE BOROUGH
THROOP BOROUGH

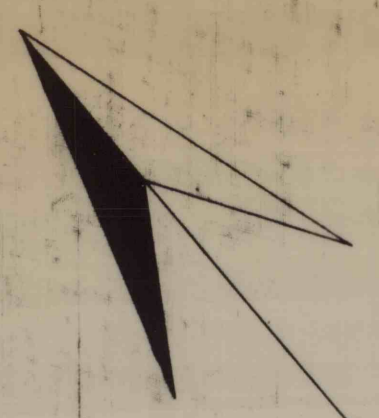

DOLPH & POTTER

GILBERT DUNNING

1827