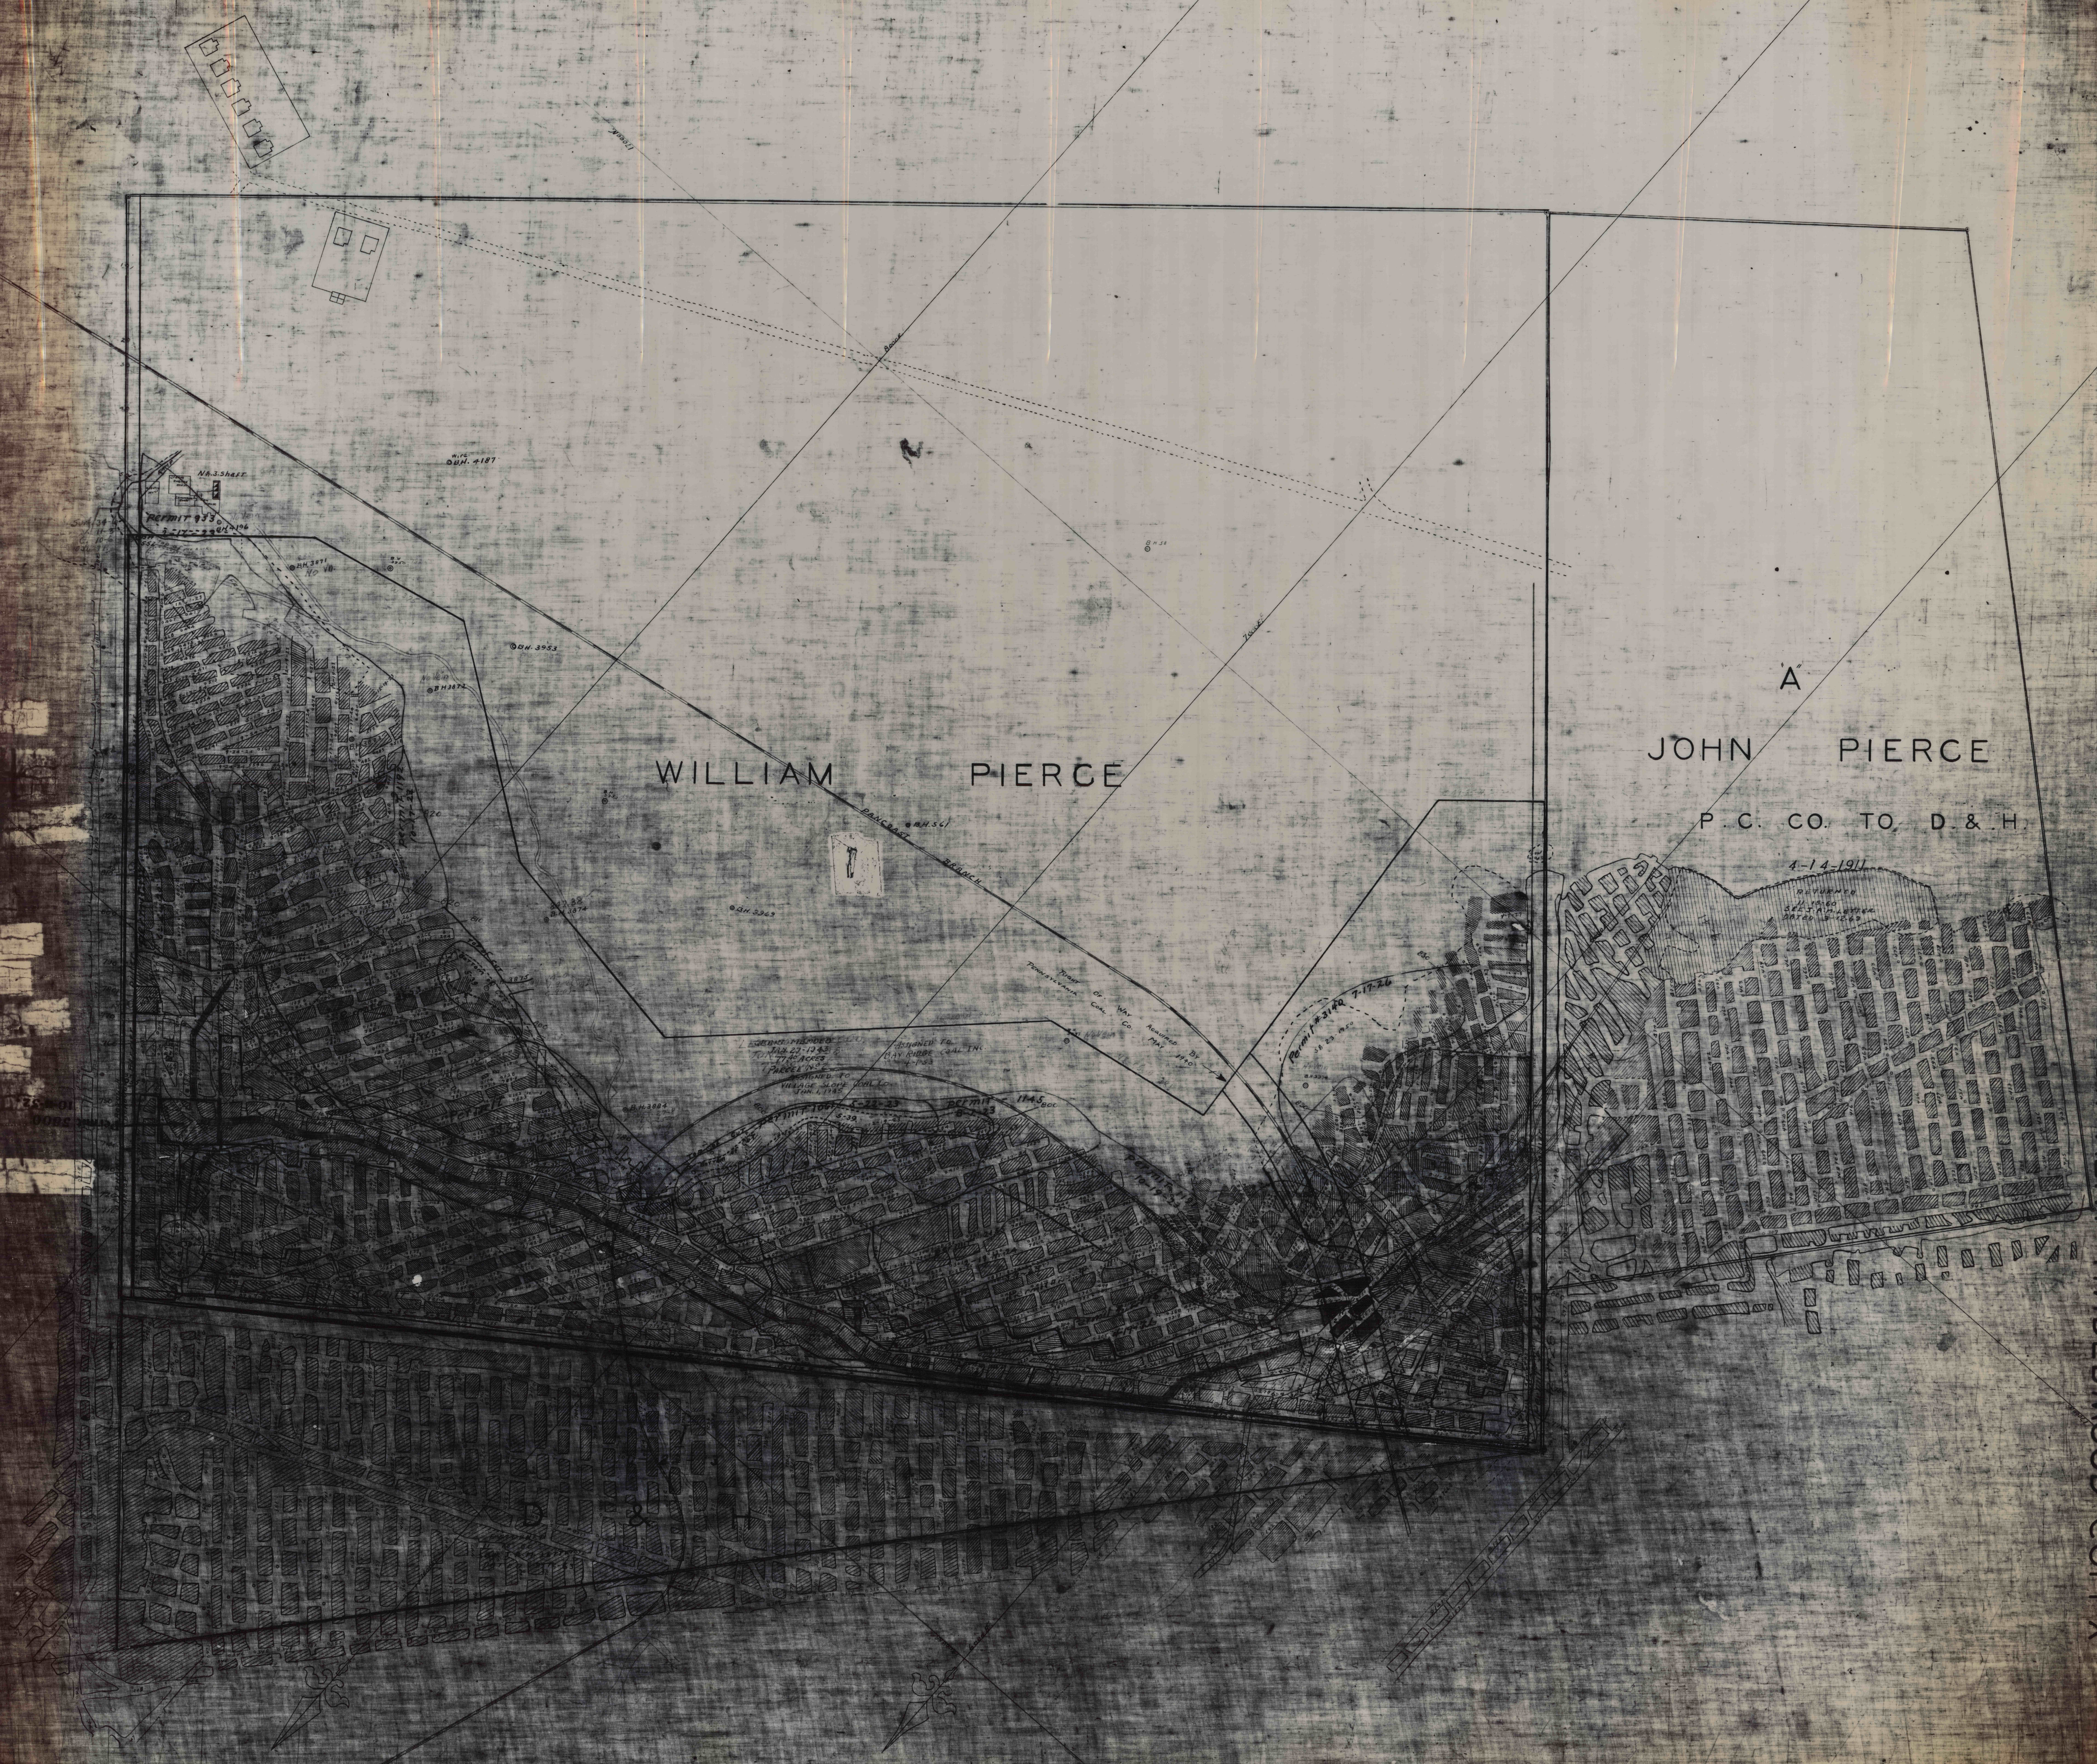
WILLIAM PIERCE
"A"
JOHN PIERCE
P. C. CO. TO D. & H.
4-14-1911
RETURNED
11-15-60
SEE J. A. M. LETTER
DATED 3-12-63
D & H
No. 3 Shaft
Steam Engine House
Compressor Room
Fan House
Permit 953
2-17-23
B.H. 4196
B.H. 4187
B.H. 3871
No Vn.
B.H. 3950
B.H. 3953
B.H. 3872
No Vein
Fault
PANCOAST BRANCH
B.H. 561
B.H. 3969
B.H. 3884
JAN. 27-1943
77.40 ACRES
PARCEL No. 2
ASSIGNED TO
VILLAGE SLOPE COAL CO.
JAN. 1, 1945
ASSIGNED TO
BAY RIDGE COAL INC.
4-1-53
Permit 1061
5-22-23
5-39
Permit - 1145
8-1-23
Top of Cut
Bottom of Cut
Permit 1191
10-19-23
RIGHT OF WAY
PENNSYLVANIA COAL CO. ACQUIRED BY
MAY 1940
Permit #3140
7-17-26
38.23.1950
No Vein
B.H. 3374
Track
Road