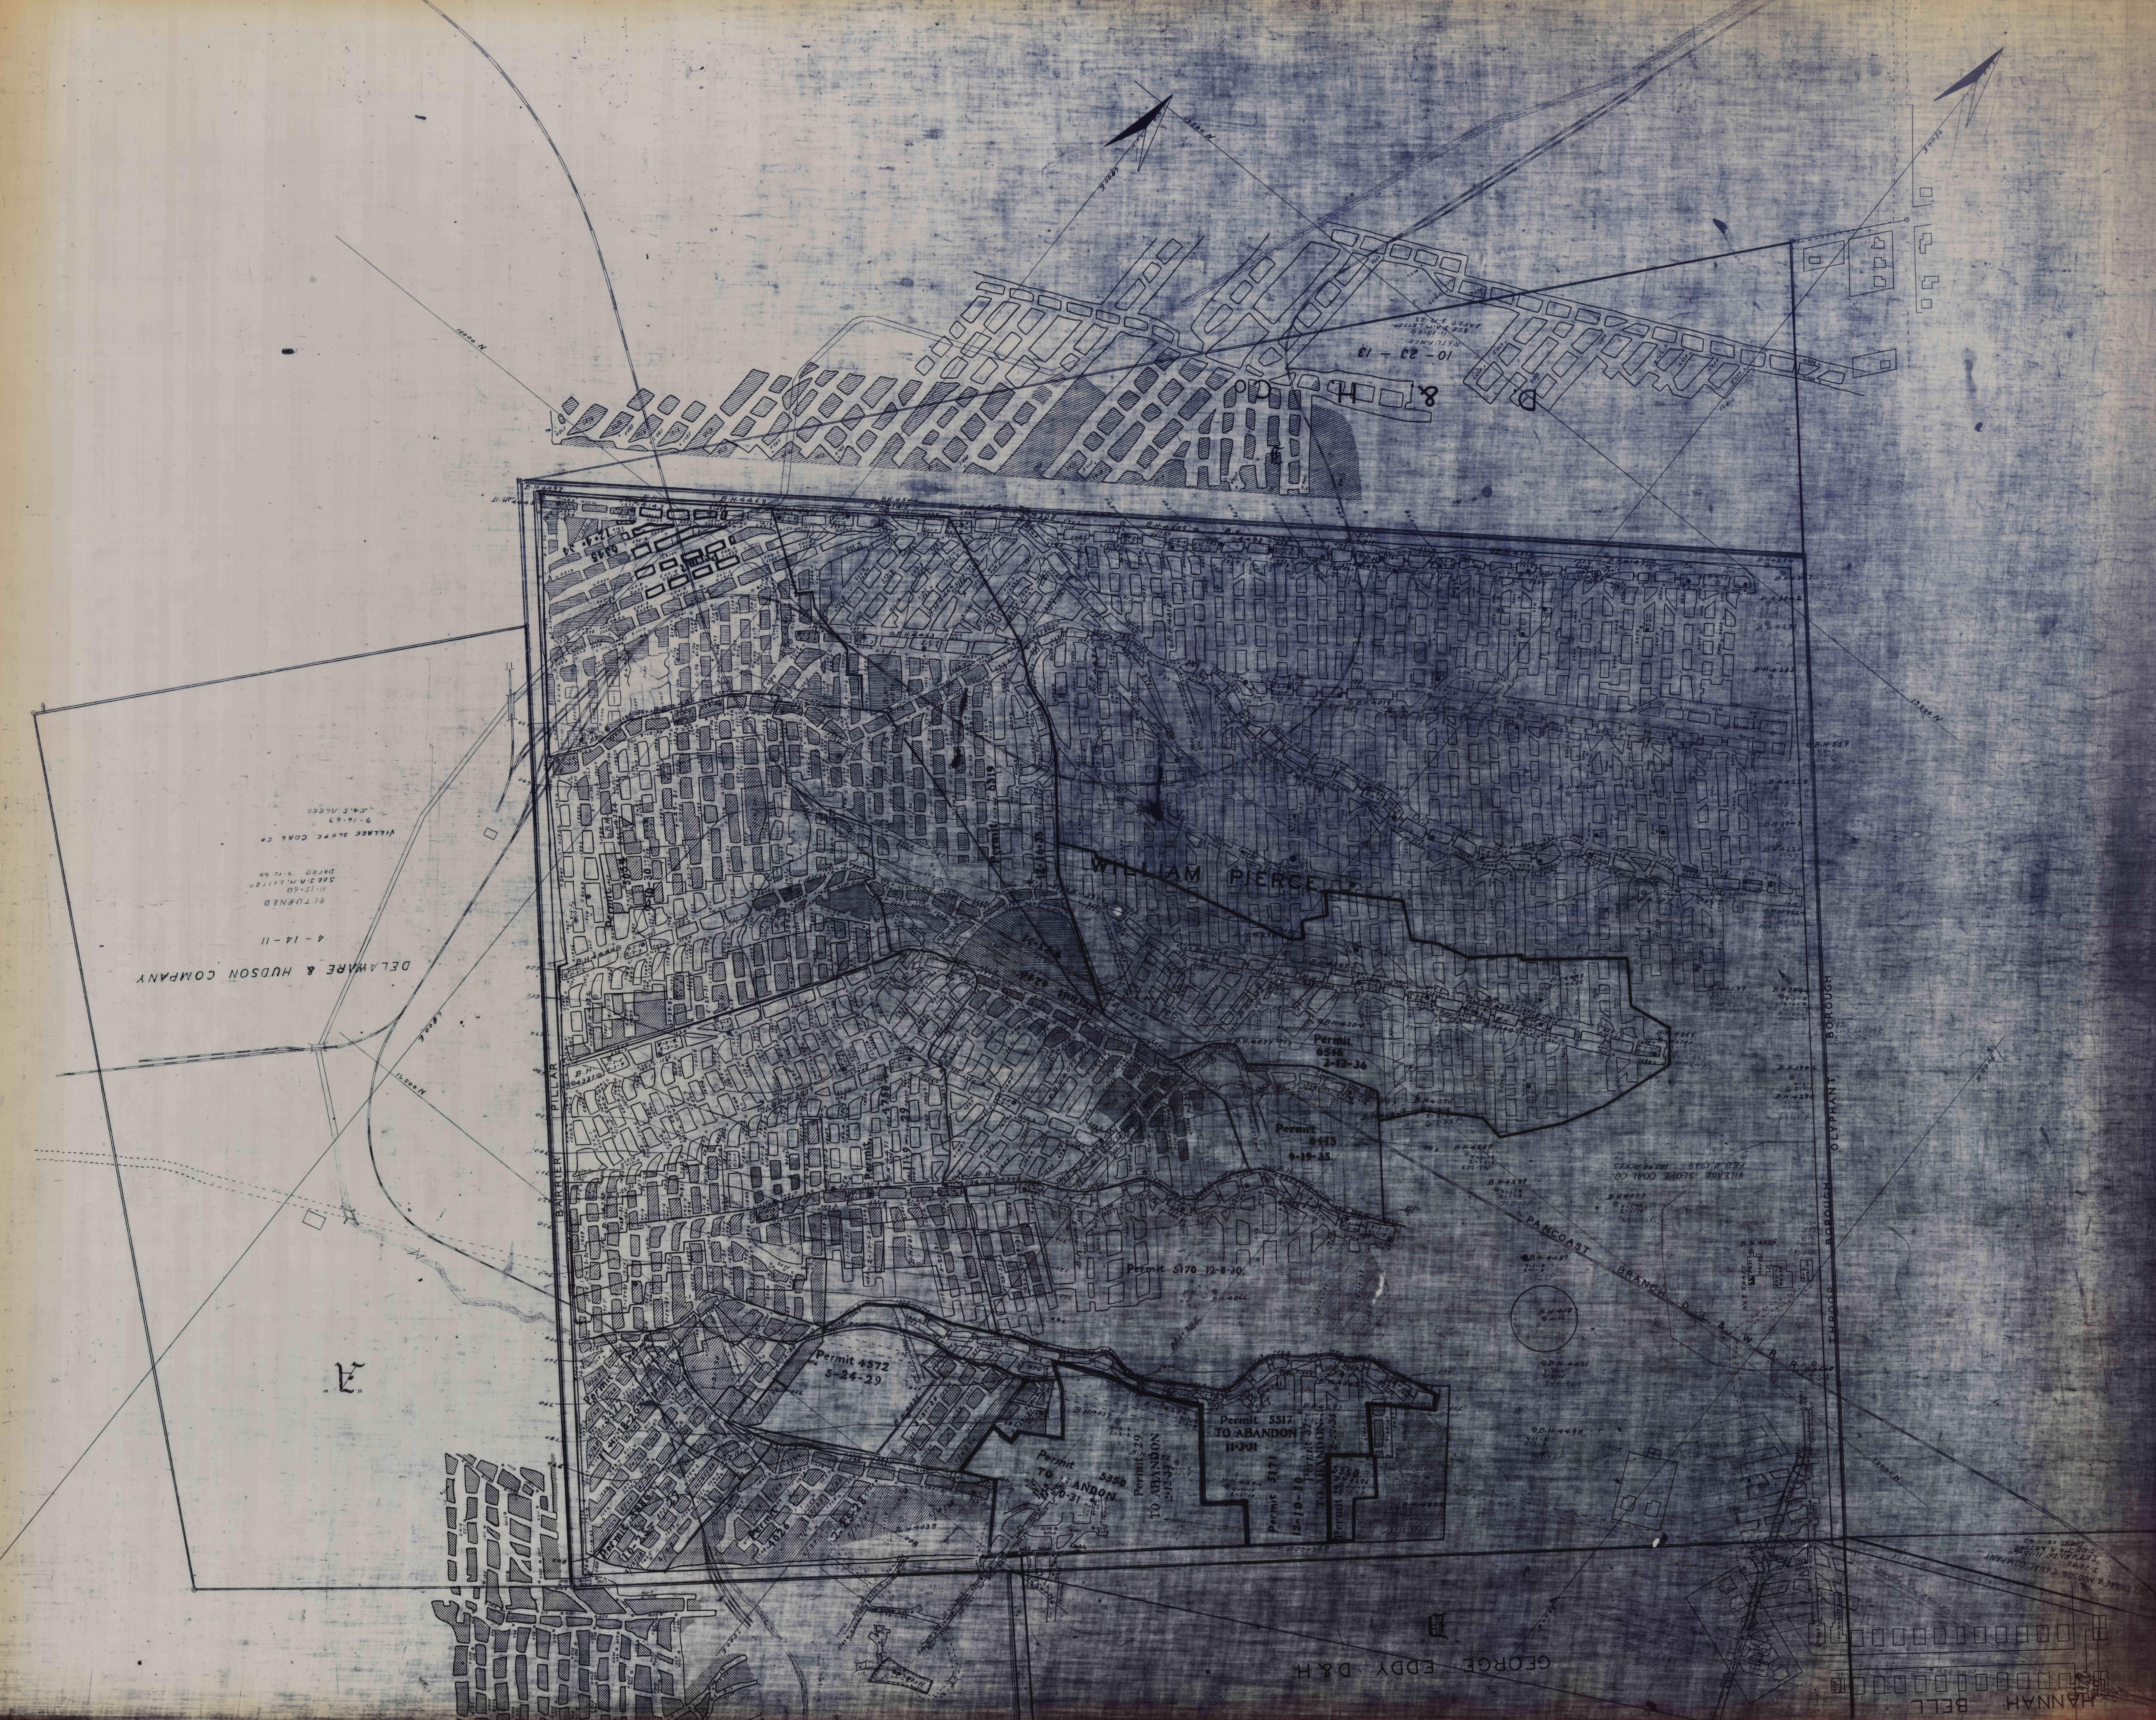

WILLIAM PIERCE
BARRIER PILLAR
THROOP BOROUGH
OLYPHANT BOROUGH
PANCOAST BRANCH D. L. & W. R. R.
Permit 6546 2-12-36
Permit 6445 9-19-35
Permit 5170 12-8-30.
Permit 4572 5-24-29
Permit 5517 TO ABANDON 11-3-31
Permit 5350 TO ABANDON 5-20-31
Permit 29 TO ABANDON 2-12-34
Permit 5171 12-10-30
Permit 37 TO ABANDON 2-27-34
Permit 29
5350
Permit 4026 2-23-28
Permit 6319 12-16-35
Permit 6345 12-4-34
Permit 5034 9-10-30
Permit 4758 11-9-29
Permit 3377 4-18-26
Permit 3886 10-2-27
No 3 SHAFT
ENGINE HOUSE
VILLAGE SLOPE COAL CO. FEB. 2, 1949. 188.86 ACRES
DELAWARE & HUDSON COMPANY
4-14-11
RETURNED 11-15-60 SEE J.A.M. LETTER DATED 3-12-60
VILLAGE SLOPE COAL CO 9-16-63 54.5 ACRES
"A"
D & H
10-23-13
RETURNED 11-15-60 SEE J.A.M. LETTER DATED 3-12-63
GEORGE EDDY D&H
"E"
HANNAH BELL
DELAWARE & HUDSON CANAL COMPANY 5-23-89 RETURNED 11-15-60 SEE J.A.M. LETTER DATED 12-11-63
18000 N
16500 N
19500 N
6000 E
7500 E
9000 E
B.H. 4497
B.H. 4445
B.H. 4468
B.H. 4546
B.H. 4308
B.H. 4309
B.H. 4493
B.H. 4312
B.H. 4149
B.H. 4234
B.H. 4347
B.H. 3842
B.H. 4231
B.H. 4233
B.H. 559
B.H. 4228
B.H. 3843
B.H. 4223
B.H. 3924
B.H. 4197
B.H. 3844
B.H. 4363 Water
B.H. 3942
B.H. 4290
B.H. 4075
B.H. 4288
B.H. 4289
B.H. 4073
B.H. 4196
B.H. 4499
B.H. 4187 wire
B.H. 4071
B.H. 4498
B.H. 4066
B.H. 4077
B.H. 4304
B.H. 4015
B.H. 4019
B.H. 4463
B.H. 4466
B.H. 4334
B.H. 4444
B.H. 4331
B.H. 4330
B.H. 3879
B.H. 4378
B.H. 4038
B.H. 4039
B.H. 4292
B.H. 4294
B.H. 4293
B.H. 4296
B.H. 4033