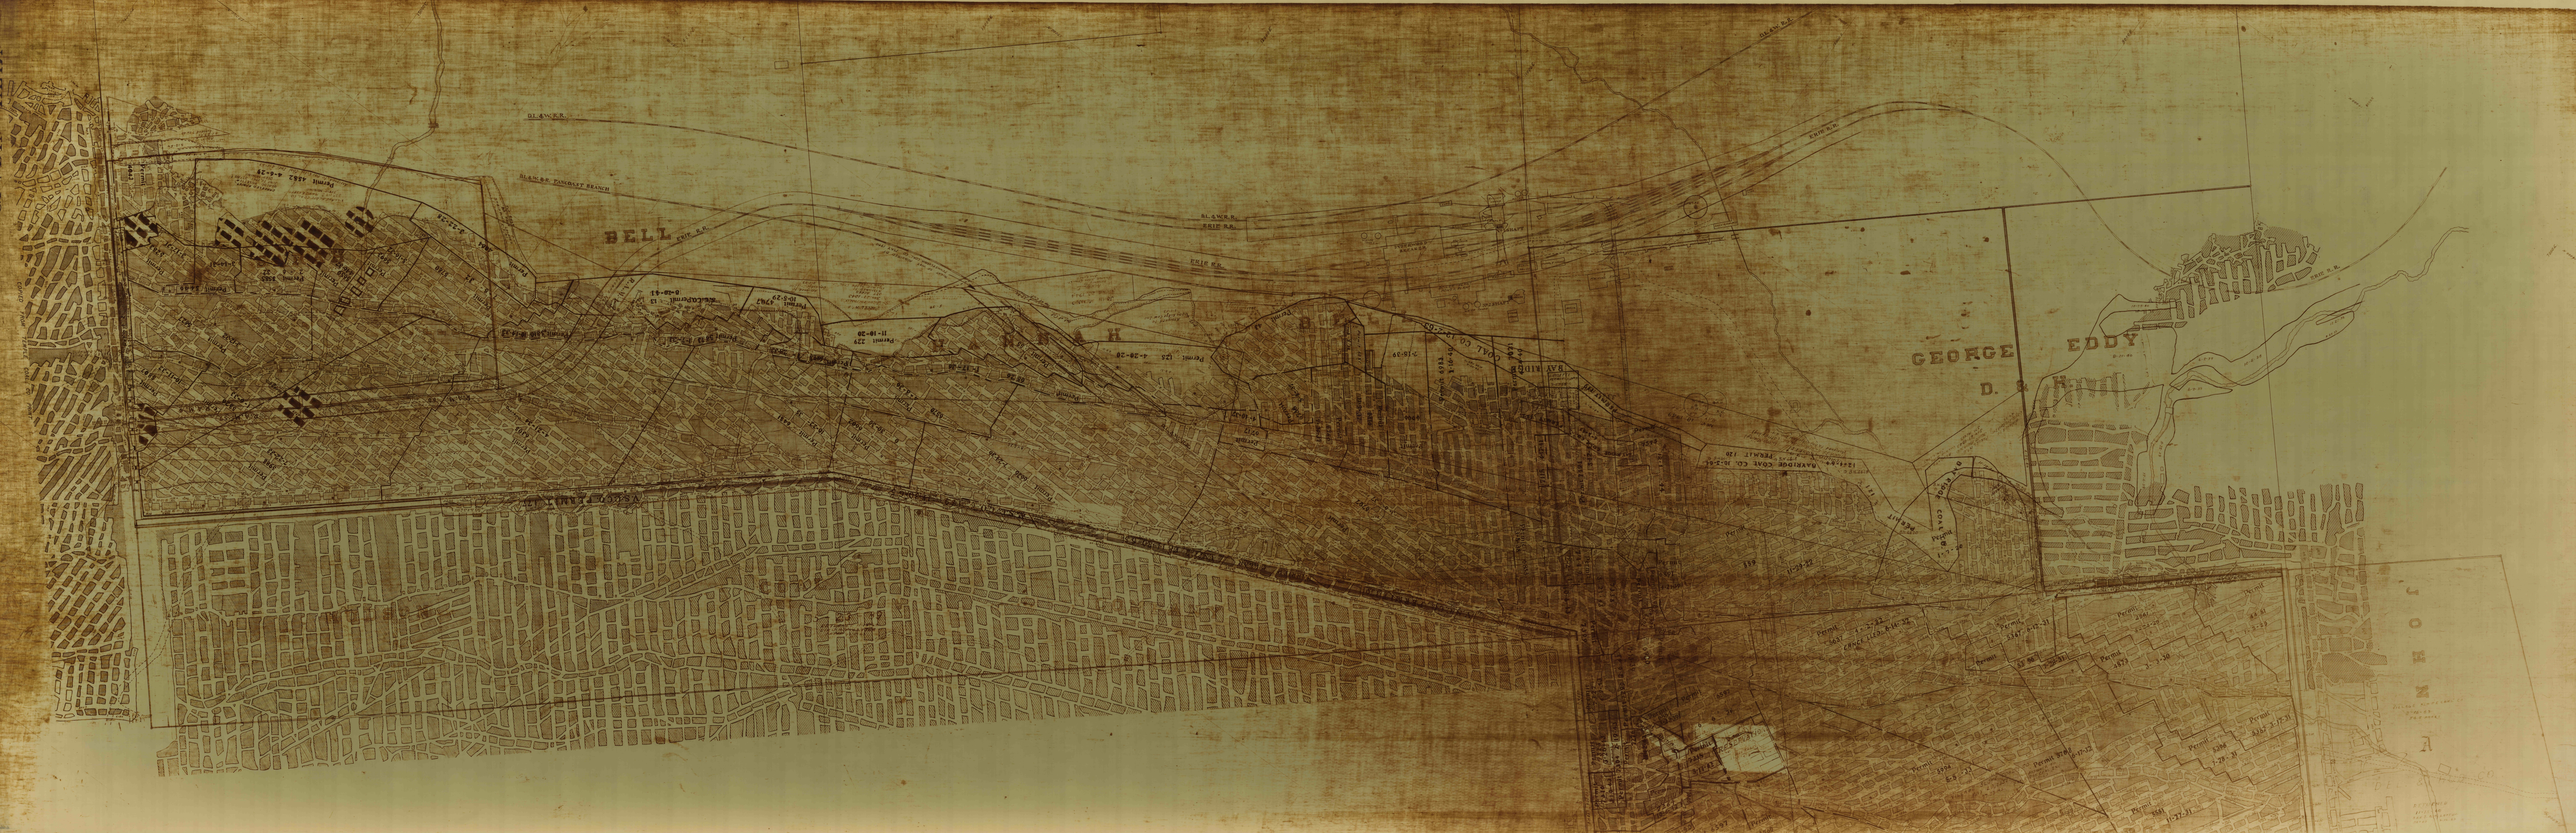
BELL
GEORGE
EDDY
D. 2
D. 1
D. 3
D. 4
