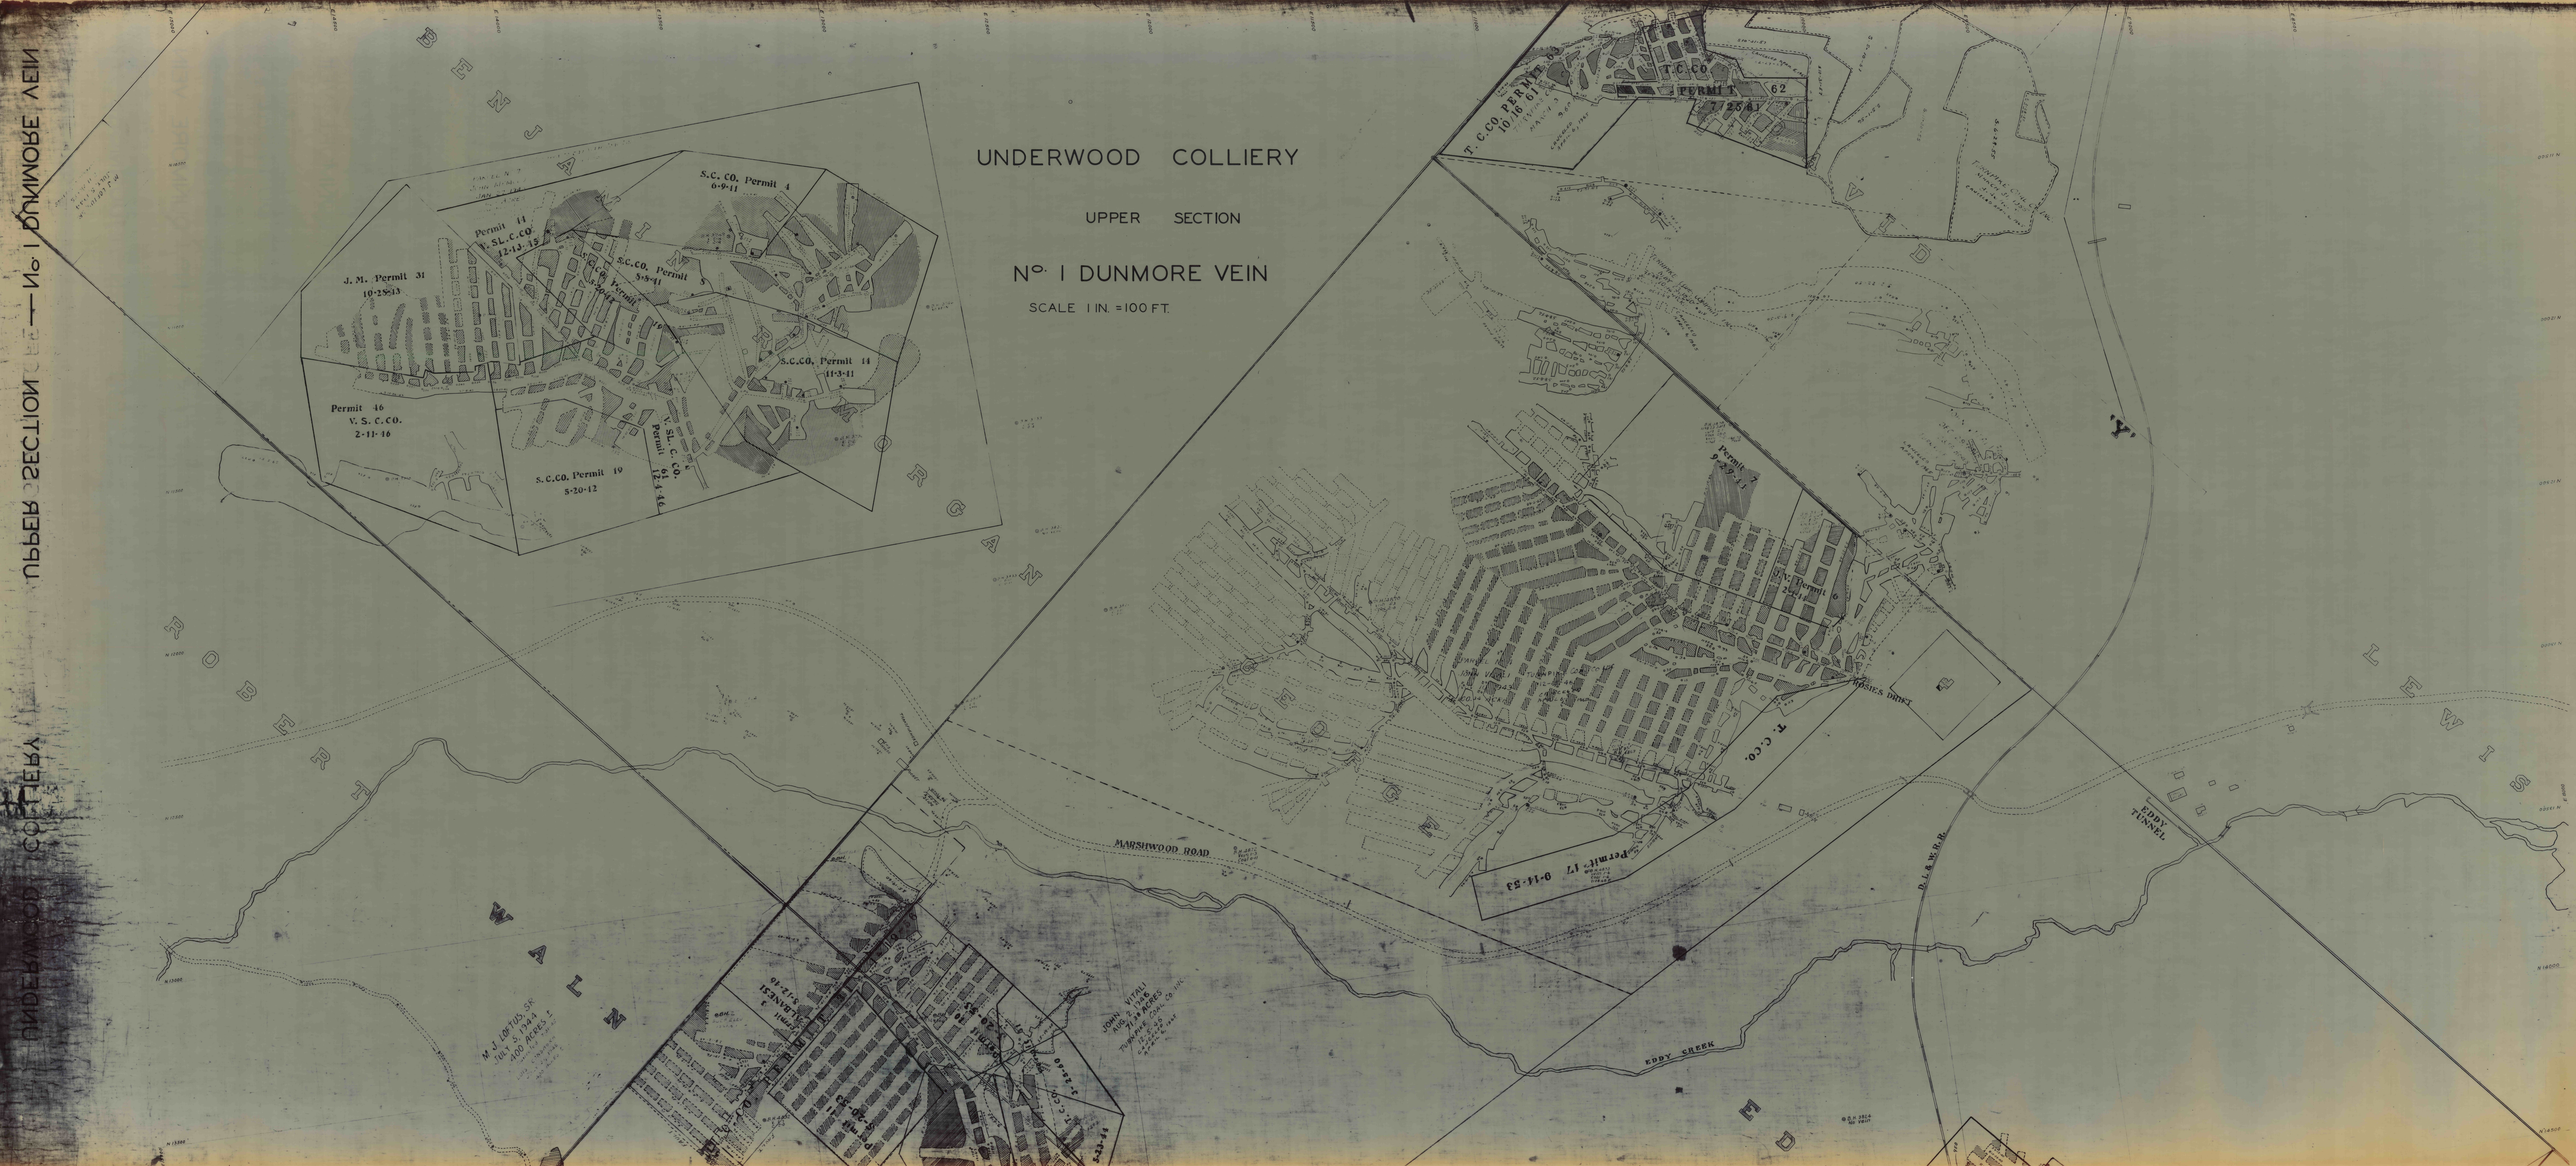

UPPER SECTION — No. 1 DUNMORE VEIN

UNDERWOOD COLLIERY