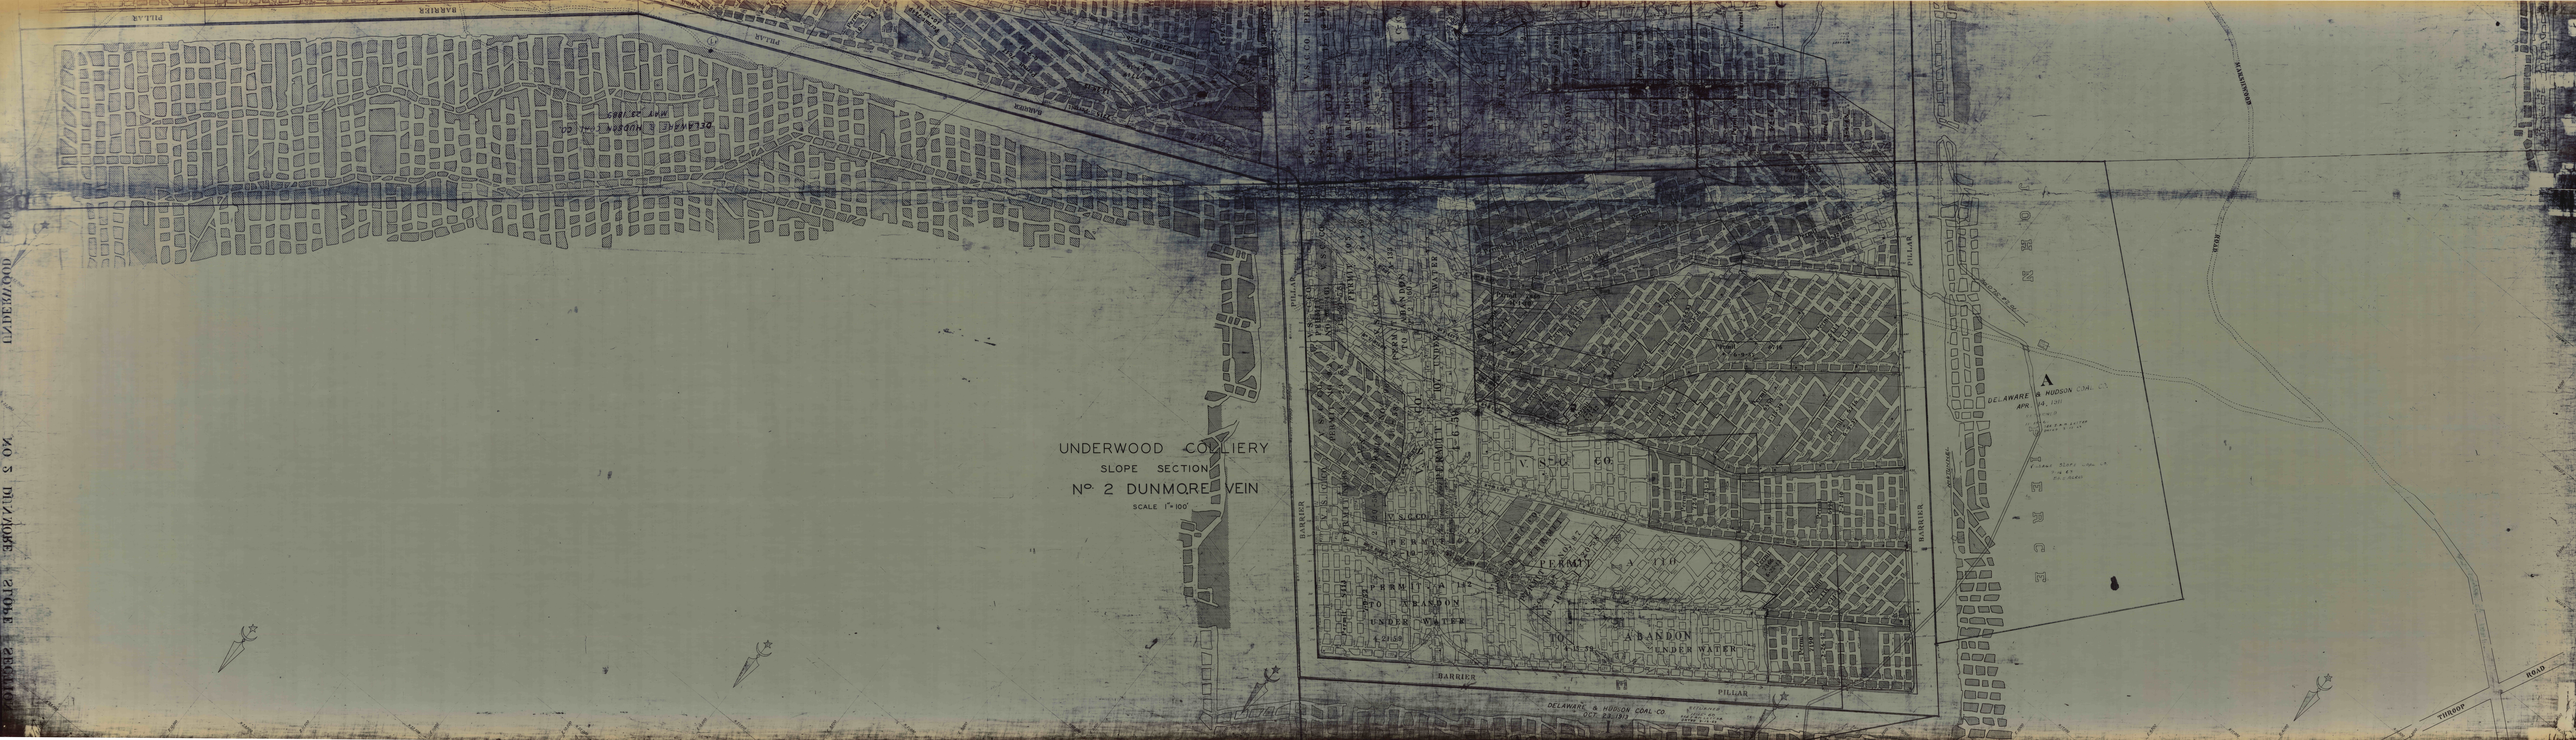
UNDERWOOD COLLIERY
SLOPE SECTION
No. 2 DUNMORE VEIN
SCALE 1" = 100'
PERMIT
ABANDON UNDER WATER
BARRIER
PILLAR
DELAWARE & HUDSON COAL CO.
OCT. 1919
DUNMORE
THROOP ROAD