


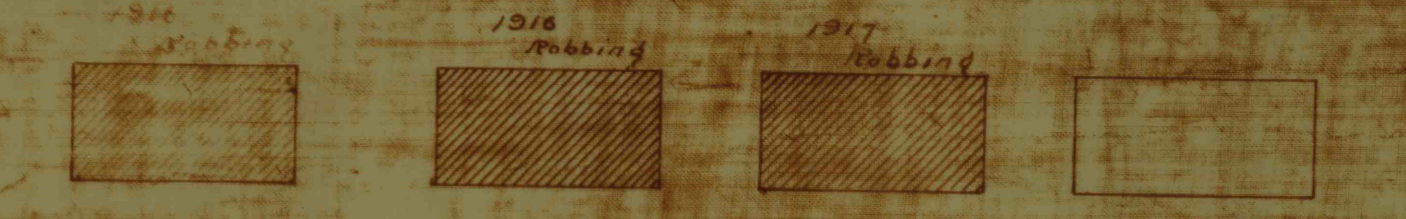

MAP
SHOWING WORKINGS
IN
TOP SPLIT - DUNMORE VEIN.
ARCHBALD COAL CO.



SCALE, 100' = 1"