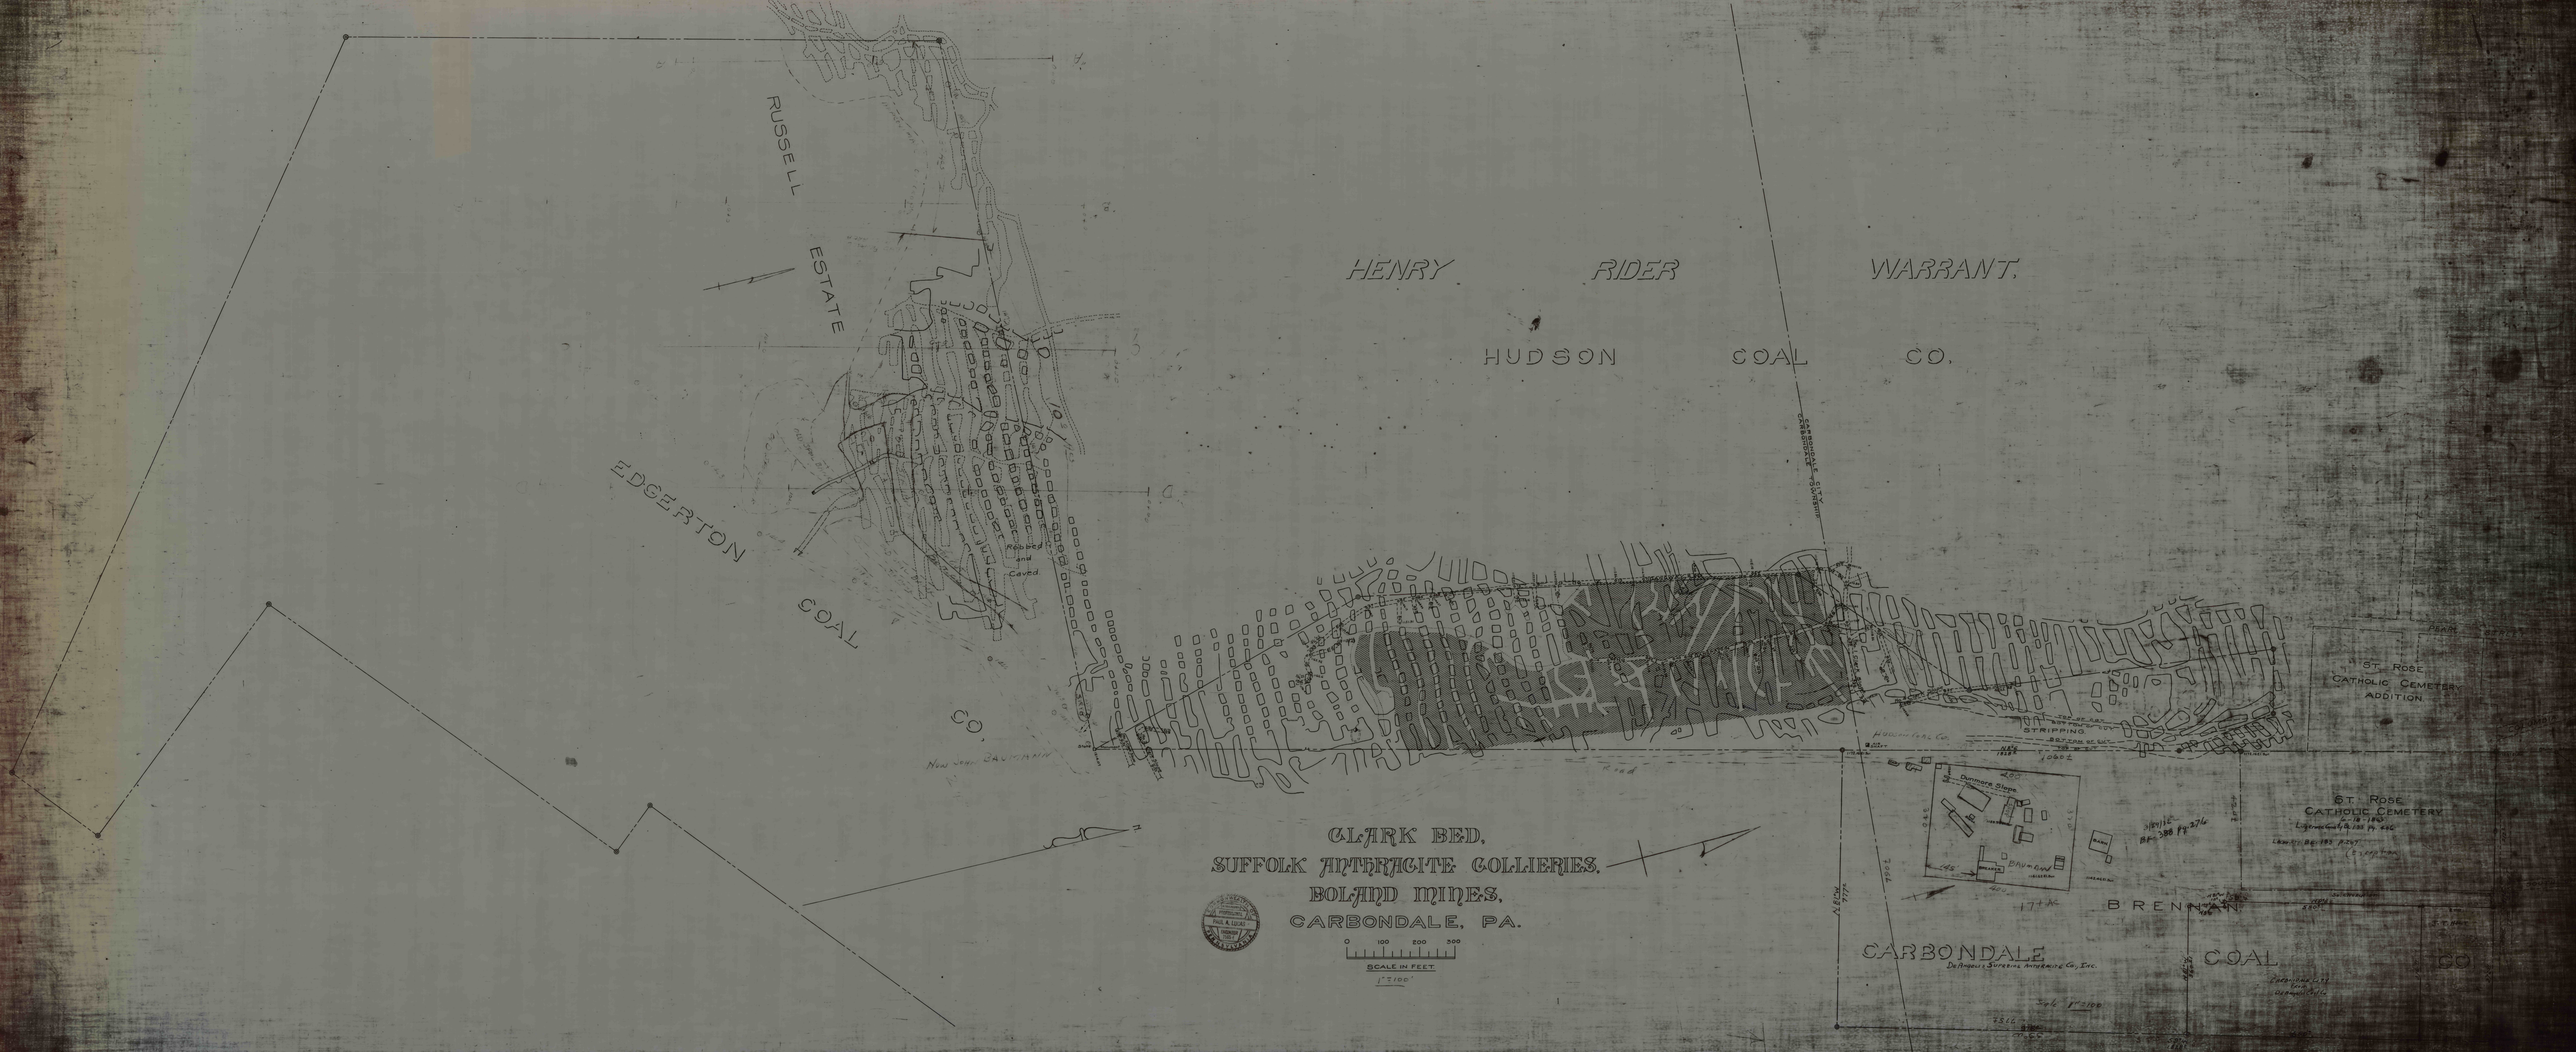
HENRY RIDER WARRANT.
HUDSON COAL CO.
RUSSELL ESTATE
EDGERTON COAL CO.
Robbed and Caved
STRIPPING
ST. ROSE CATHOLIC CEMETERY ADDITION
ST. ROSE CATHOLIC CEMETERY
Dunmore Slope
BRENNAN COAL CO.
CARBONDALE
CLARK BED,
SUFFOLK ANTHRACITE COLLIERIES,
BOLAND MINES,
CARBONDALE, PA.
0 100 200 300
SCALE IN FEET.
1" = 100'