
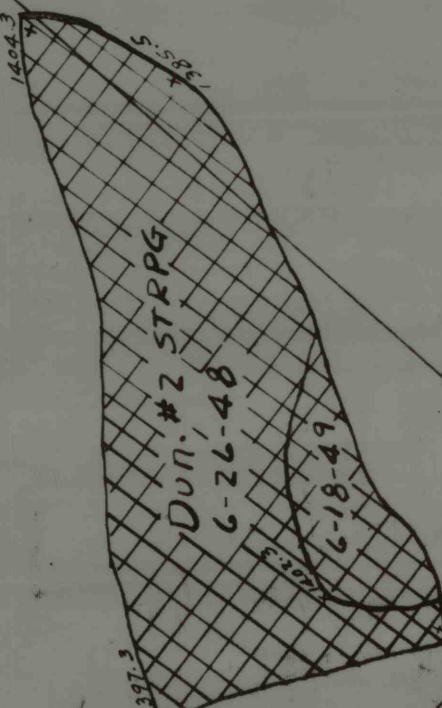


JAMES CLARK TRACT

AARON CLARK TRACT

THE HUDSON COAL CO.

DE ANGELIS COAL CO.

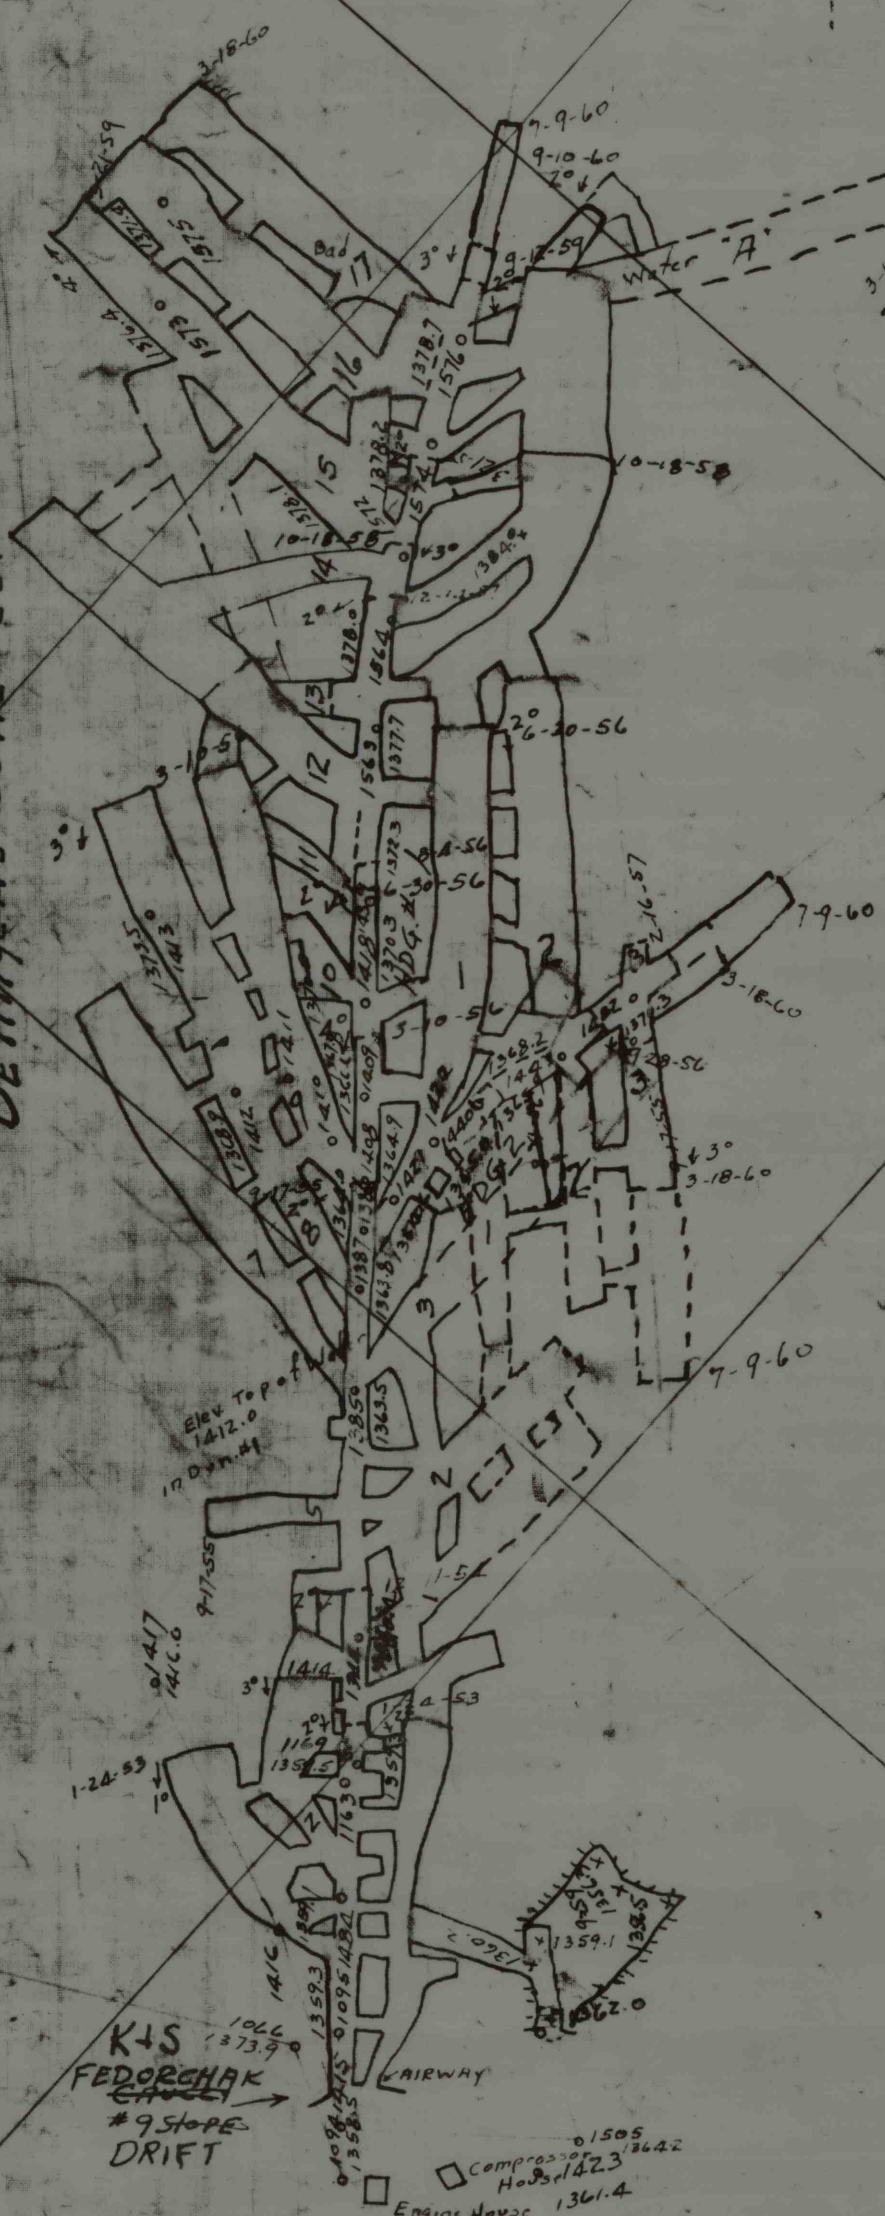

DUN. #2 - UPPER  
 DE ANGELIS COAL CO.  
 Archbald Mountain  
 Scale 1" = 100'