


PRINT ON THIS LINE

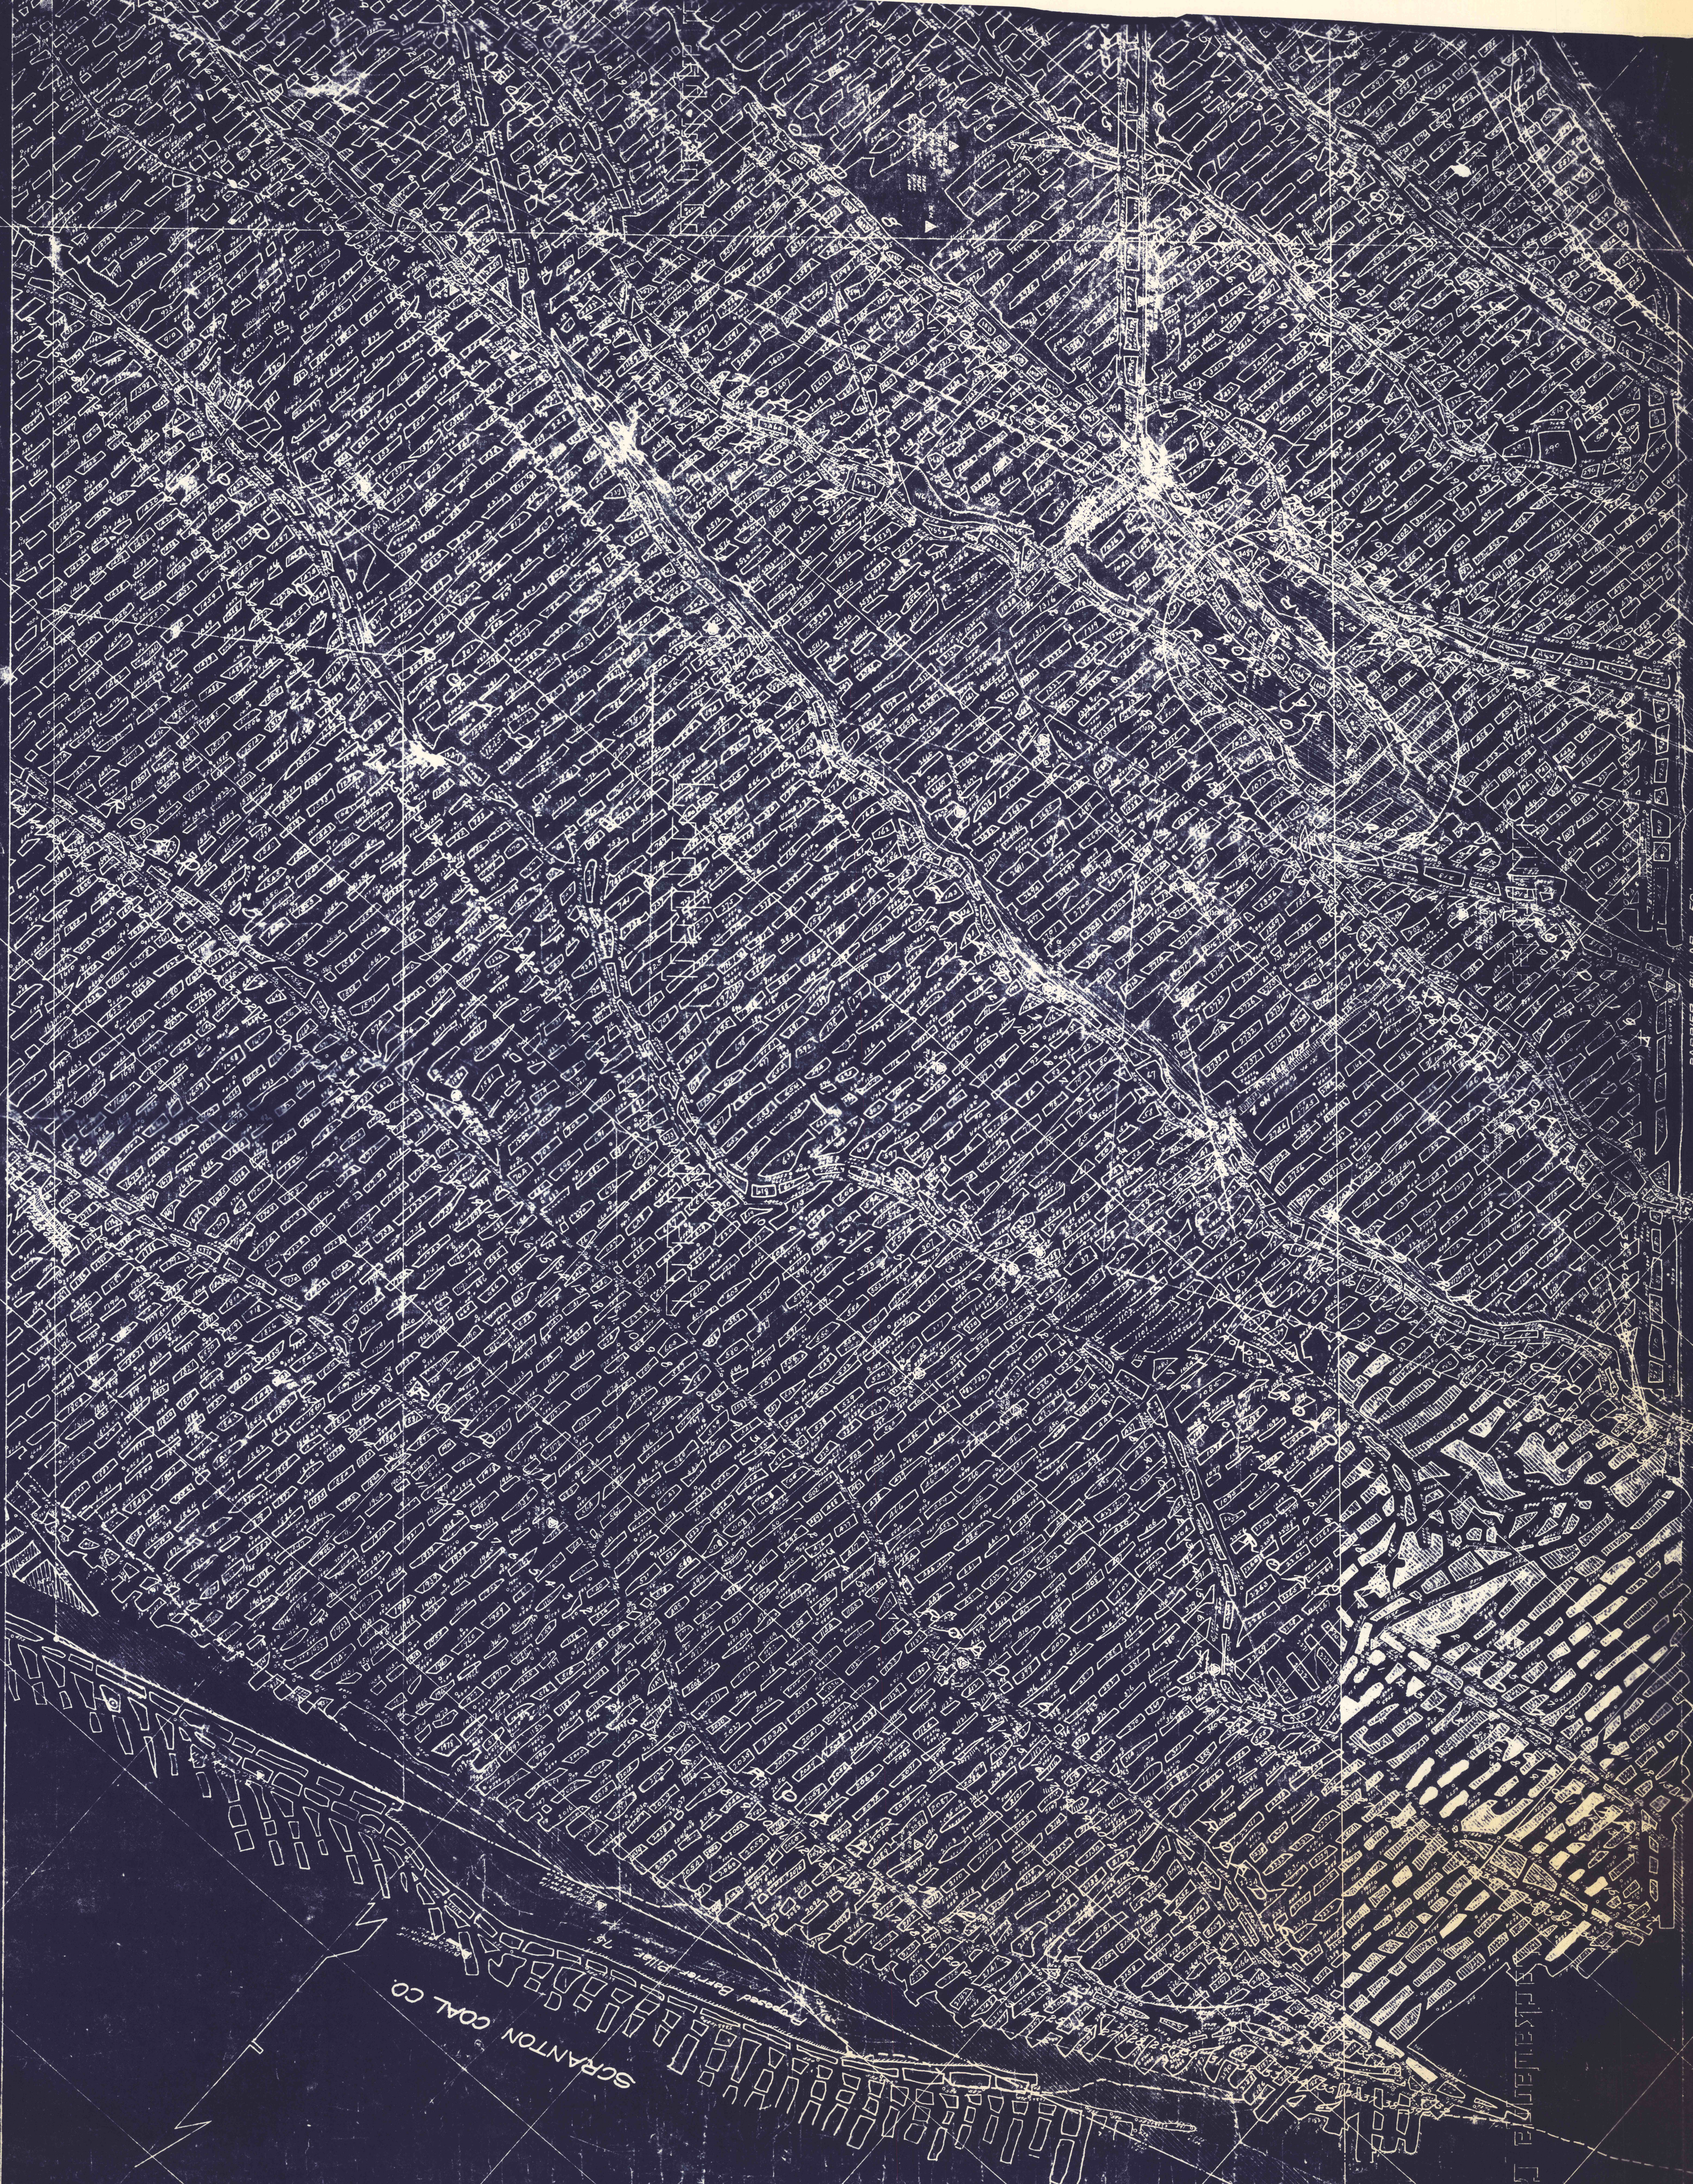

LACKA. TOP NEW COUNTY VN.