


No 2 DUNMORE VEIN
HUMBERT COAL CO JESSUP PA
SCALE 100 FT - 1 IN.

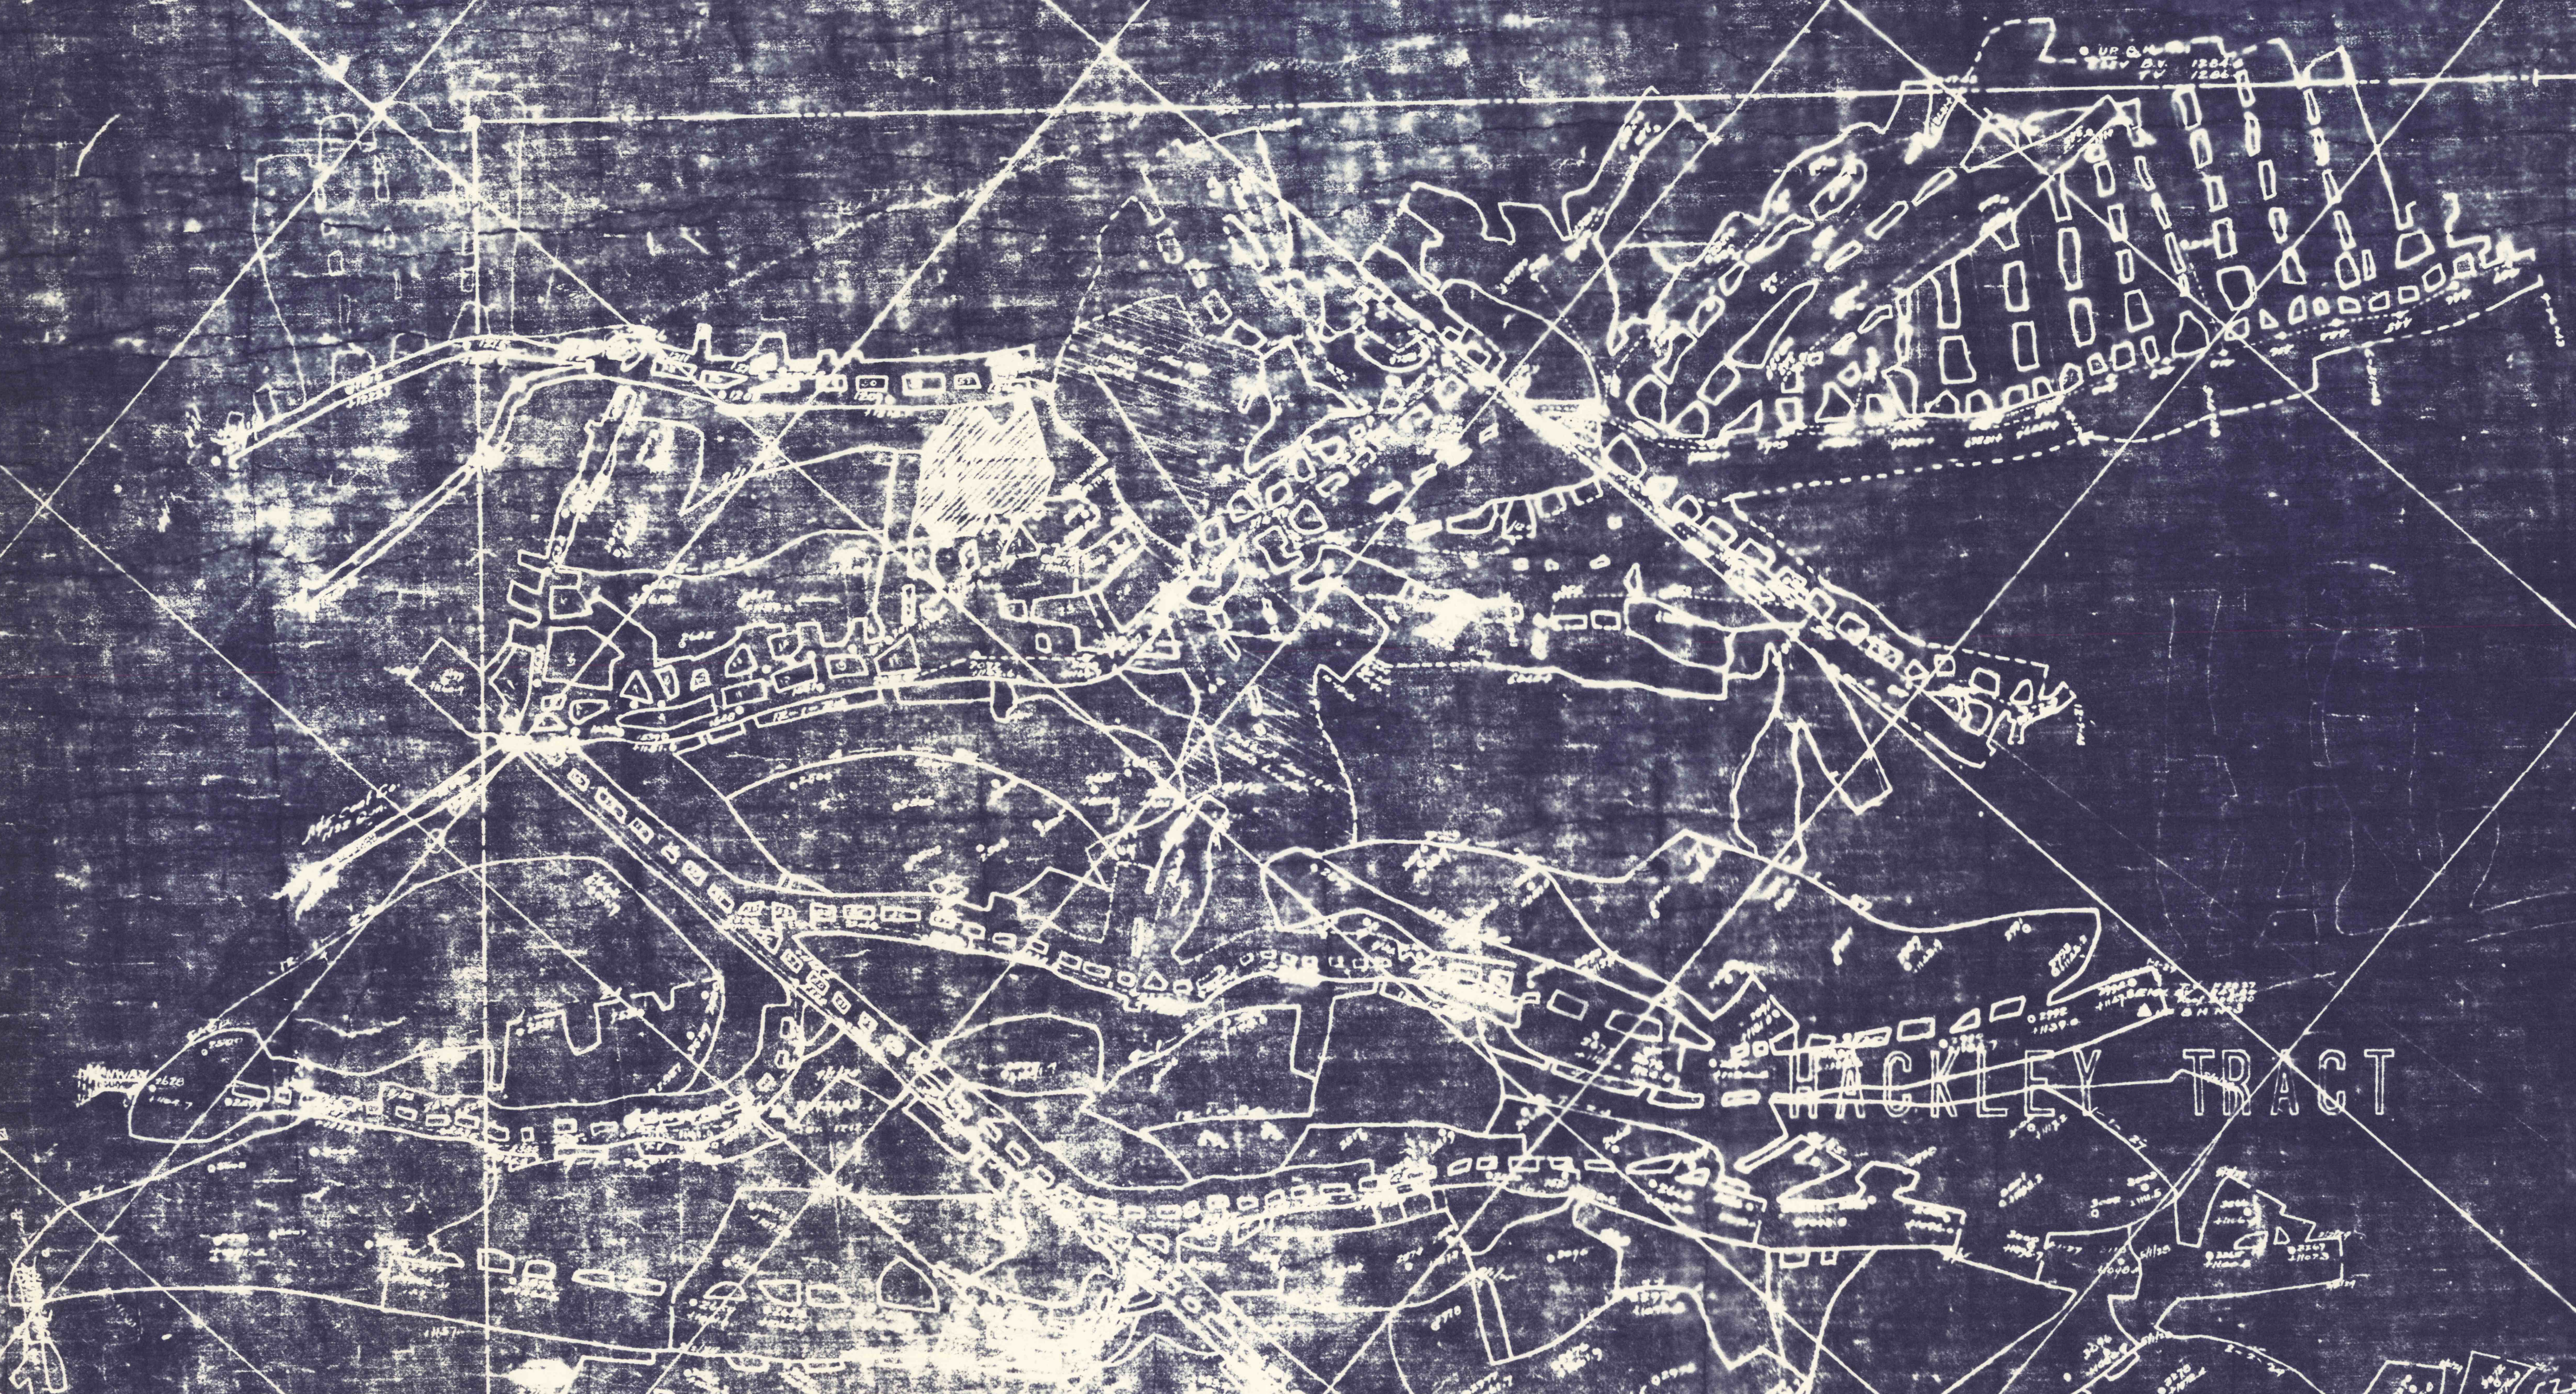

HACKLEY TRACT