


1822
1823
No. 1 DUNSTON
HUMBERT CO. CO. TESSON
SCALE 100 FT.

F. W. CO. CO.

W. C. SLOAN
WORKINGS

HACK

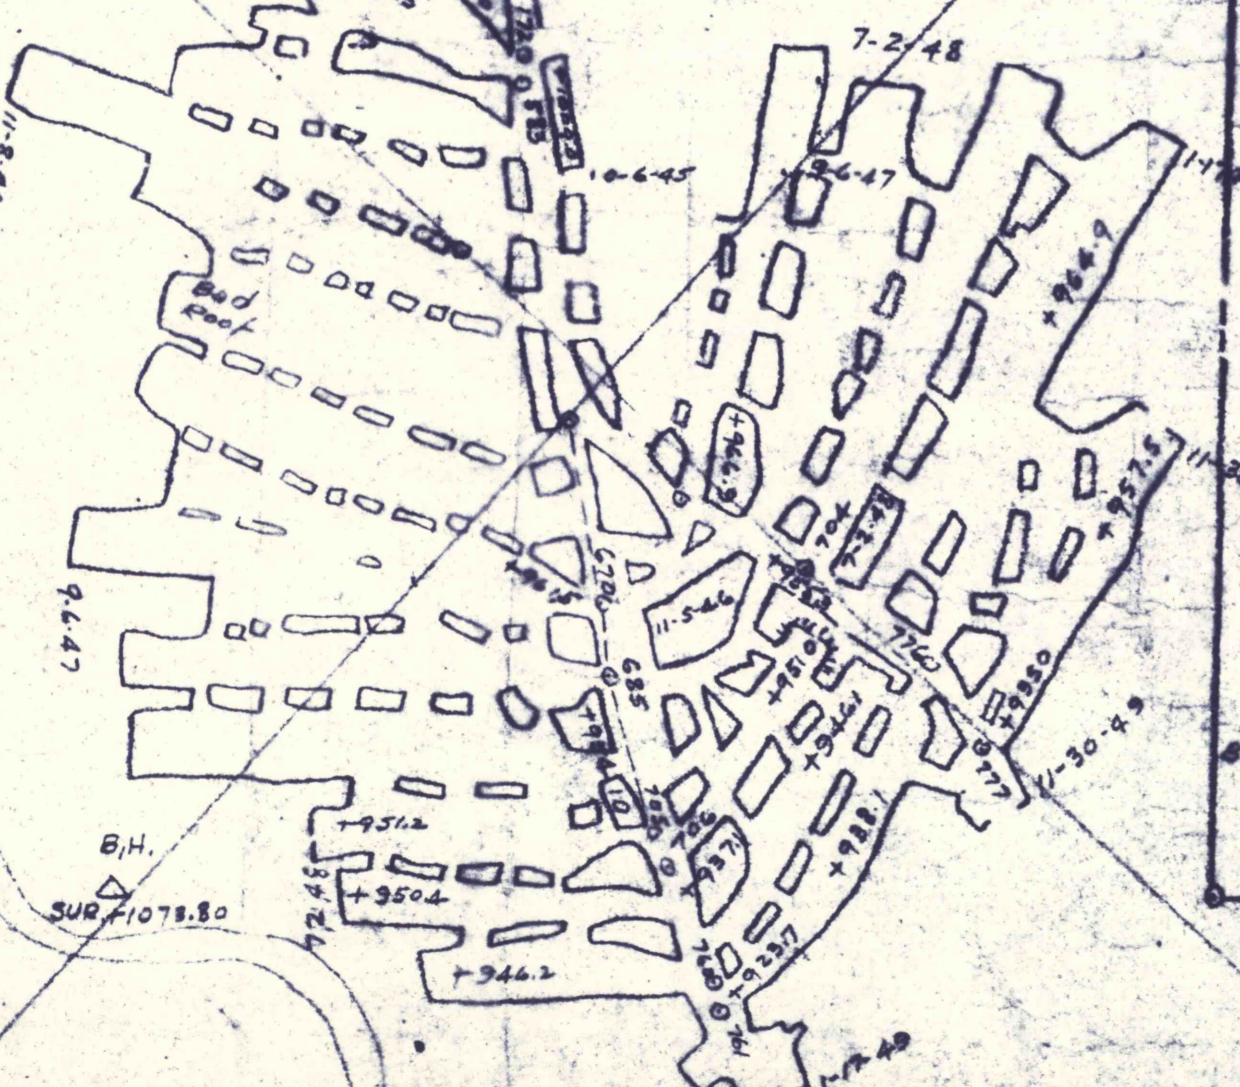

UP HOLE NO.
B.N. 102
B.N. 104
B.N. 106
B.N. 107
