



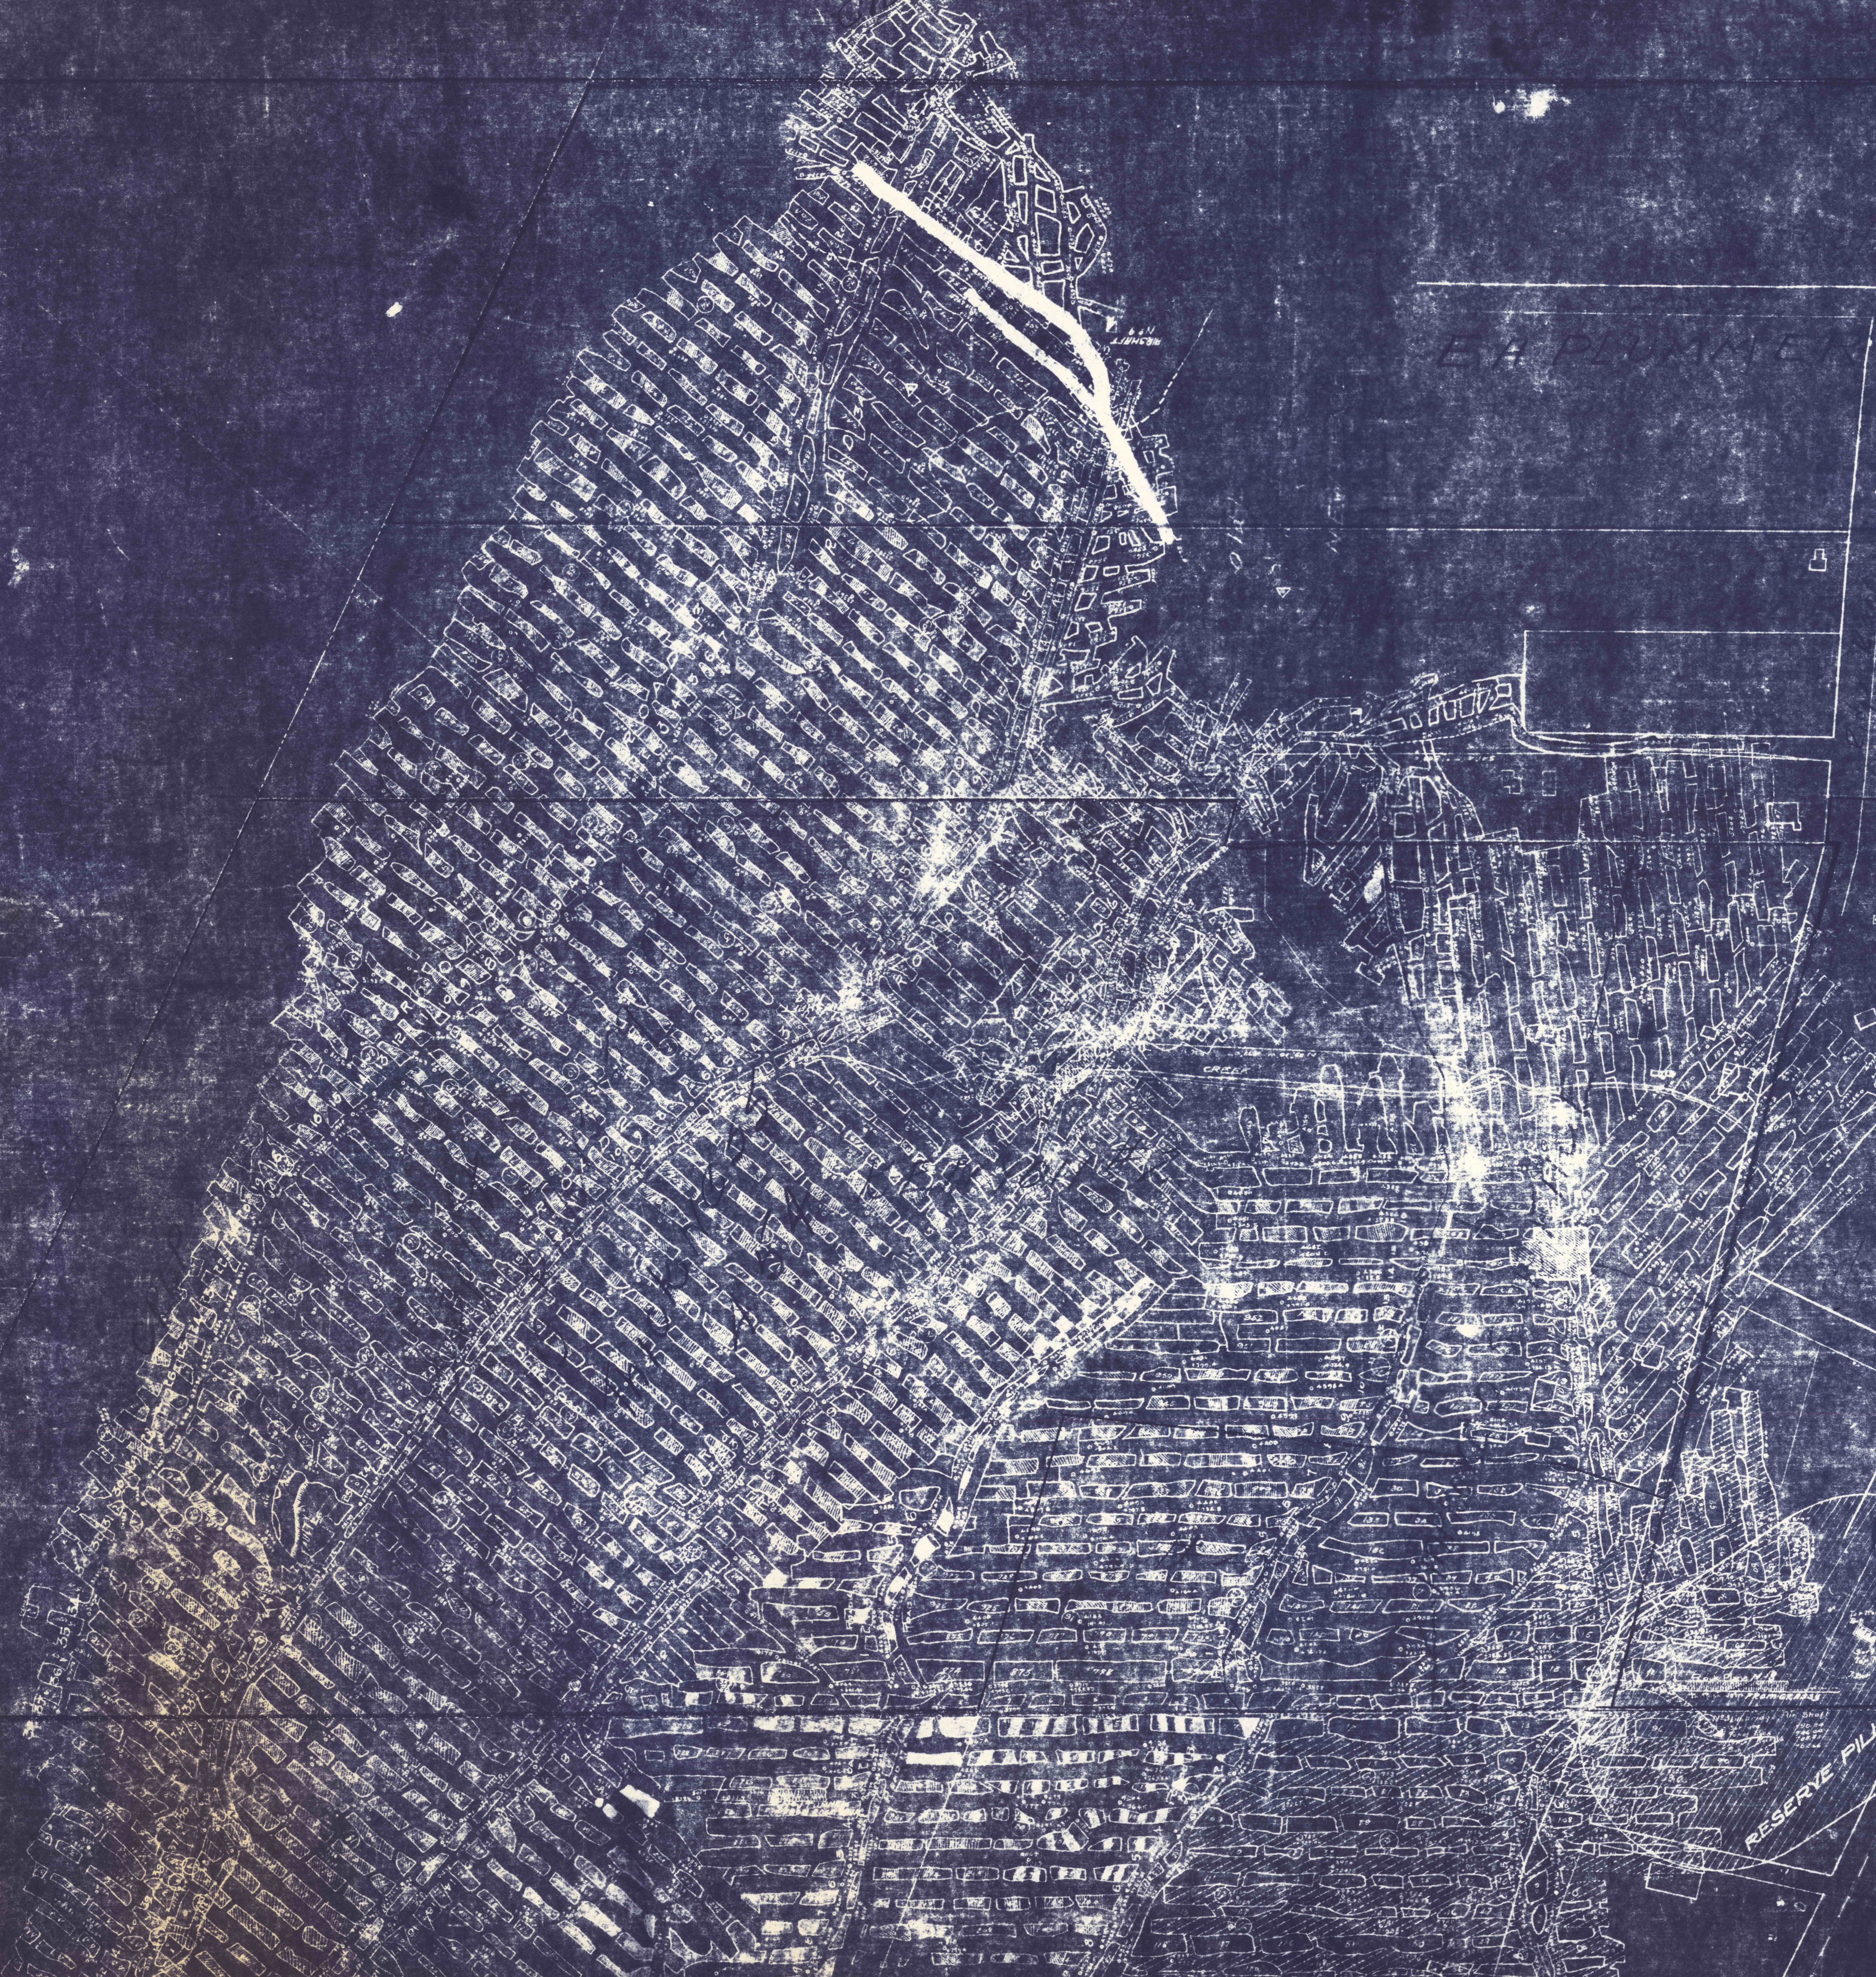


RESERVE PILL

1850