


HUDSON COAL CO
HULL TRACT



CONSUMERS COAL CO

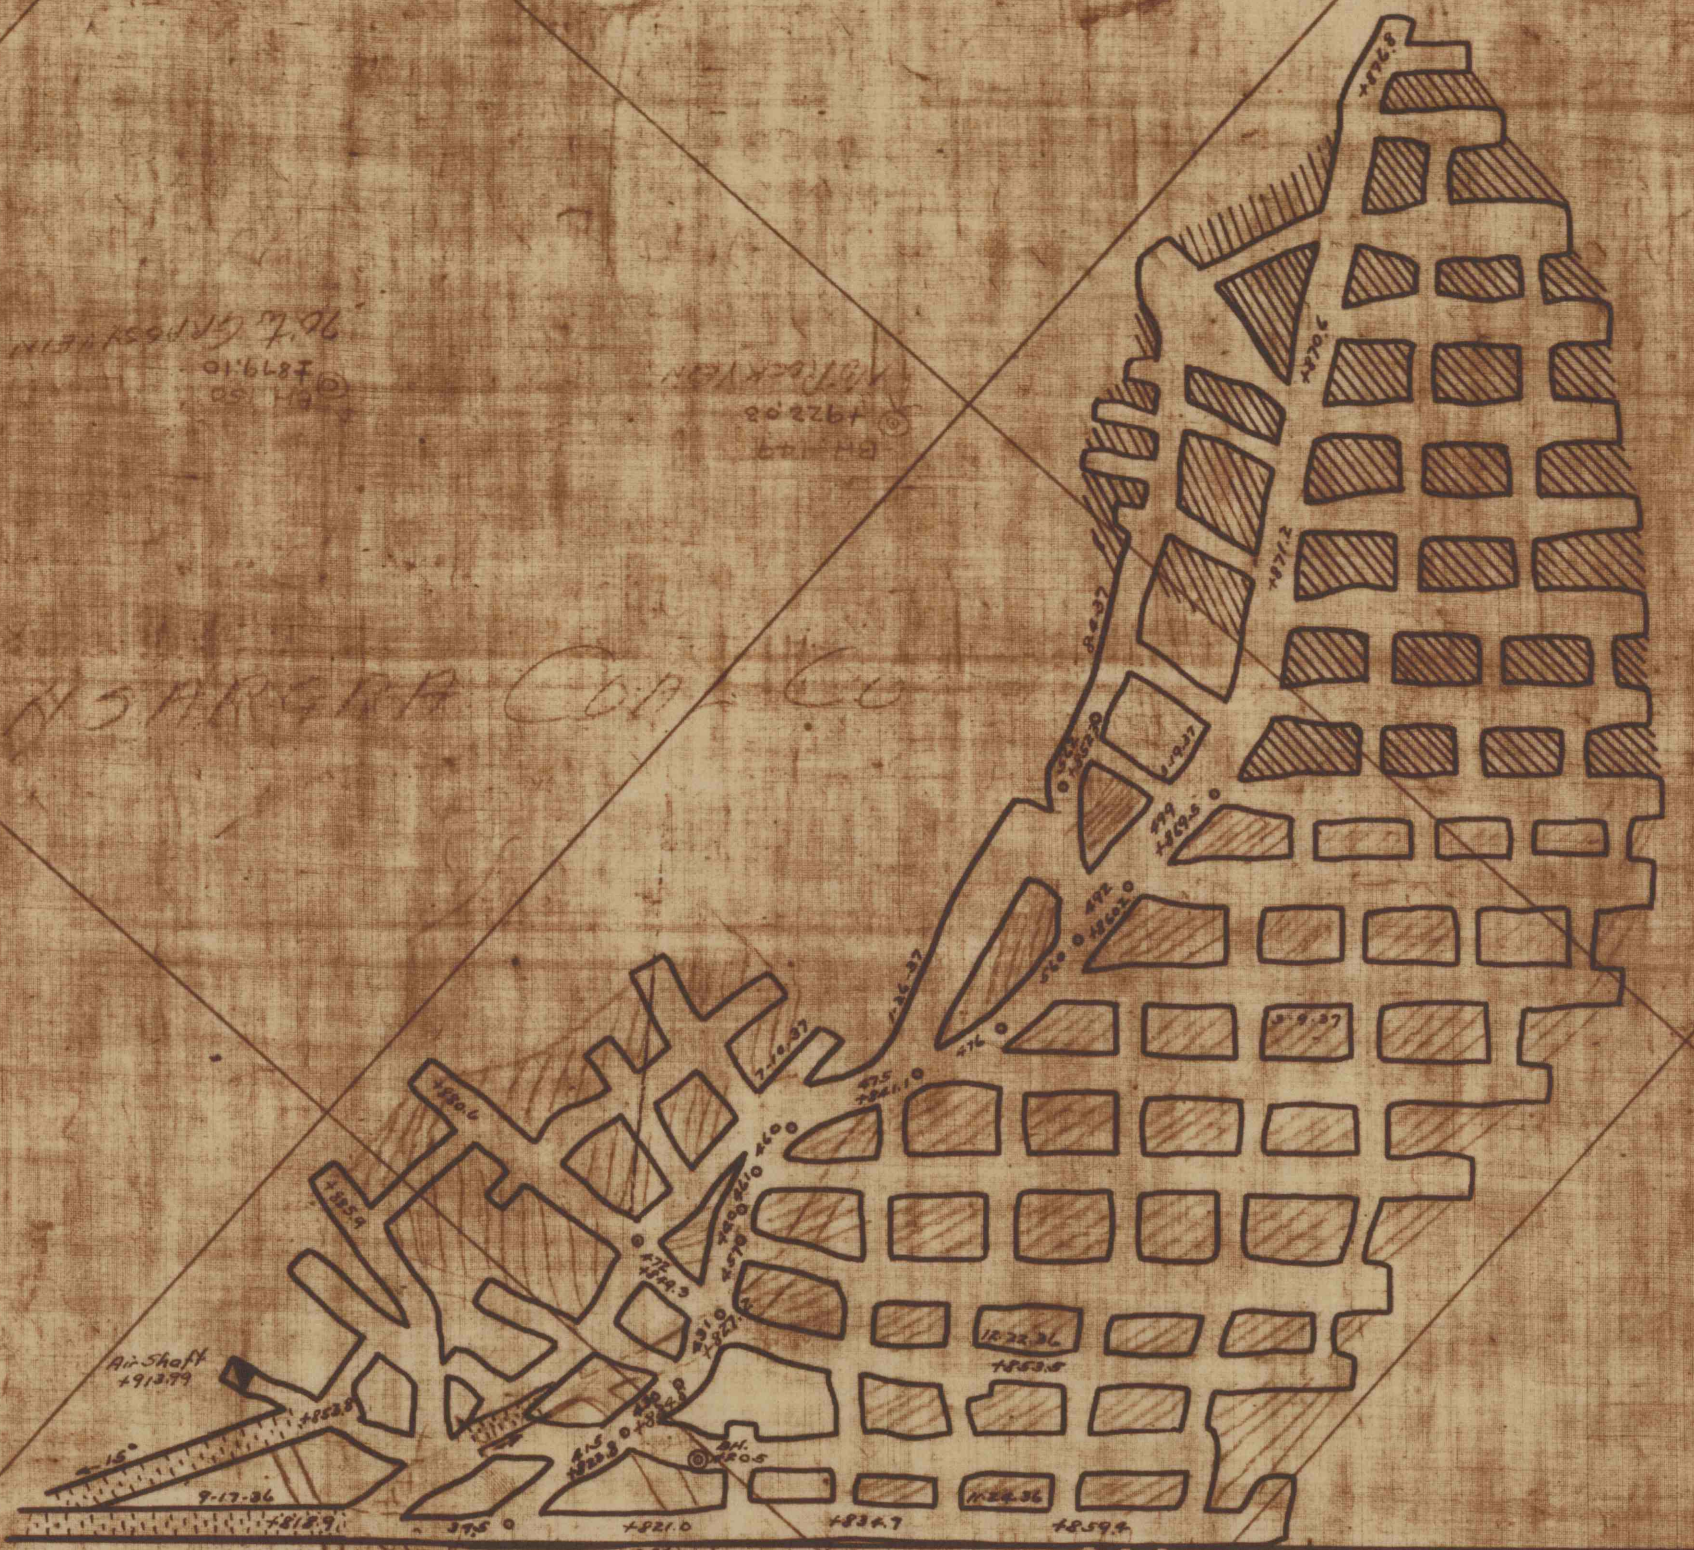

HUDSON COAL CO
STEVENS FARM