
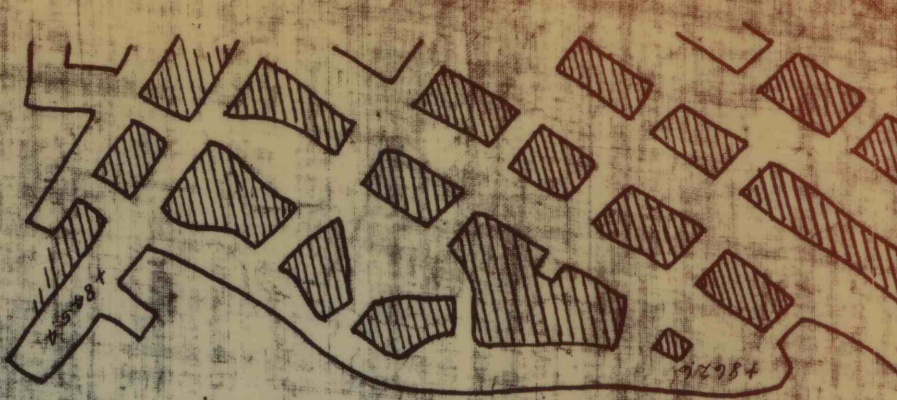


DIAMOND VEIN

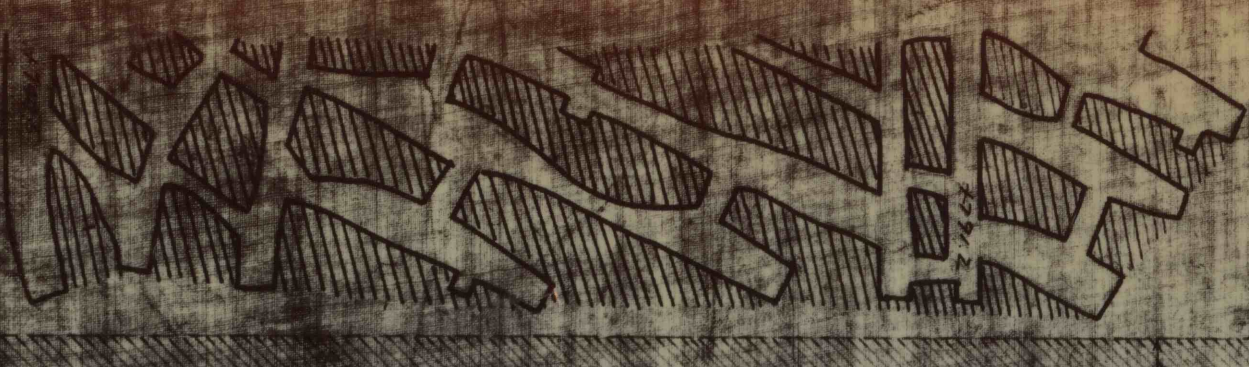

TRACT

LACKAWANNA

TRACT

FILE 64-2025

DEE

TRACT

DIAMOND VEIN

