


CLARK VEIN

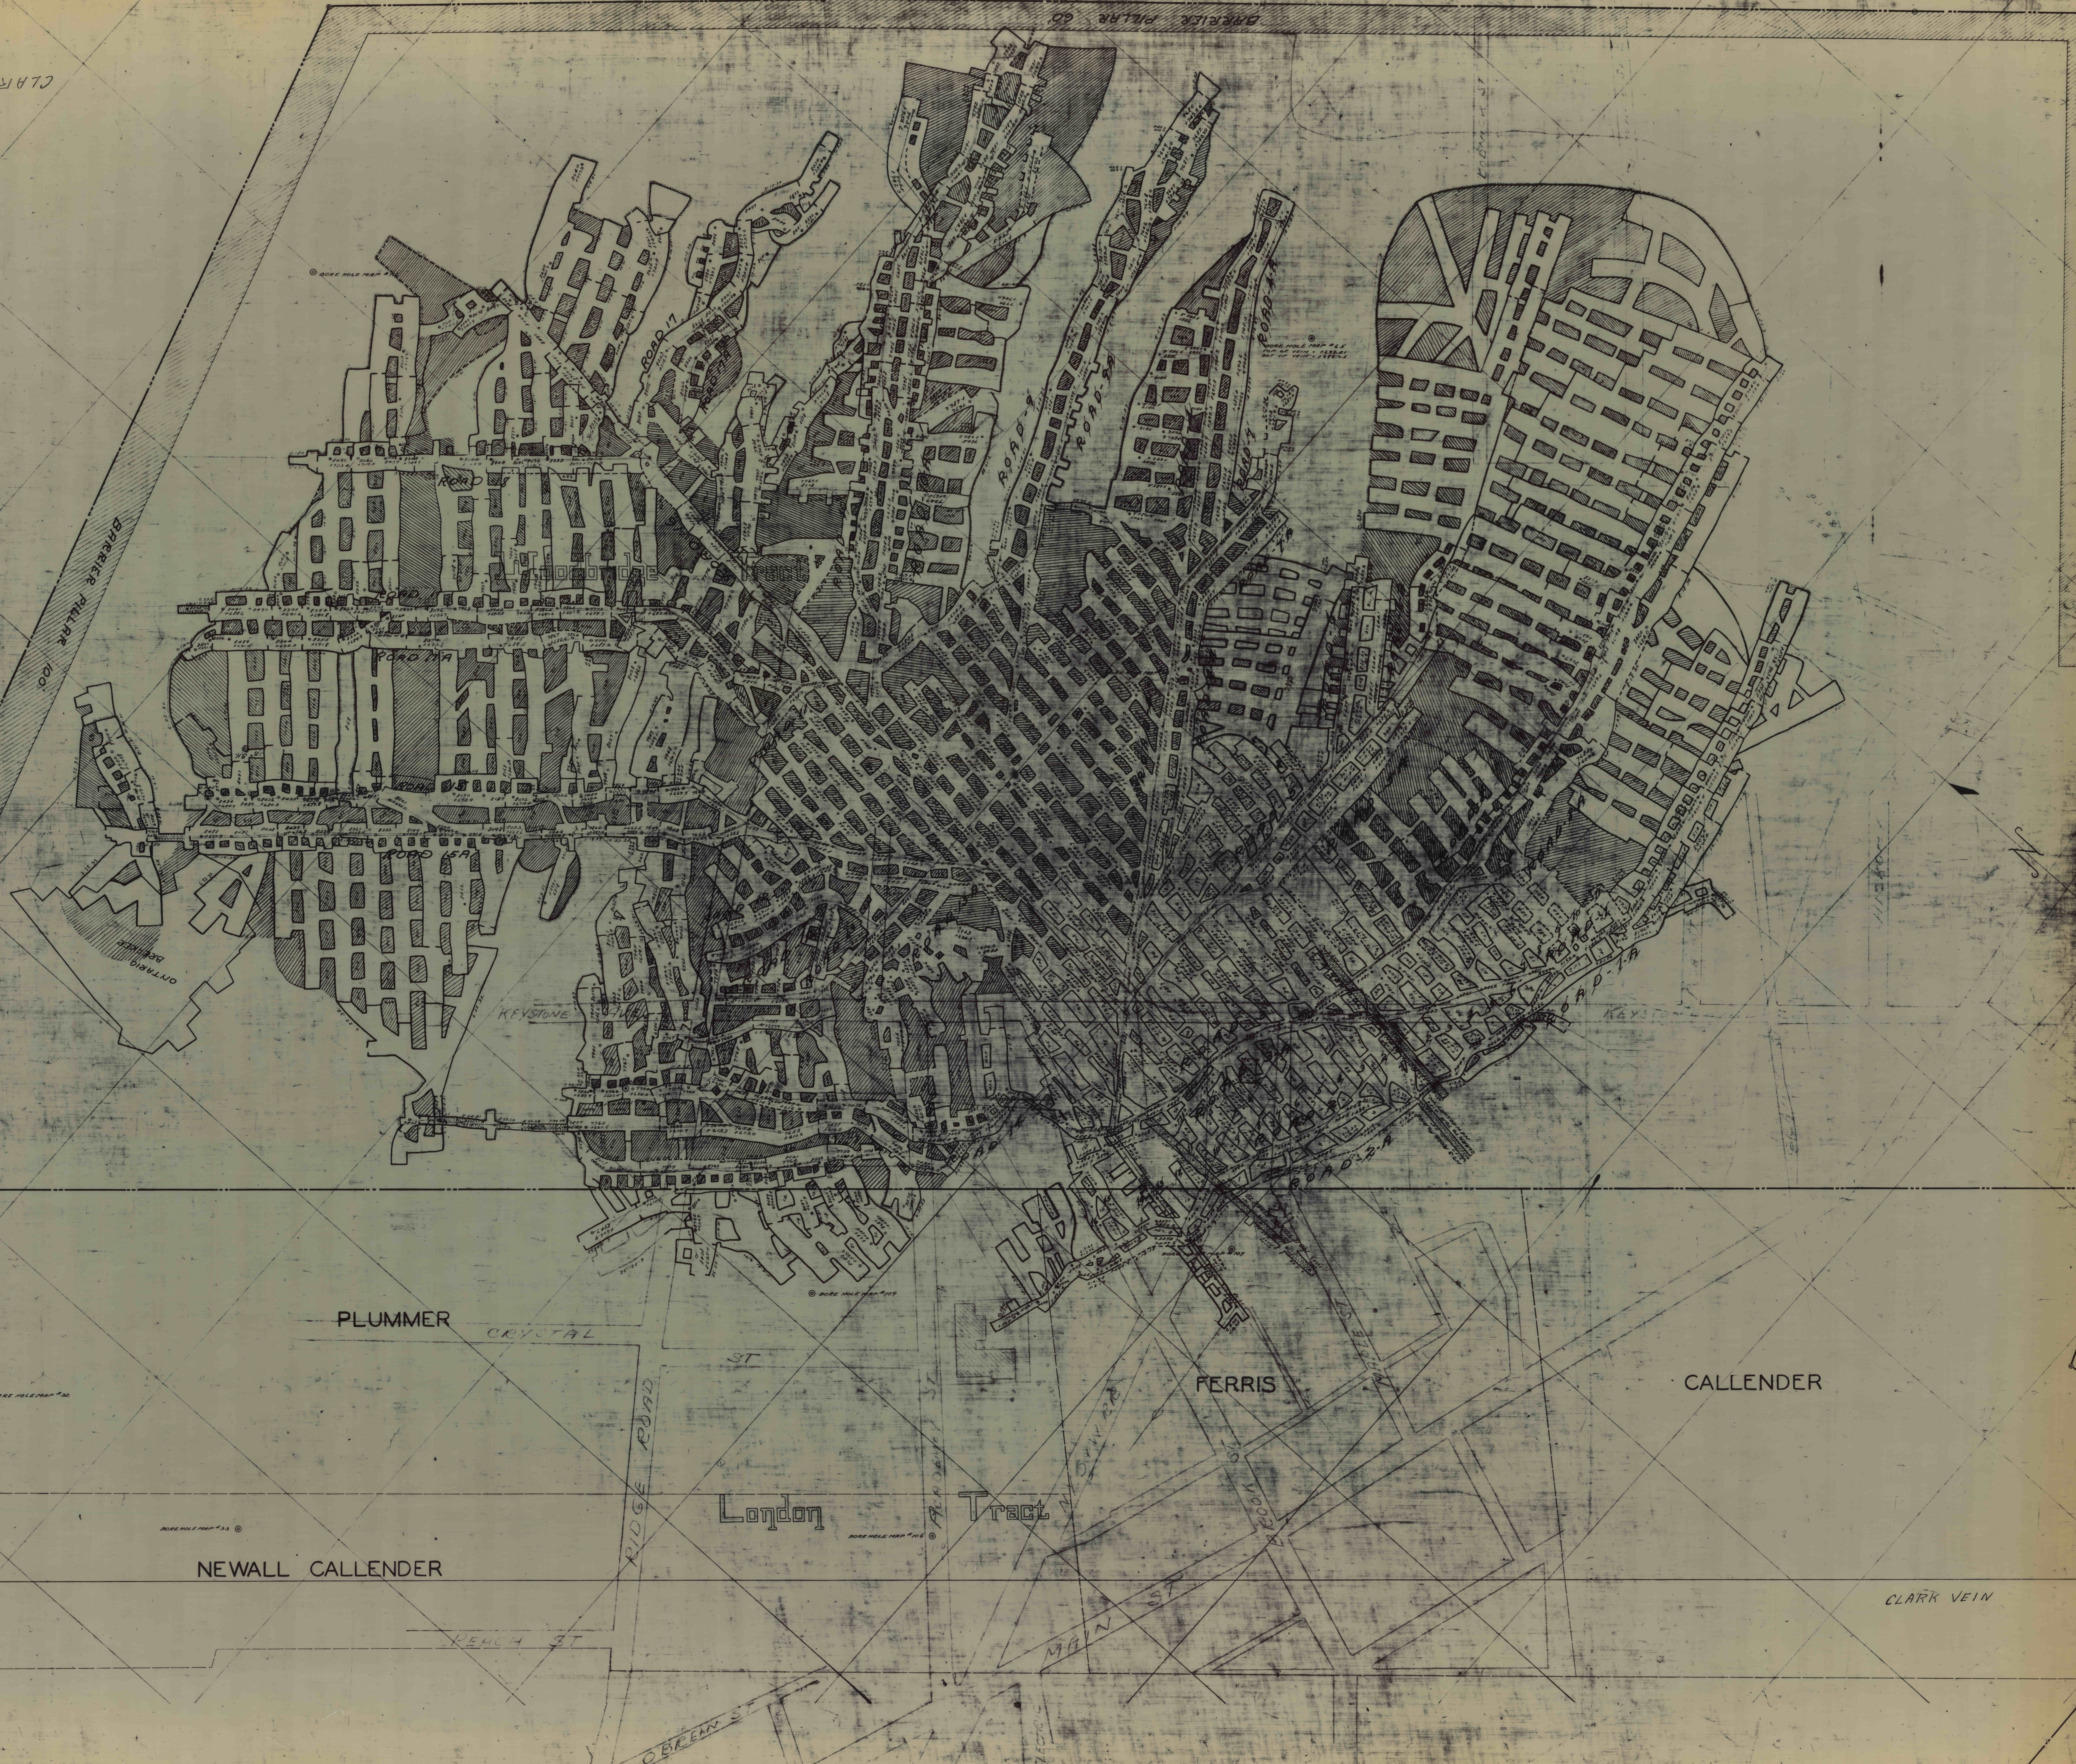

PLUMMER

CRYSTAL

ST

FERRIS

CALLENDER

London

Tract

NEWALL CALLENDER

CLARK VEIN

LACKAWANNA CLARK VEIN

CLARK VEIN