


BOT NEW COUNTY VEIN

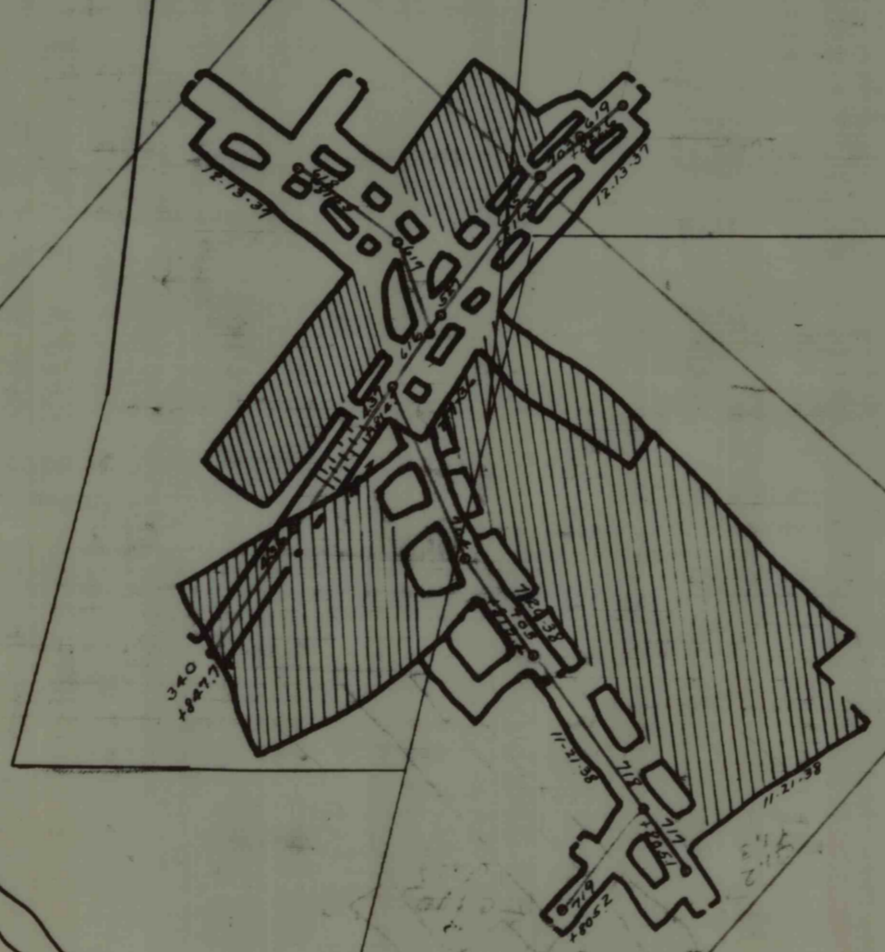

BORE HOLE NO. 105
BORE HOLE NO. 106
BORE HOLE NO. 107

NEW ANTHRACITE COLLIERIES COMPANY
OCT. 31, 1938
AND
CANCELED JULY 28, 1937

RIDGE ROAD

ACADEMY ST.

KEYSTONE AVE.

YOOB ST.

MAPLE ST.

BOT. NEW COUNTY VEIN

MINE

T