


PIERCE LAW & WINTON TRACT

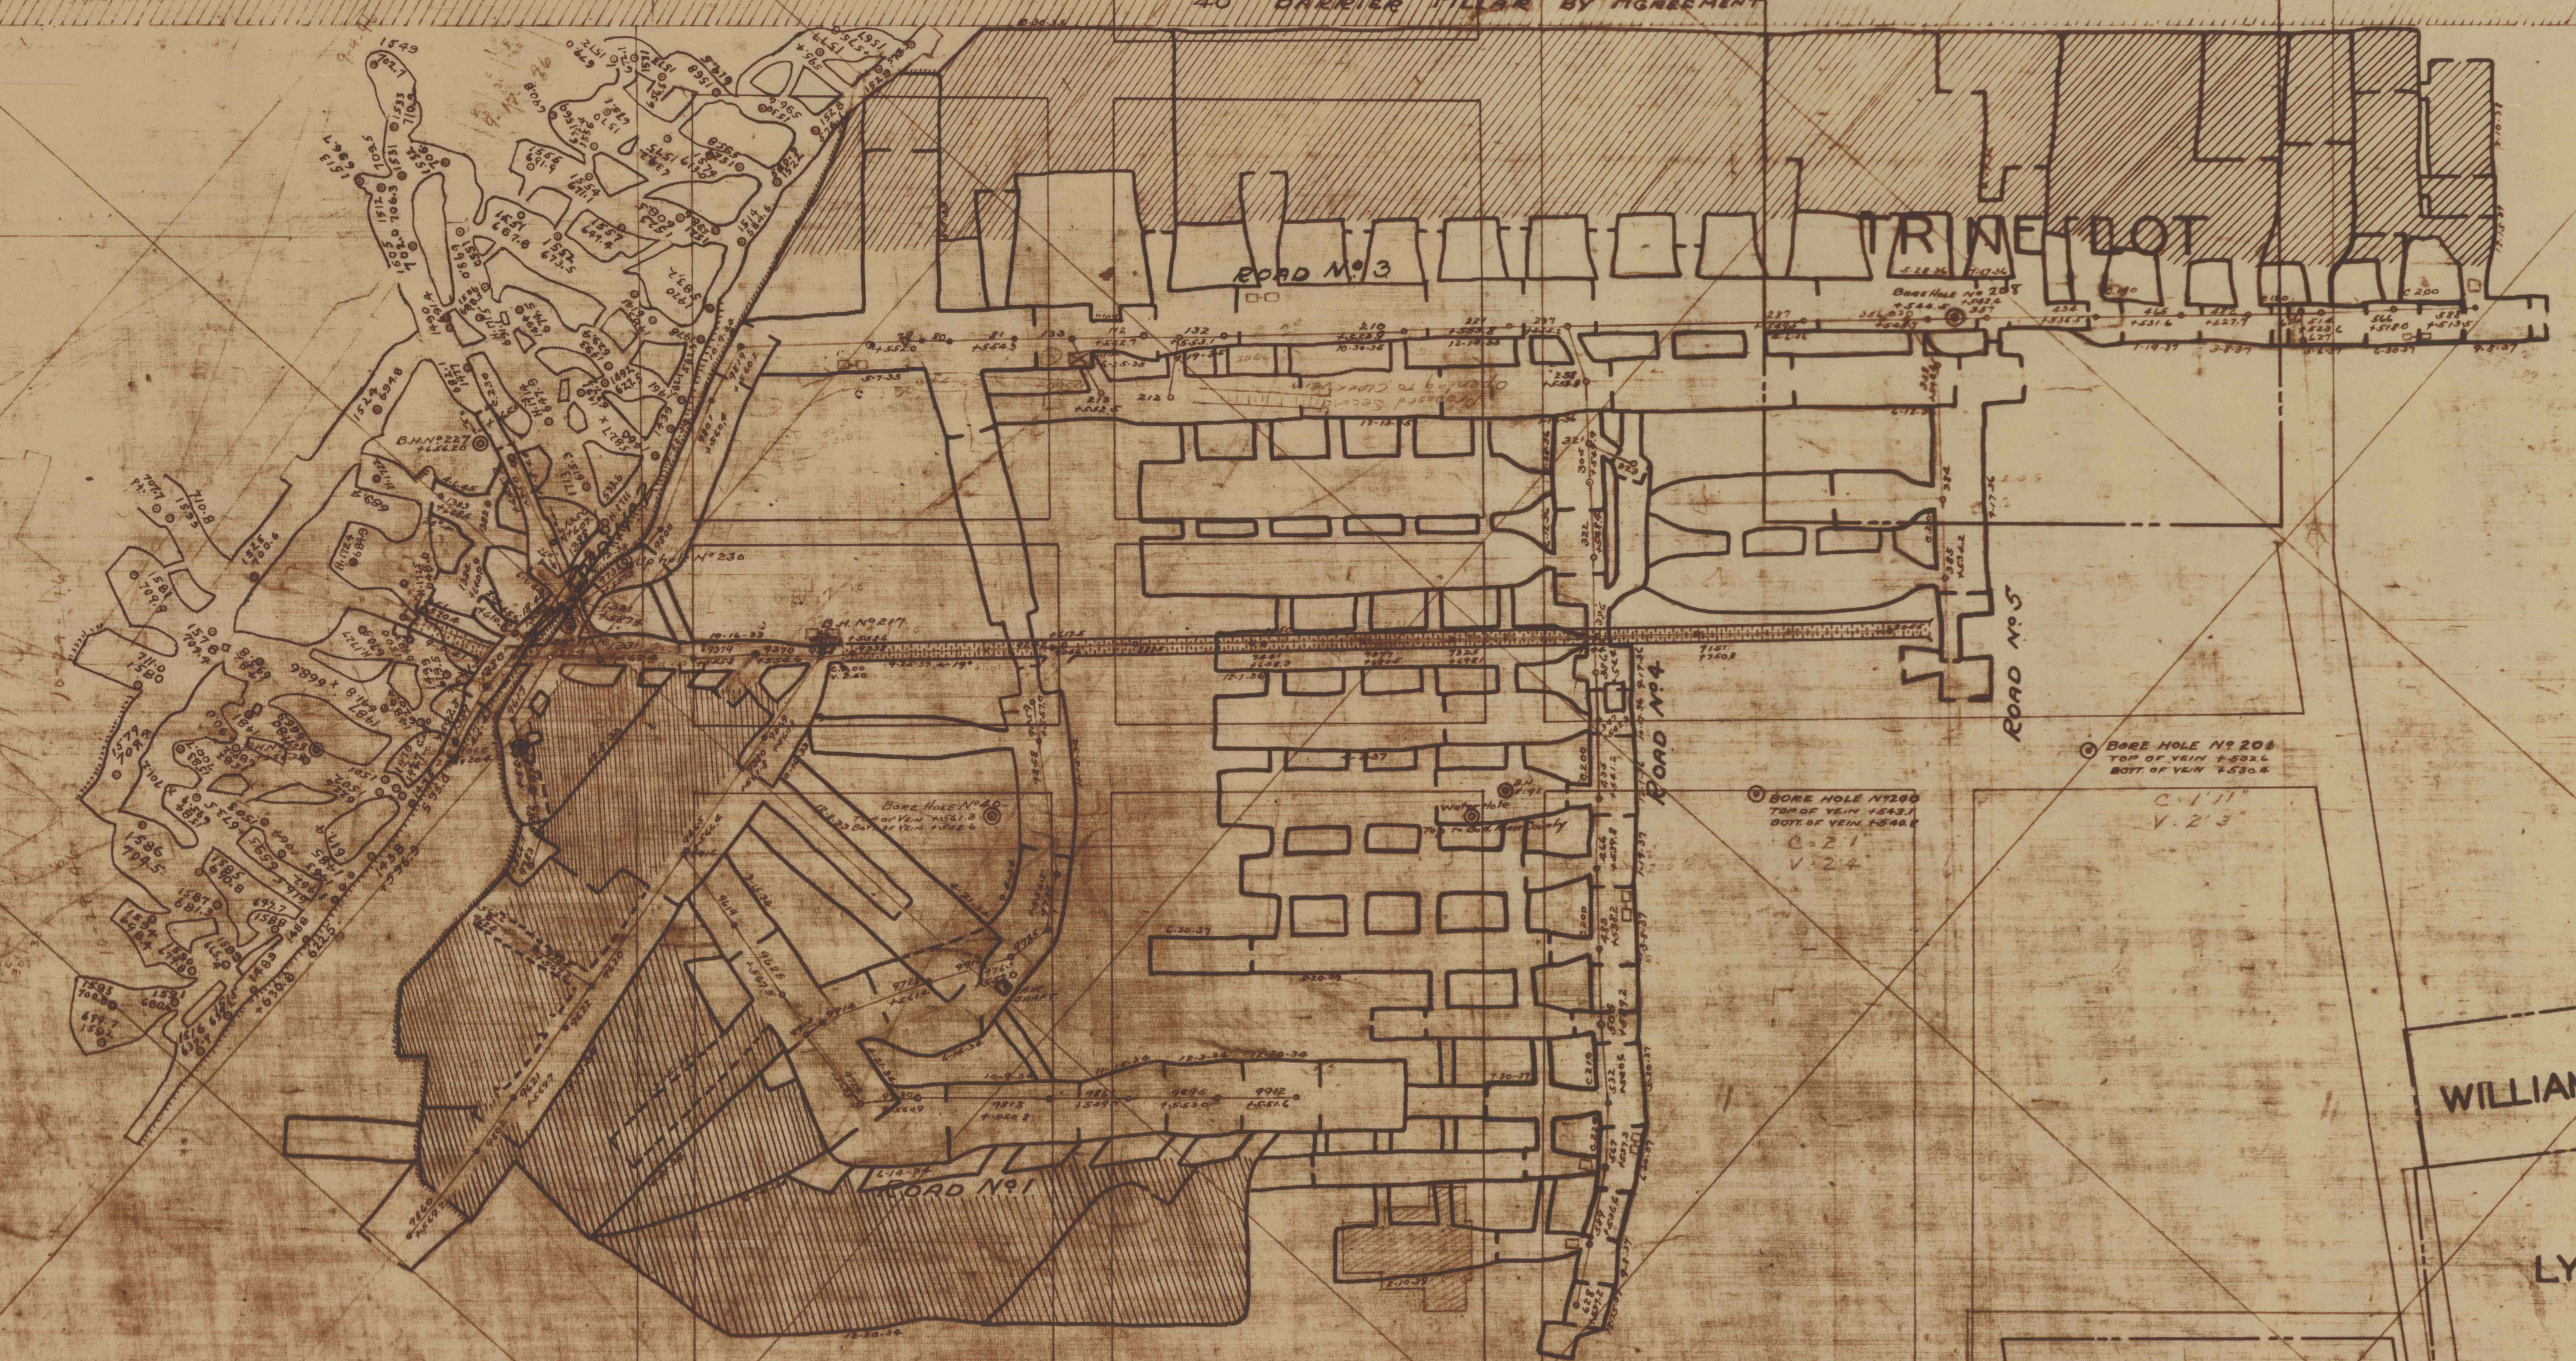

40' BARRIER PILE BY AGREEMENT

ROAD No 3

TRINE LOT

ROAD No 5

ROAD No 1

40' BARRIER PILE BY AGREEMENT

BERRY

GILL

MILLS LOT  
DON'T MINE  
ROAD, ETC.

POWELL

WILLIAMS LOT

LYONS LOT

HAINES LOT

Bore Hole No 223  
Surf 4774.72  
Top of vein 4824.1  
Bot of vein 4812.2



