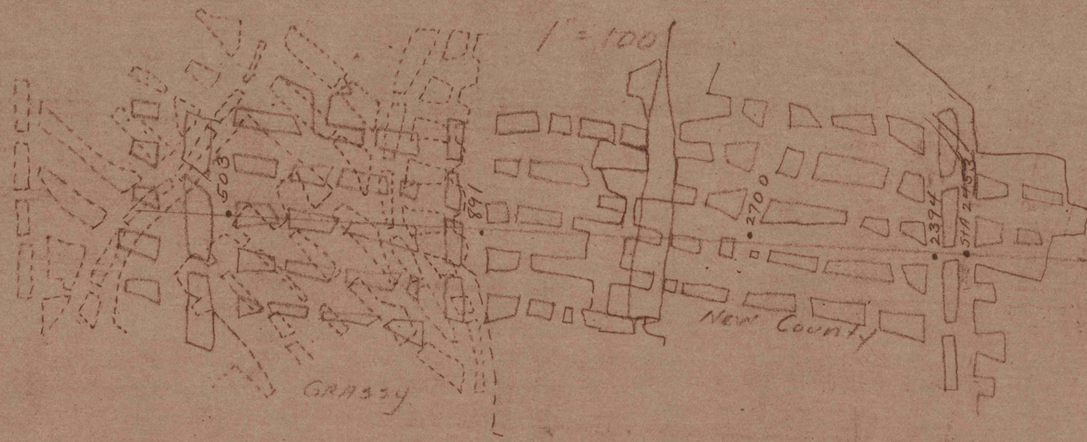


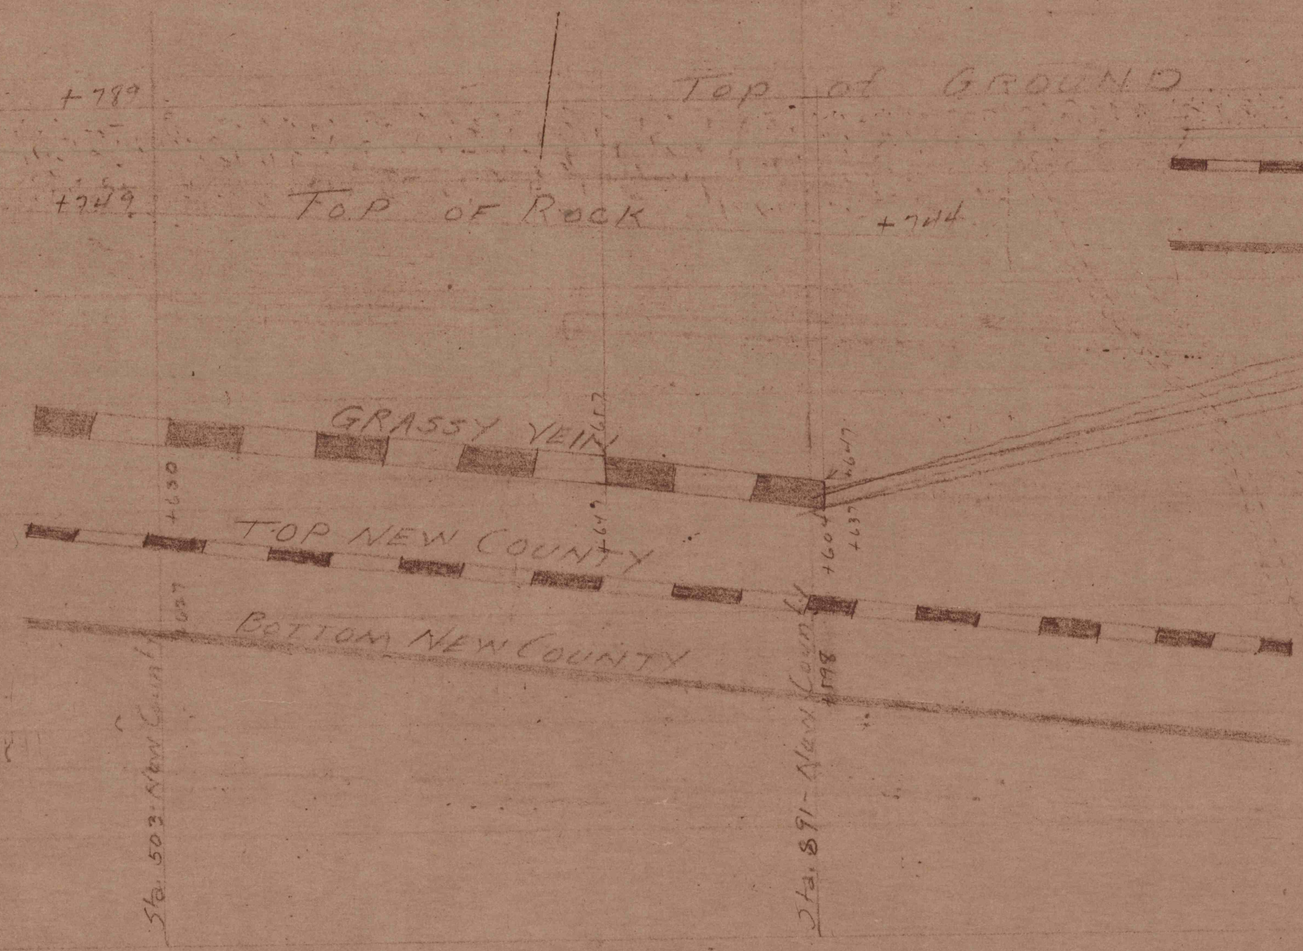


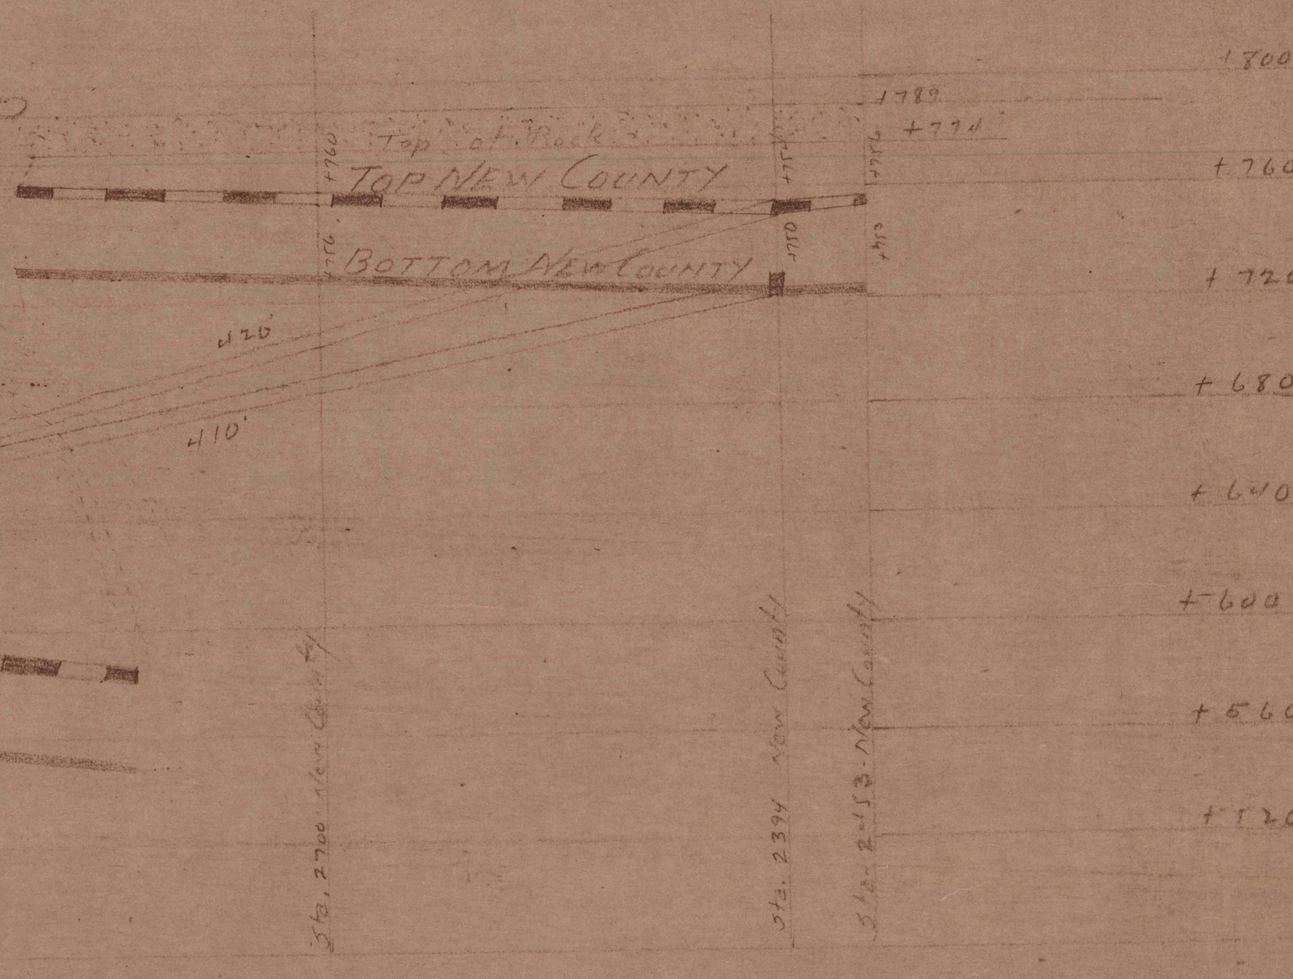


# CROSS SECTION
## GRASSY & NEW COUNTY VEINS
## LACKAWANNA COLLIERY
Scale 1" = 40'