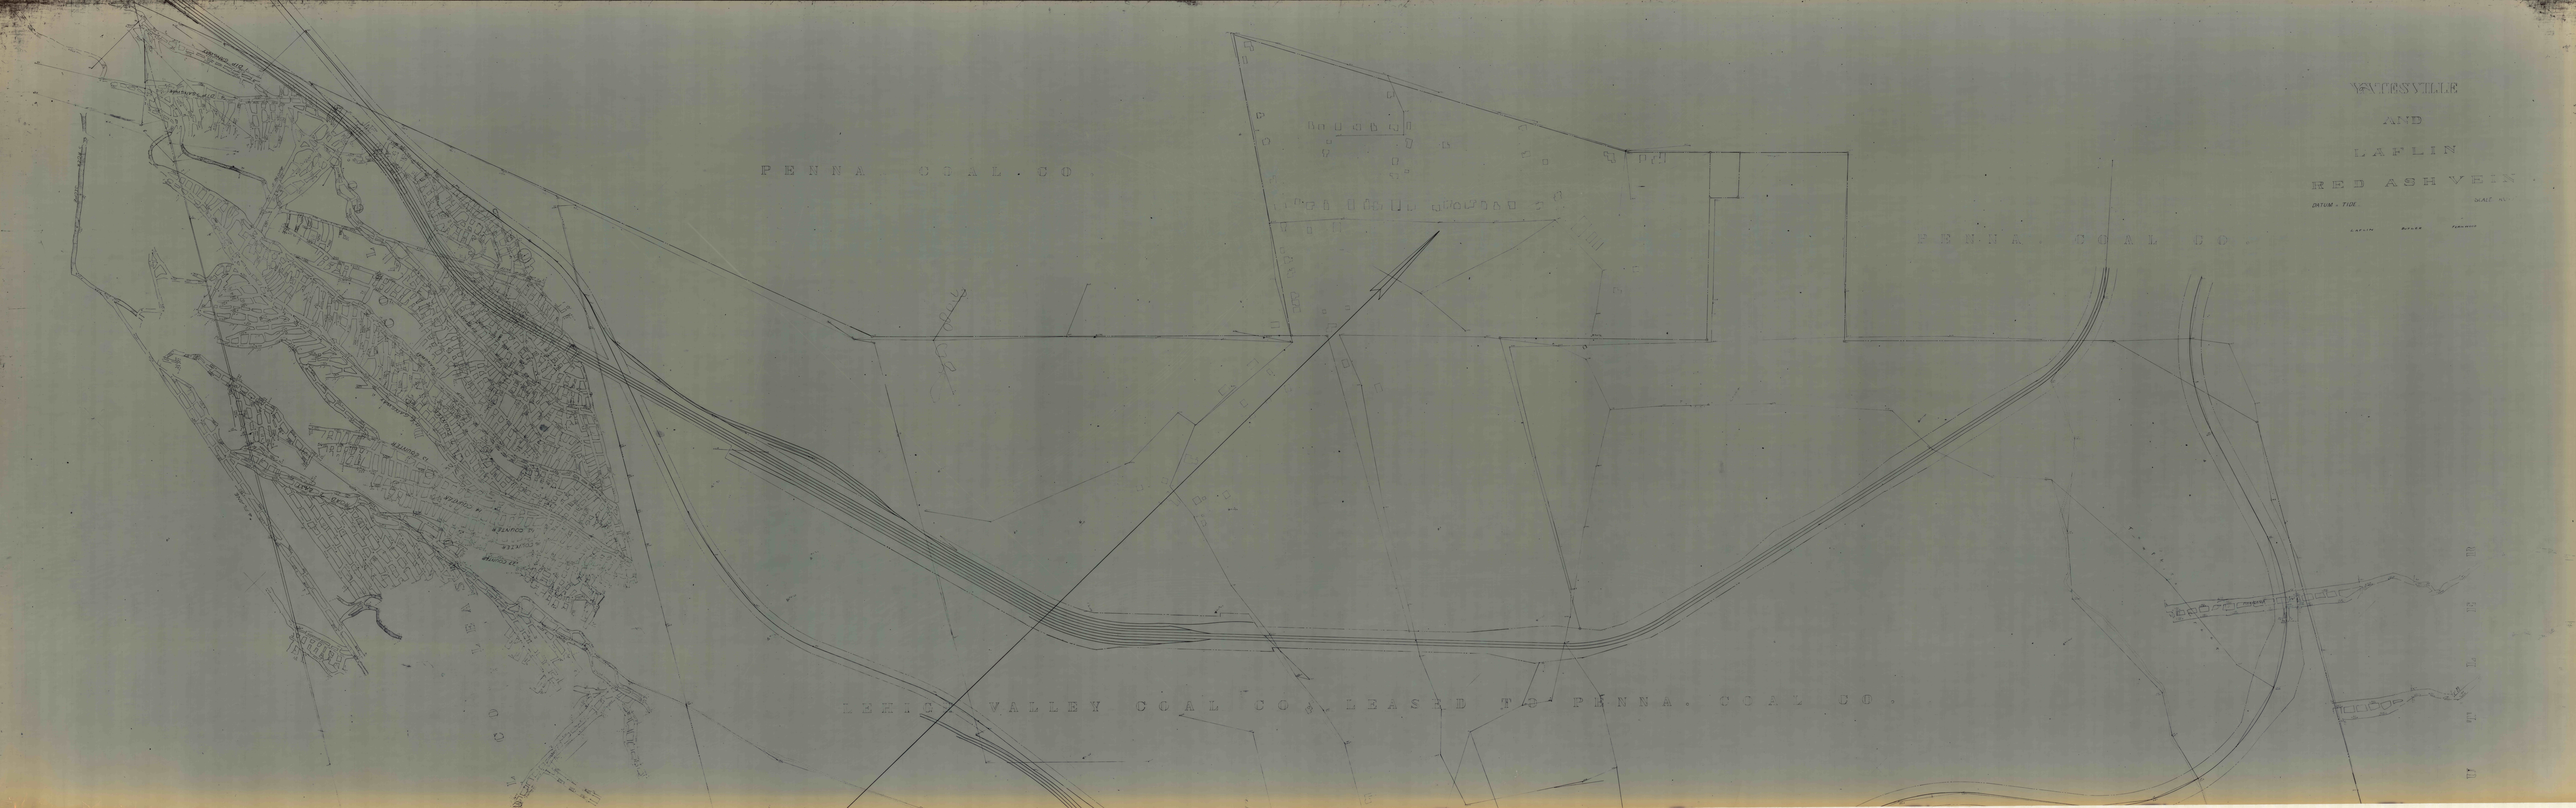
YATESVILLE
AND
LAFLIN
RED ASH VEIN
DATUM - TIDE
SCALE
LAFLIN
BUCKS
PENNSYLVANIA
PENNA. COAL CO.
PENNA. COAL CO.
LEHIGH VALLEY COAL CO. LEASED TO PENNA. COAL CO.