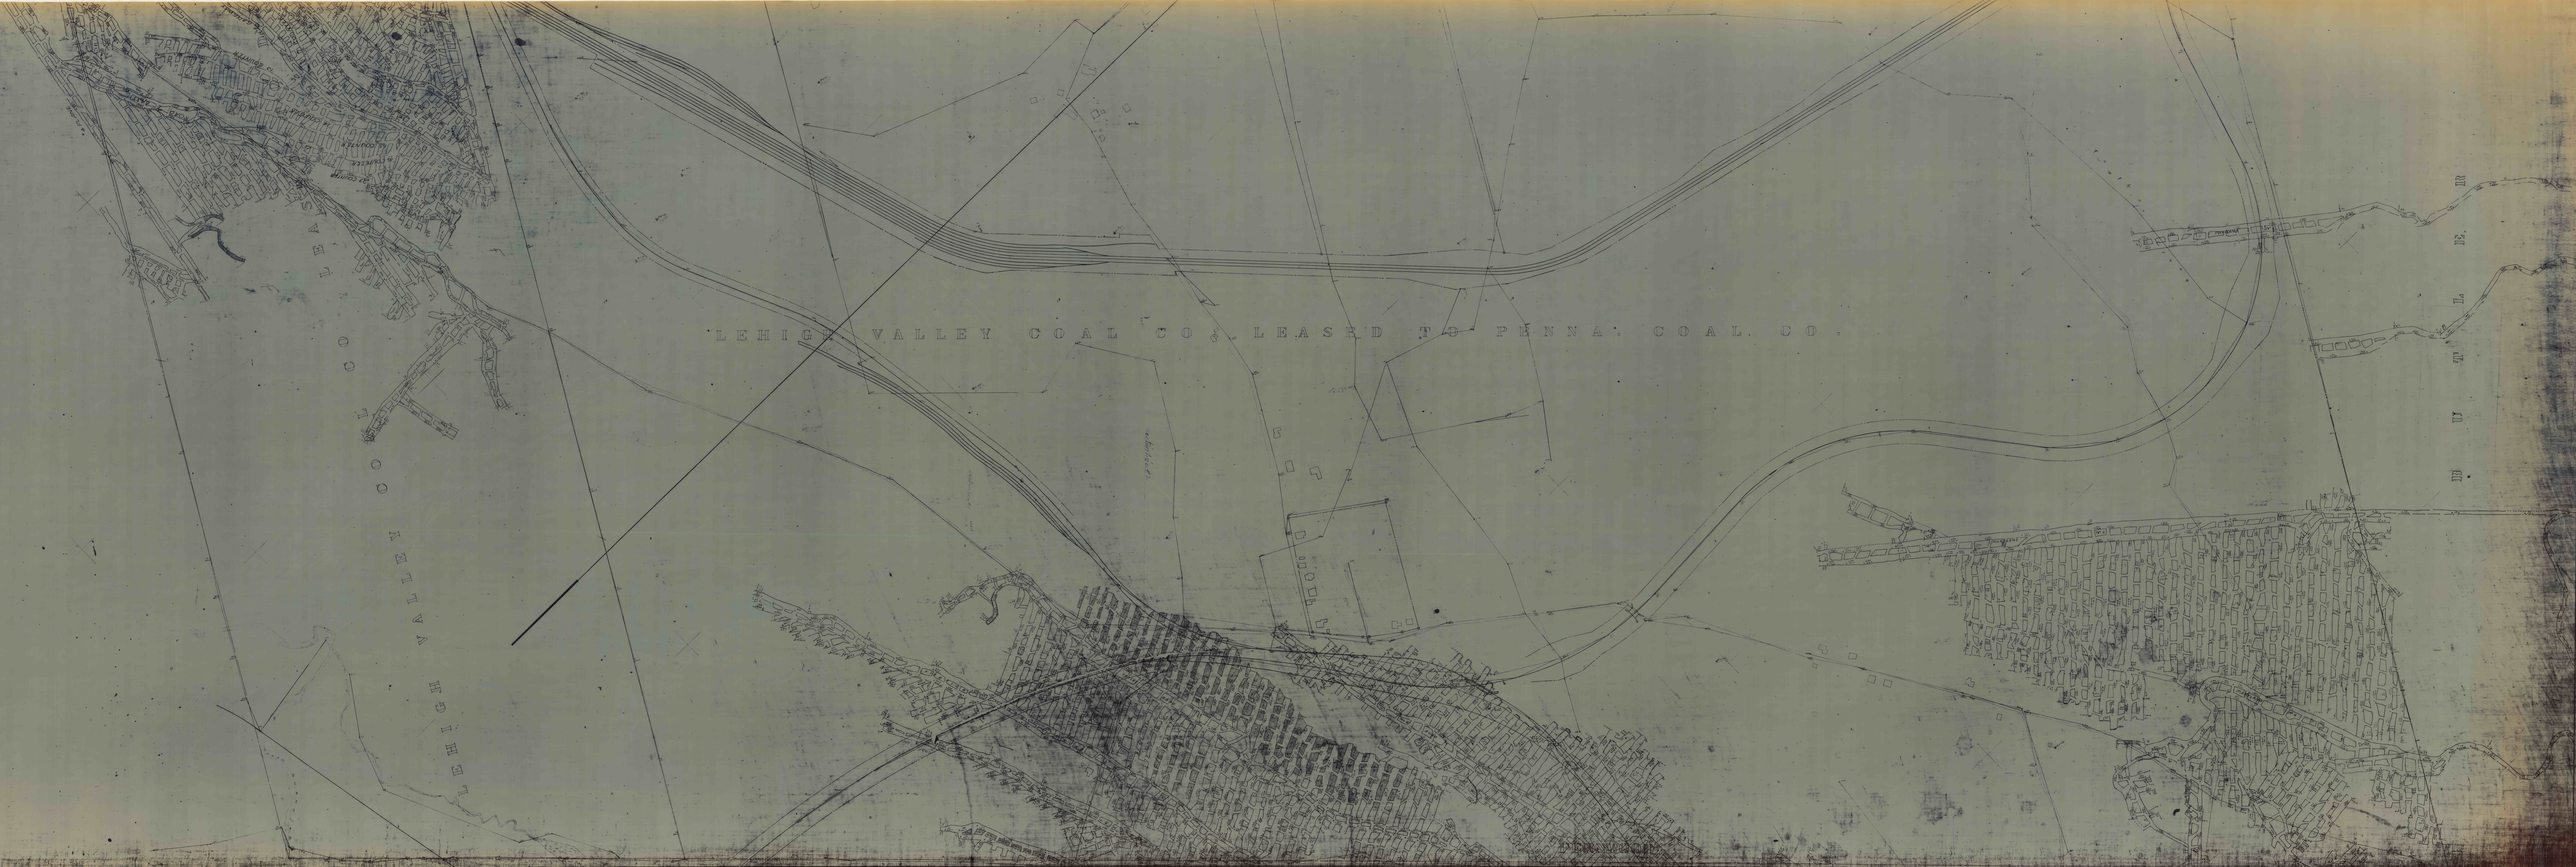
LEHIGH VALLEY COAL CO. LEASED TO PENNA. COAL CO.
LEHIGH VALLEY COAL CO.
BUTTE