


CO.

COAL

PENNA

LEHIGH VALLEY COAL COMPANY

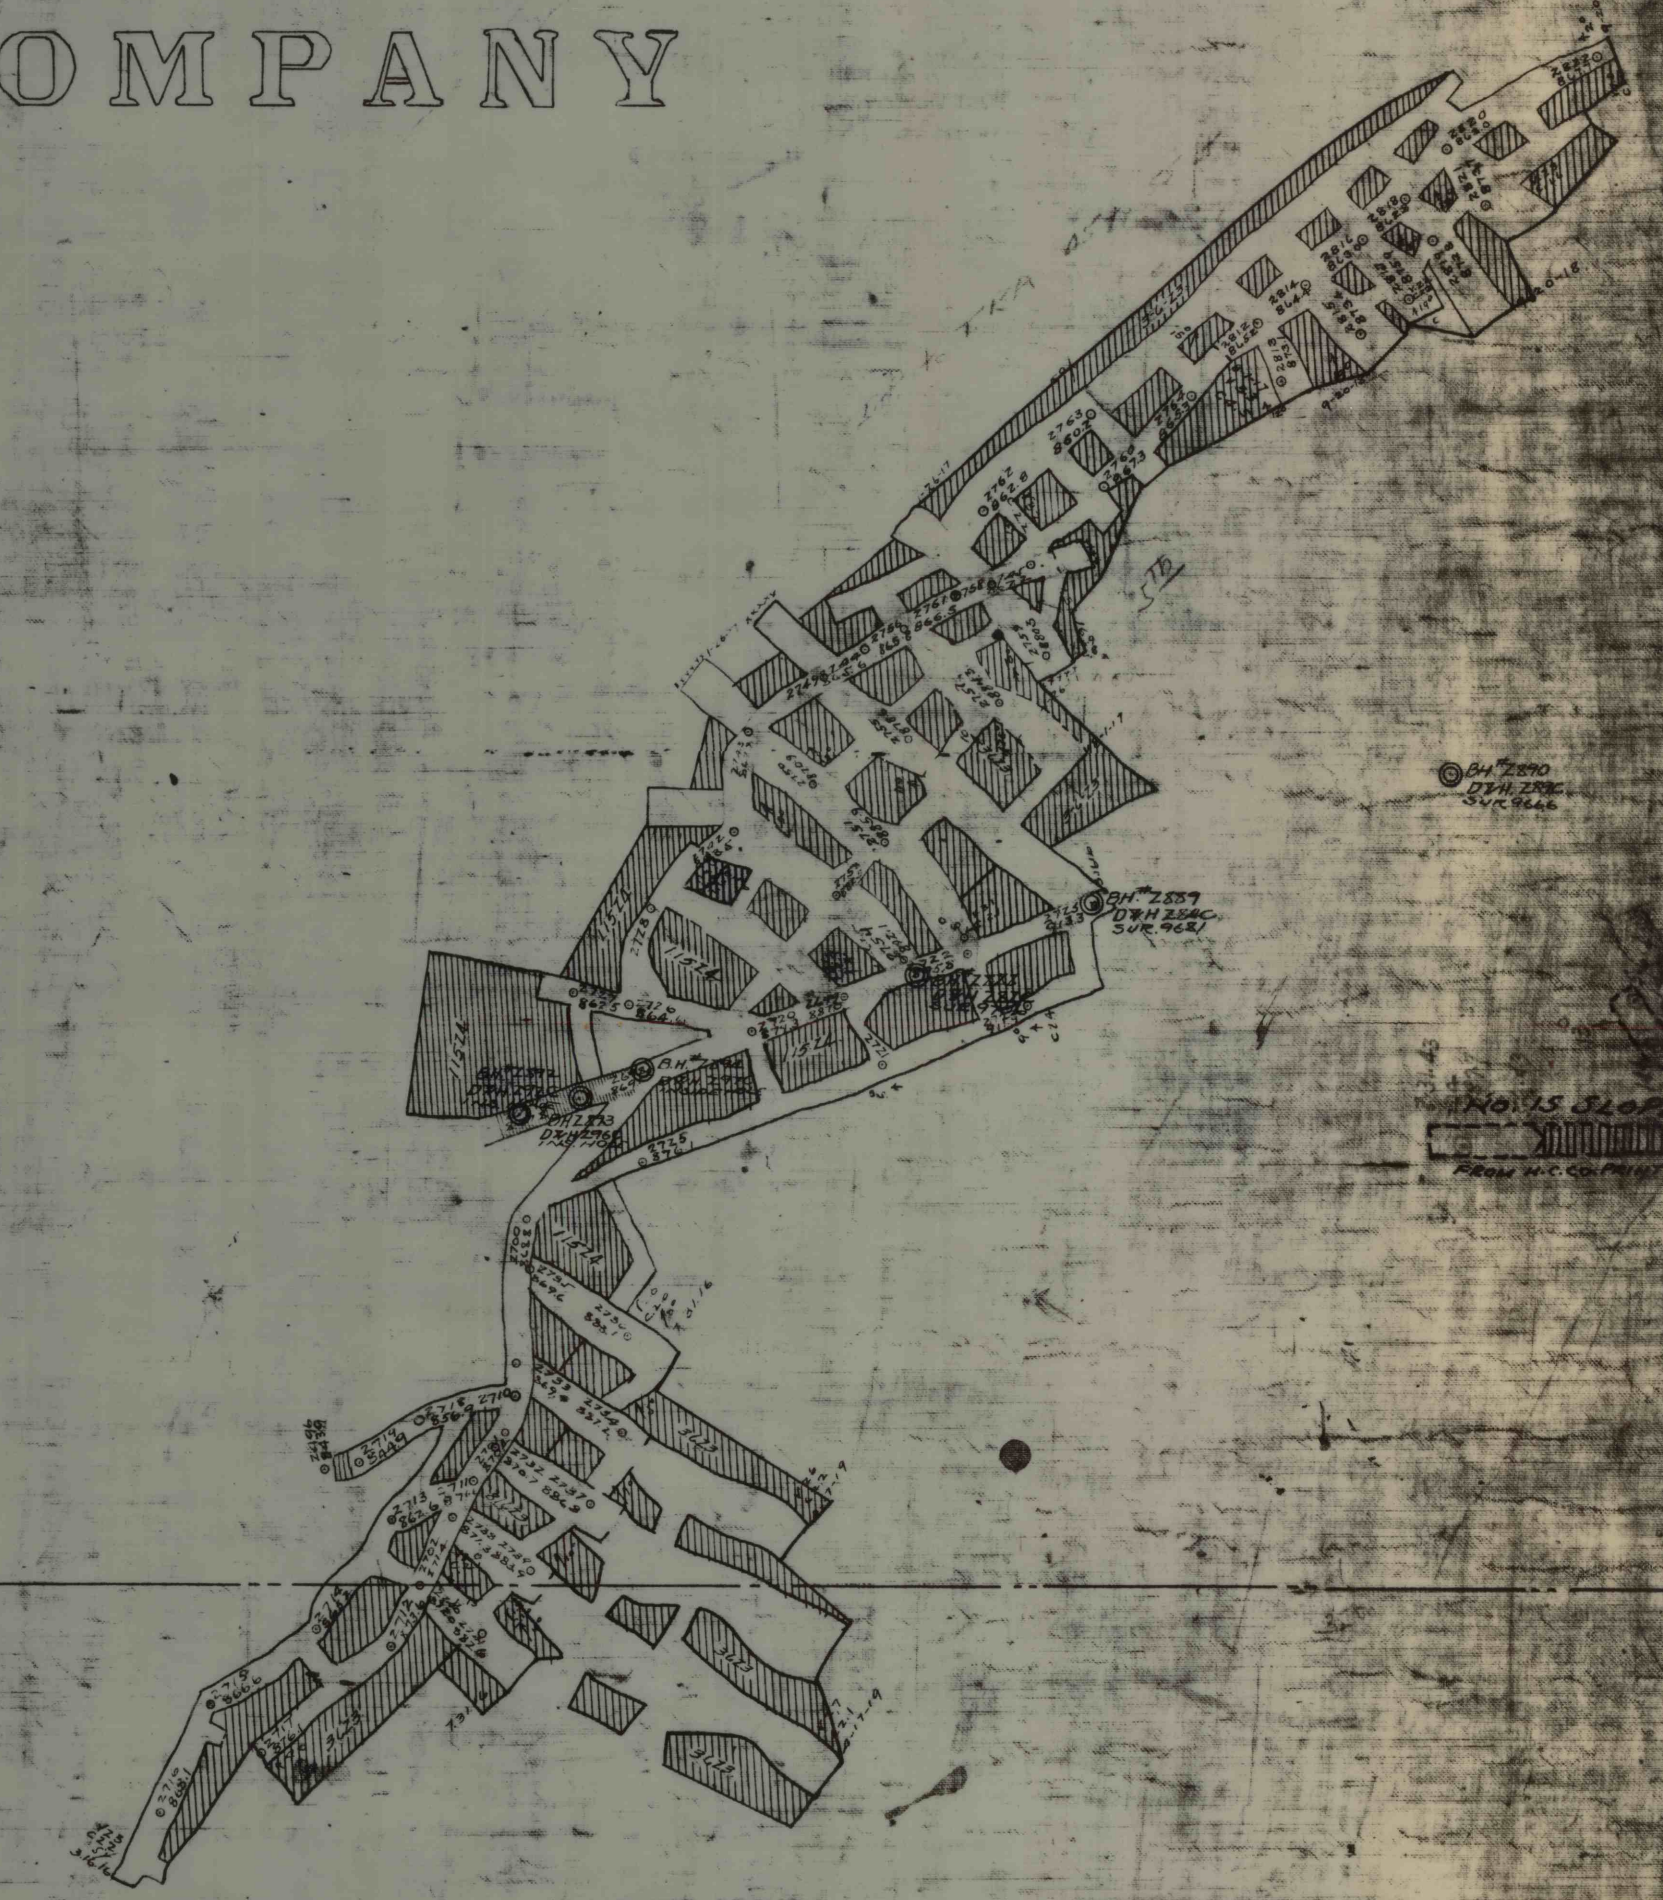

LAF LIN
MIDDLE RED ASH VEIN