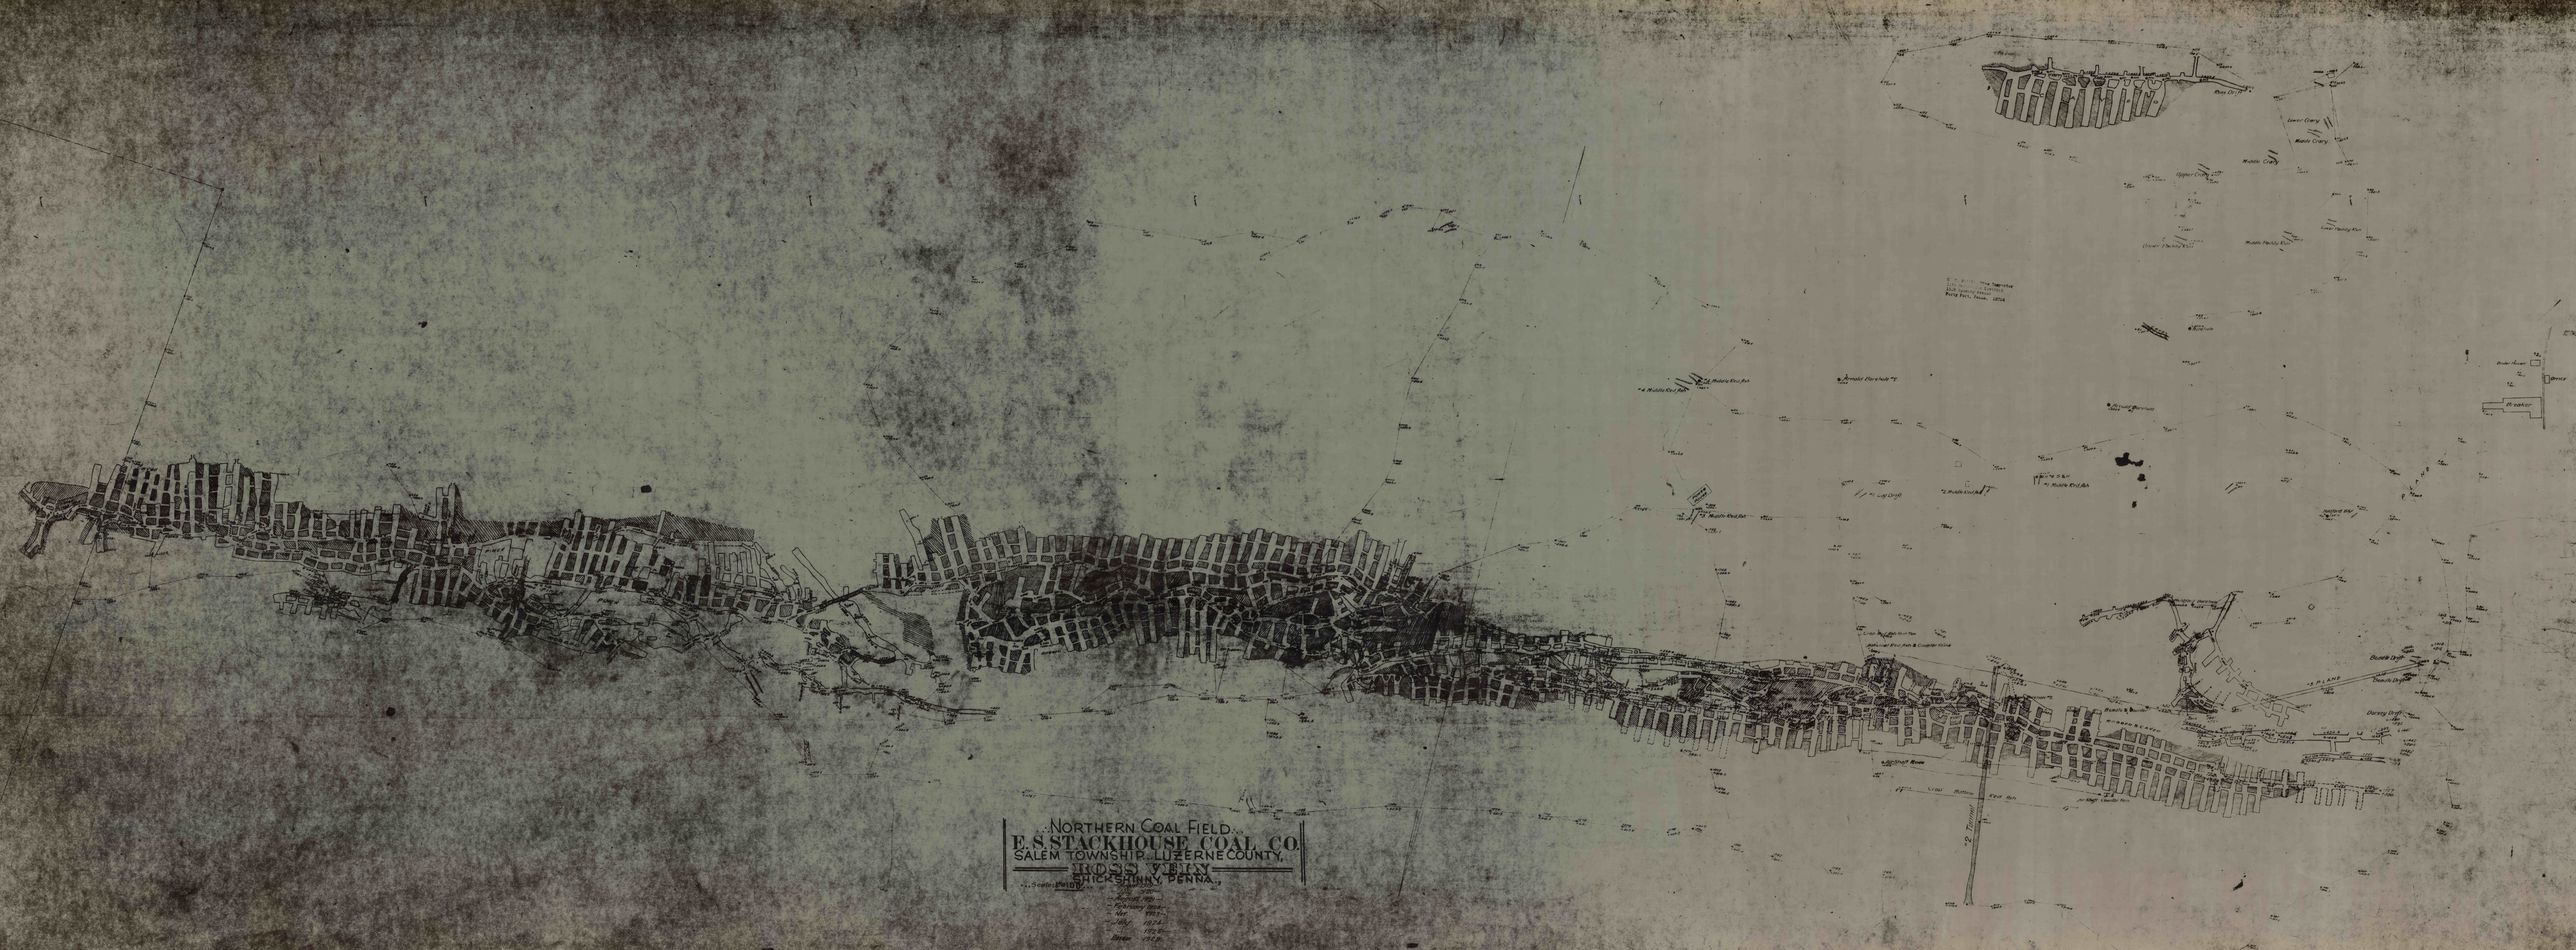
NORTHERN COAL FIELD.
E. S. STACKHOUSE COAL CO.
SALEM TOWNSHIP, LUZERNE COUNTY.
