


PENNSYLVANIA COAL CO.
No 14 - Marcy

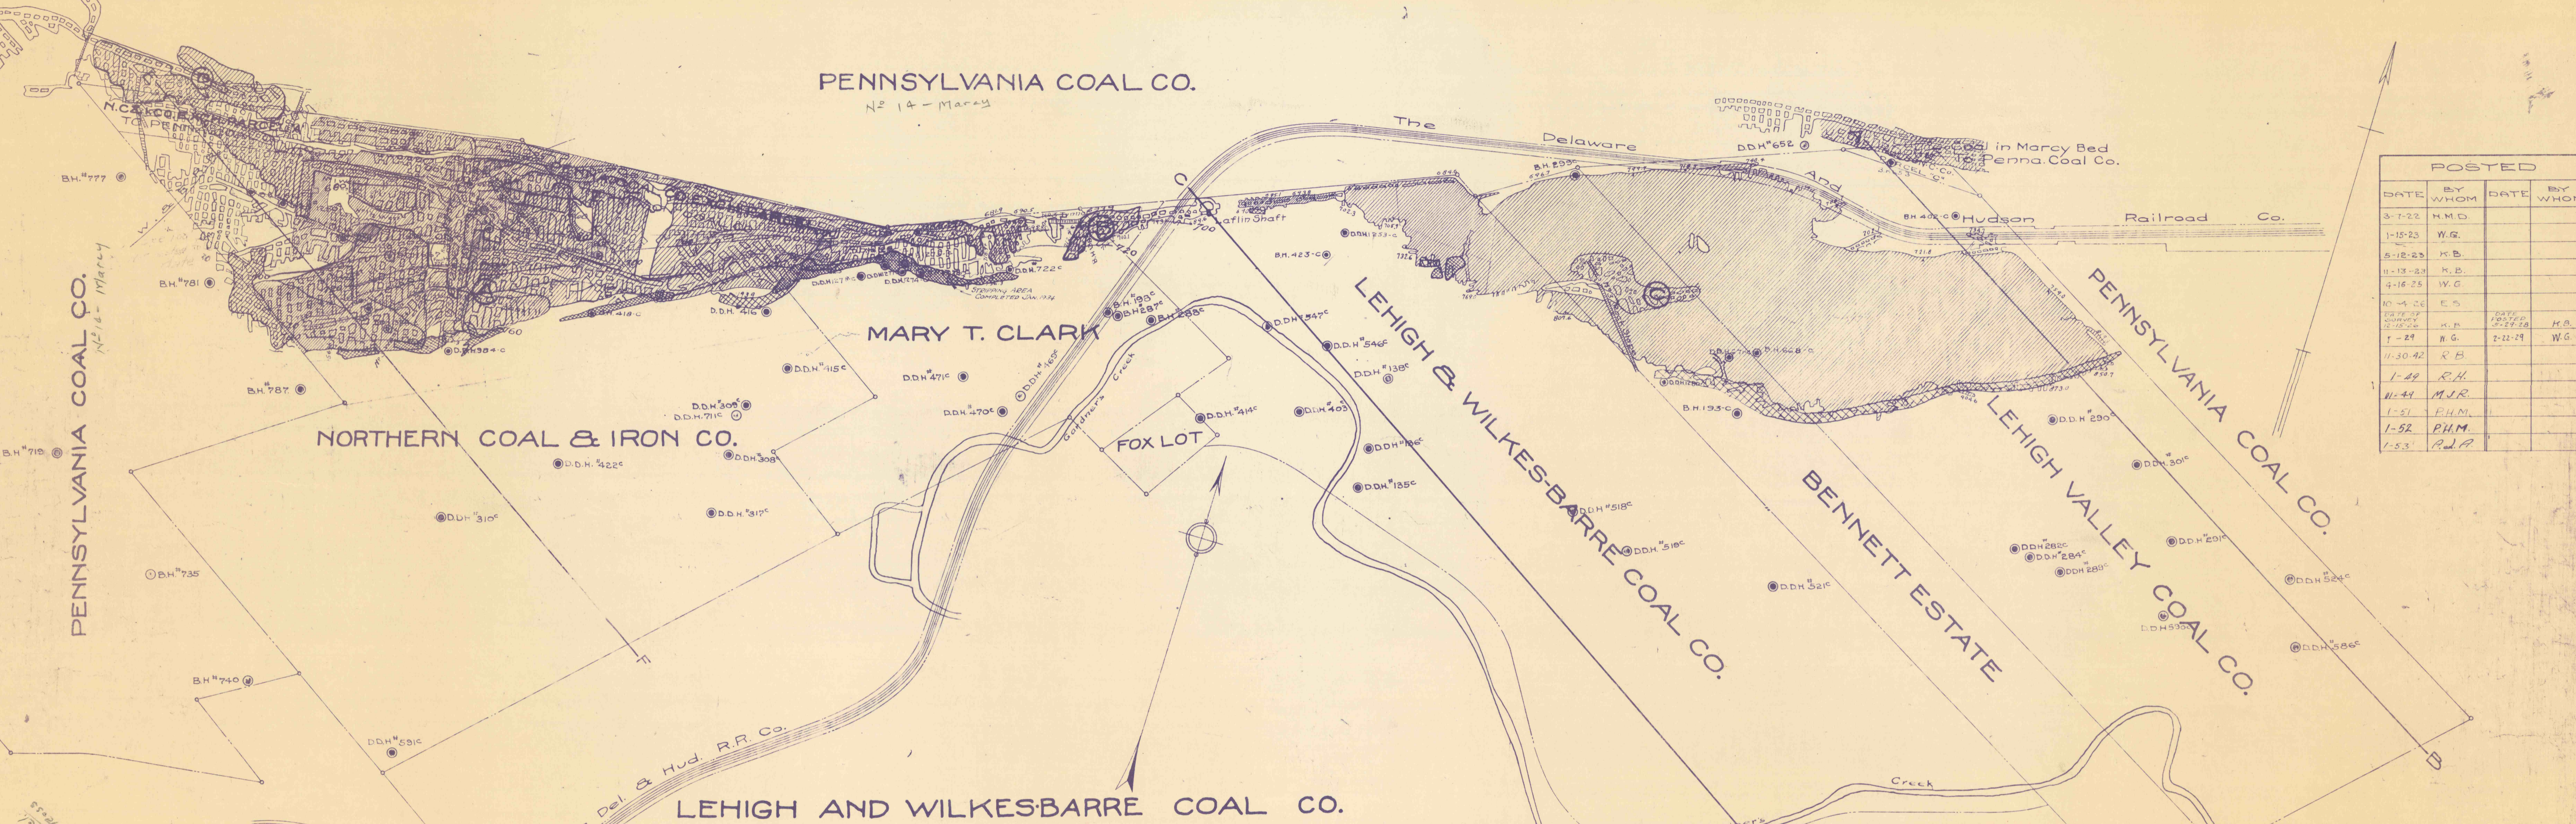


POSTED			
DATE	BY WHOM	DATE	BY WHOM
3-7-22	H.M.D.		
1-15-23	W.G.		
5-12-23	K.B.		
11-13-23	K.B.		
4-16-25	W.G.		
10-4-26	E.S.		
DATE OF SURVEY	BY WHOM	DATE POSTED	BY WHOM
12-15-26	K.B.	3-27-28	K.B.
7-29	H.G.	2-22-29	W.G.
11-30-42	R.B.		
1-44	R.H.		
11-49	M.J.R.		
1-51	P.H.M.		
1-52	P.H.M.		
1-53	A.L.A.		

NORTHERN COAL & IRON CO.

BORE HOLE DATA

B.H.No	Size	Elev. of Top	Depth	From	To	B.H.No	Size	Elev. of Top	Depth	From	To	B.H.No	Size	Elev. of Top	Depth	From	To	B.H.No	Size	Elev. of Top	Depth	From	To	B.H.No	Size	Elev. of Top	Depth	From	To				
135	6"	738.57	75'	Sur	B.R.A.	309	1 1/2"	809.11	247'	Sur	B.R.A.	519	1 1/2"	934.23	244'	Sur	B.R.A.	671	3"	897.25	196'	Sur	TSRA	1280	2"	856.43	111'	Sur	Marcy				
136	6"	769.11	69'	5"	Sur	B.R.A.	310	1 1/2"	837.93	291'	Sur	B.R.A.	521	1 1/2"	1002.14	260'	Sur	B.R.A.	711	2"	811.02	91'	Sur	TSRA	1324	3"	604.16	131.4'	Sur	Marcy TBTRA			
138	6"	782.00	62'	0"	Sur	B.R.A.	317	1 1/2"	869.25	228'	Sur	B.R.A.	524	1 1/2"	1000.43	191'	Sur	B.R.A.	712	2"	790.6	280'	Sur	B.R.A.	1387	3"	673.23	81.0'	Sur	Marcy 3FT			
193	6"	919.51	203'	0"	Sur	B.R.A.	402	1 1/2"	849.55	338'	Sur	B.R.A.	546	2"	721.77	388'	Sur	TSRA	725	2"	755.25	171'	Sur	Marcy	1388	3"	745.19	79.6'	Sur	Marcy 3FT			
198	6"	721.89	120'	0"	Sur	B.R.A.	403	1 1/2"	727.43	81'	3"	Sur	B.R.A.	547	2"	715.45	52'	3"	Sur	TSRA	985	2"	801.49	129'	Sur	3FT	1389	3"	694.03	65'	0"	Sur	Marcy 3FT
232	1 1/2"	850.07	180'	0"	Sur	B.R.A.	414	1 1/2"	723.67	40'	0"	Sur	B.R.A.	586	2"	951.8	128'	0"	Sur	B.R.A.	1233	2"	724.28	15'	0"	Sur	3FT						
284	1 1/2"	948.12	108'	0"	Sur	B.R.A.	415	1 1/2"	783.72	75'	0"	Sur	Marcy	590	2"	926.66	43'	0"	Sur	B.R.A.	1250	3"	761.65	34'	0"	Sur	Marcy						
287	6"	721.89	124'	0"	Sur	B.R.A.	416	1 1/2"	782.51	143'	0"	Sur	TBTRA	591	2"	754.60	160'	0"	Sur	B.R.A.	1251	3"	806.04	65'	0"	Sur	Marcy						
288	6"	708.63	103'	6"	Sur	B.R.A.	418	1 1/2"	800.91	154'	4"	Sur	3FT	645	3"	684.09	161'	0"	TBTRA	Marcy	1253	2"	738.77	30'	0"	Sur	Marcy						
289	1 1/2"	946.06	134'	6"	Sur	B.R.A.	422	1 1/2"	832.59	175'	1"	Sur	B.R.A.	652	2"	808.21	125'	0"	Sur	Marcy	1274	2"	732.70	24'	6"	Sur	Marcy						
290	1 1/2"	928.08	261'	0"	Sur	B.R.A.	423	1 1/2"	739.74	41'	0"	Sur	3FT	653	2"	840.70	56'	6"	Sur	Marcy	1275	2"	733.85	20'	0"	Sur	Marcy						
291	1 1/2"	976.13	168'	6"	Sur	B.R.A.	469	1 1/2"	706.23	140'	0"	Sur	B.R.A.	660	2"	750.45	92'	0"	Sur	Marcy	1276	2"	730.70	21'	5"	Sur	Marcy						
292	6"	751.31	235'	0"	Sur	B.R.A.	470	1 1/2"	703.67	93'	0"	Sur	B.R.A.	661	2"	740.2	90'	6"	Sur	Marcy	1277	2"	729.94	16'	1"	Sur	Marcy						
301	1 1/2"	950.16	192'	6"	Sur	B.R.A.	471	1 1/2"	703.31	62'	3"	Sur	B.R.A.	662	2"	782.62	206'	8"	Sur	TBTRA	1278	2"	734.37	15'	1"	Sur	Marcy						
308	1 1/2"	837.74	270'	0"	Sur	B.R.A.	518	1 1/2"	900.8	71'	0"	Sur	TSRA	668	3"	816.59	197'	0"	Sur	TBTRA	1278	2"	733.21	17'	8"	Sur	Marcy						

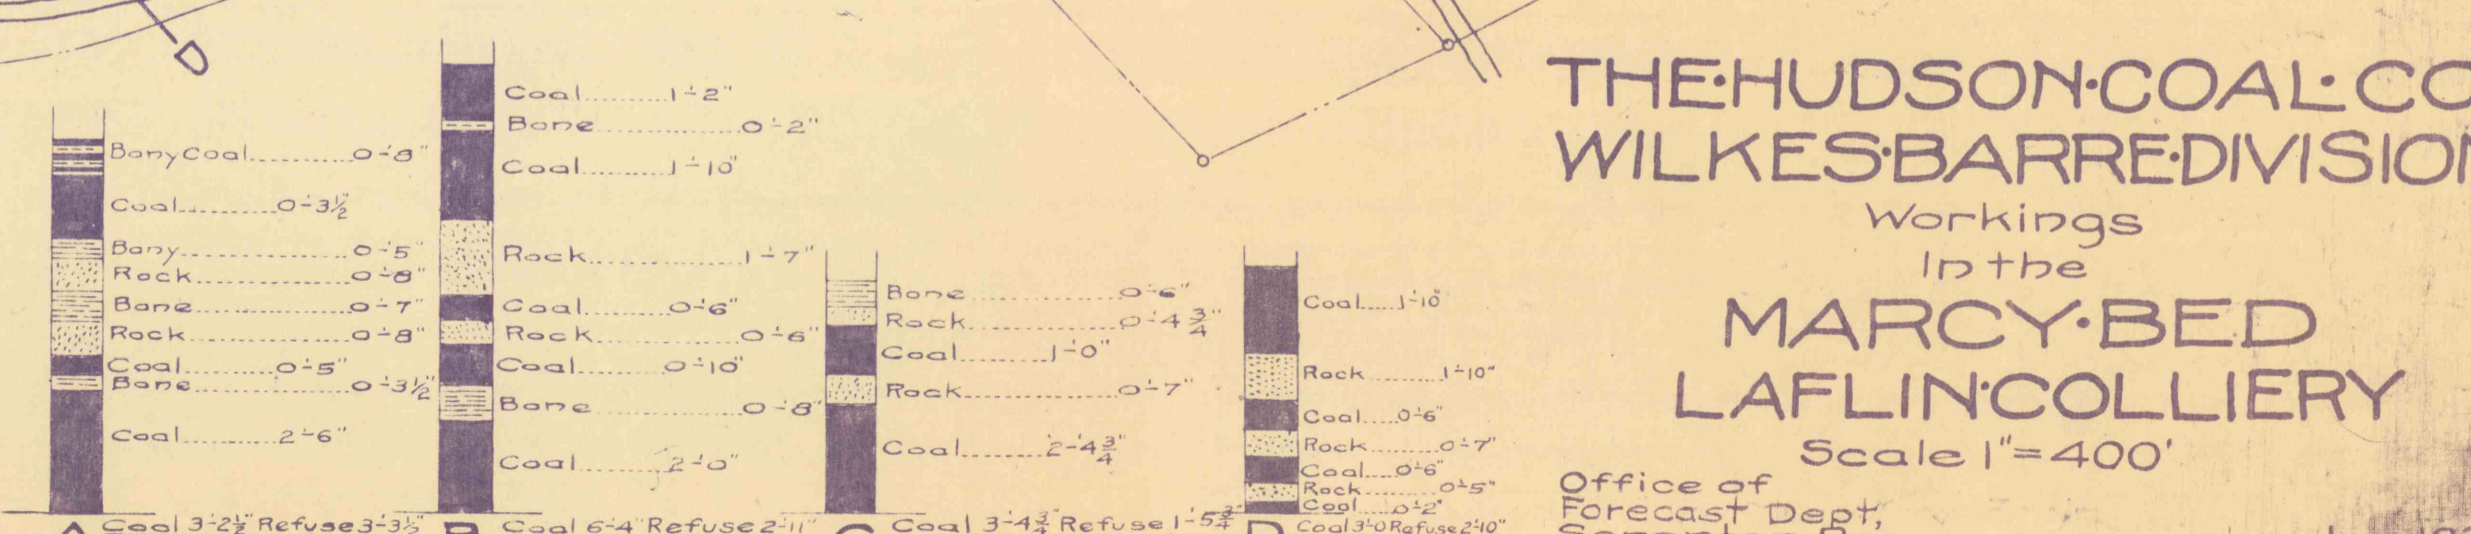

THE HUDSON COAL CO.
WILKES-BARRE DIVISION
Workings
In the
MARCY-BED
LAFLIN COLLIERY
Scale 1"=400'
Office of
Forecast Dept.,
Scranton, Pa.