

PENNSYLVANIA COAL CO.

PENNSYLVANIA COAL CO.

NORTHERN COAL & IRON CO.

MARY CLARK

FOX LOT

LEHIGH & WILKESBARRE COAL CO.

BENNETT ESTATE

LEHIGH VALLEY COAL CO.


PENNSYLVANIA COAL CO.

LEHIGH AND WILKESBARRE COAL CO.

NORTHERN COAL & IRON CO.

BORE HOLE DATA

B.H.No	Size	Elev of Top	Depth	From	To	B.H.No	Size	Elev of Top	Depth	From	To	B.H.No	Size	Elev of Top	Depth	From	To	B.H.No	Size	Elev of Top	Depth	From	To						
135 ^c		738.57	75' 00"	Sur	B.R.A.	300 ^c	1 1/2"	623.5	48' 6"	B.R.A.	3 Ft	470 ^c	1 1/2"	703.67	99' 00"	Sur	B.R.A.	671 ^c	3"	897.25	196' 00"	Sur	TS.R.A.	1389 ^c	3"	694.03	65' 00"	Marcy	3 Ft
136 ^c		749.11	69' 5"	Sur	B.R.A.	301 ^c	1 1/2"	950.76	192' 6"	Sur	B.R.A.	471 ^c	1 1/2"	703.31	62' 3"	Sur	B.R.A.	711 ^c	8"	811.02	91' 00"	Sur	TS.R.A.	1390 ^c	3"	633.84	63' 3"	TS.R.A.	3 Ft
138 ^c		782.00	62' 00"	Sur	B.R.A.	308 ^c	1 1/2"	837.74	270' 00"	Sur	B.R.A.	518 ^c	1 1/2"	900.8	71' 00"	Sur	TS.R.A.	712 ^c	8"	790.6	230' 00"	Sur	B.R.A.	1391 ^c	3"	635.52	76' 4"	TS.R.A.	3 Ft
193 ^c	6"	918.51	200' 00"	Sur	B.R.A.	309 ^c	1 1/2"	809.11	247' 00"	Sur	B.R.A.	519 ^c	1 1/2"	934.23	244' 00"	Sur	B.R.A.	984 ^c	2"	801.40	129' 8"	Sur	3 Ft	645 ^c	3"	684.09	161' 00"	TBTRA	Marcy
198 ^c	6"	721.89	120' 00"	Sur	B.R.A.	310 ^c	1 1/2"	837.93	291' 00"	Sur	B.R.A.	521 ^c	1 1/2"	1002.14	260' 00"	Sur	B.R.A.	1249 ^c	2"	774.28	156' 00"	Sur	3 Ft						
282 ^c	1 1/2"	950.07	180' 00"	Sur	B.R.A.	317 ^c	1 1/2"	860.25	228' 00"	Sur	B.R.A.	524 ^c	1 1/2"	1000.63	151' 00"	Sur	B.R.A.	1321 ^c	3"	763.85	55' 3"	TBTRA	3 Ft						
284 ^c	1 1/2"	984.12	108' 00"	Sur	B.R.A.	402 ^c	1 1/2"	840.55	338' 11"	Sur	B.R.A.	546 ^c	2"	721.77	38' 8"	Sur	TS.R.A.	1322 ^c	3"	758.18	57' 1"	TBTRA	3 Ft						
287 ^c	6"	721.89	124' 00"	Sur	B.R.A.	403 ^c	1 1/2"	727.43	81' 3"	Sur	B.R.A.	547 ^c	2"	715.45	52' 3"	Sur	TS.R.A.	1323 ^c	3"	725.26	47' 7"	TBTRA	3 Ft						
288 ^c	6"	708.83	103' 6"	Sur	B.R.A.	414 ^c	1 1/2"	723.67	50' 00"	Sur	B.R.A.	586 ^c	2"	551.8	129' 00"	Sur	B.R.A.	1324 ^c	3"	604.16	131' 4"	Marcy	TBTRA						
289 ^c	1 1/2"	946.65	134' 6"	Sur	B.R.A.	416 ^c	1 1/2"	782.51	143' 00"	Sur	TBTRA	590 ^c	2"	926.66	43' 00"	Sur	B.R.A.	1325 ^c	3"	628.00	58' 6"	TBTRA	3 Ft						
290 ^c	1 1/2"	928.08	261' 00"	Sur	B.R.A.	418 ^c	1 1/2"	800.91	154' 4"	Sur	3 Ft	591 ^c	2"	754.60	160' 00"	Sur	B.R.A.	1386 ^c	3"	639.55	56' 3"	TBTRA	3 Ft						
291 ^c	1 1/2"	976.13	168' 6"	Sur	B.R.A.	422 ^c	1 1/2"	832.59	175' 11"	Sur	B.R.A.	616 ^c	2"	649.37	126' 00"	Sur	B.R.A.	1327 ^c	3"	722.30	40' 6"	TBTRA	3 Ft						
296 ^c	1 1/2"	867.10	62' 00"	Sur	B.R.A.	423 ^c	1 1/2"	739.74	41' 00"	Sur	3 Ft	667 ^c	3"	782.62	208' 8"	Sur	TBTRA	1387 ^c	3"	673.23	81' 00"	Marcy	3 Ft						
299 ^c	6"	751.31	235' 00"	Sur	B.R.A.	469 ^c	1 1/2"	706.23	14' 00"	Sur	TS.R.A.	668 ^c	3"	916.59	187' 00"	Sur	TBTRA	1388 ^c	3"	745.19	79' 6"	Marcy	3 Ft						

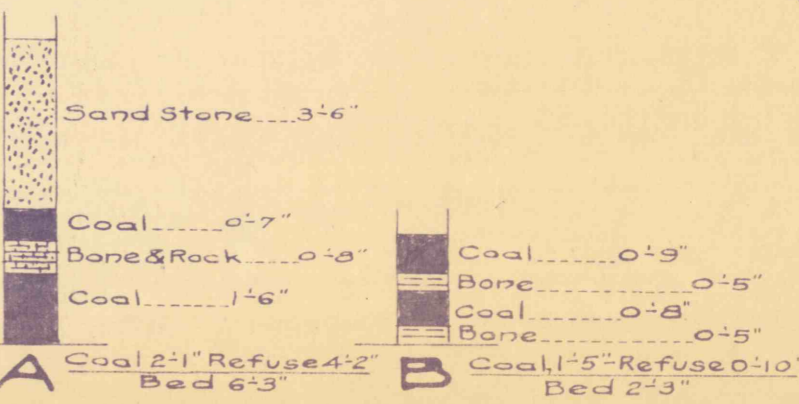

POSTED

DATE	BY WHOM	DATE	BY WHOM
1-15-23	W.G.	12-53	J.R.W.
5-18-23	X.B.	2-55	J.R.W.
11-18-23	BYE.	2-56	J.R.W.
4-16-25	W.G.		
12-43	R.R.		
12-44	A.B.E.		
1-46	R.H.		
12-46			
12-47	R.H.		
1-49	R.H.		
11-49	M.J.R.		
1-51	P.H.M.		
1-52	P.H.M.		
1-53	A.J.H.		

THE HUDSON COAL CO. WILKESBARRE DIVISION

Workings in the THREE-FOOT-CROSS-BED LAFLIN COLLIERY

Scale 1"=400'. Office of Forecast Dept., Scranton, Pa. Jan. 1924