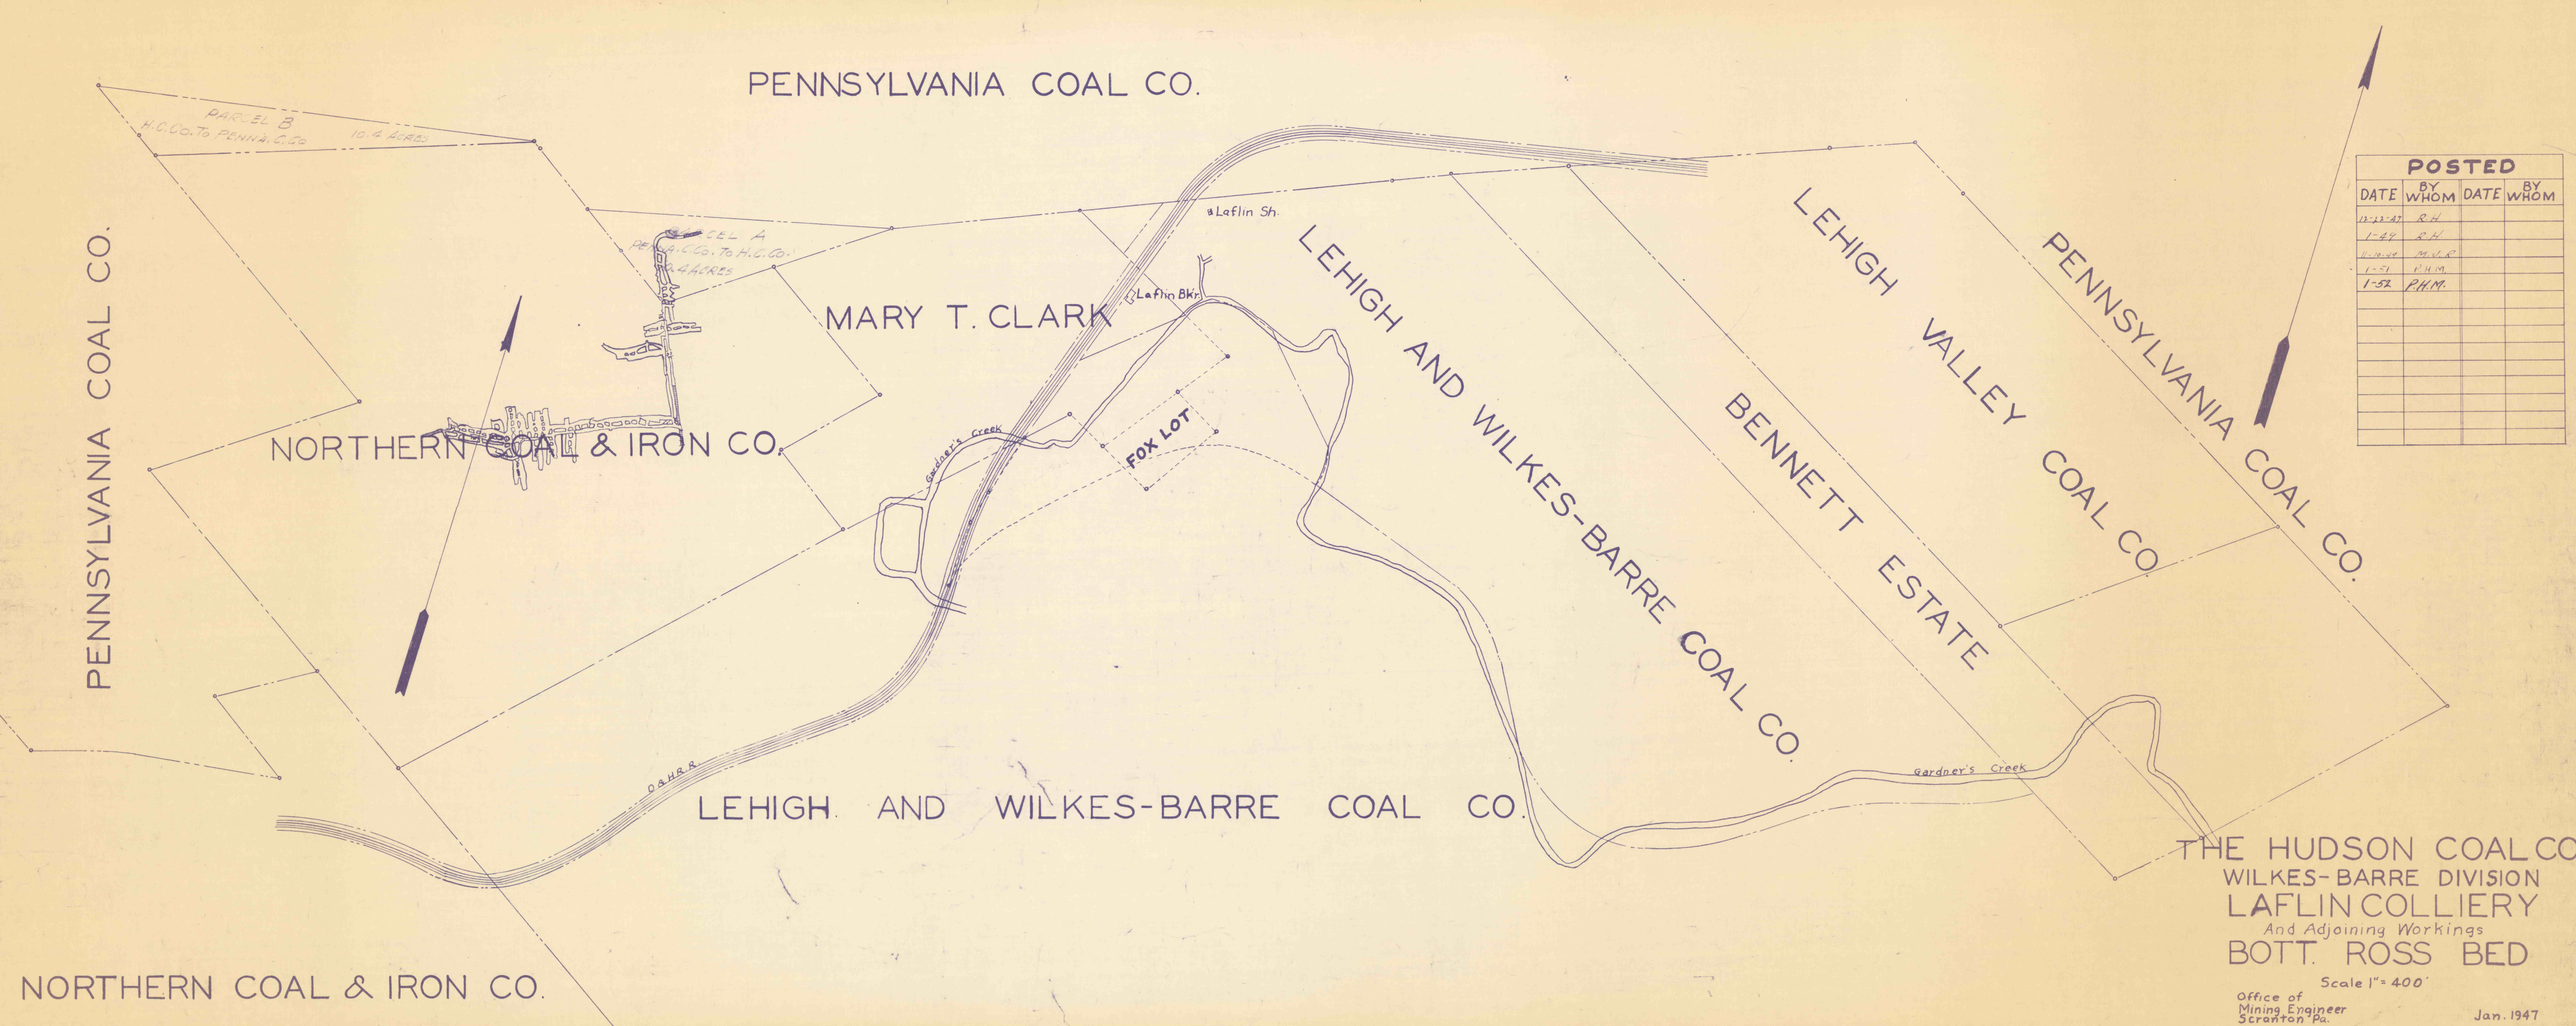
PENNSYLVANIA COAL CO.
PARCEL B
H.C.Co. To Penn'a. C. Co
10.4 ACRES
PARCEL A
P.C.Co. To H.C.Co.
4.4 ACRES
PENNSYLVANIA COAL CO.
MARY T. CLARK
NORTHERN COAL & IRON CO.
Laflin Sh.
Laflin Bkr.
FOX LOT
Gardner's Creek
LEHIGH AND WILKES-BARRE COAL CO.
LEHIGH VALLEY COAL CO.
BENNETT ESTATE
PENNSYLVANIA COAL CO.
Gardner's Creek
D&HR R
LEHIGH AND WILKES-BARRE COAL CO.
NORTHERN COAL & IRON CO.
POSTED
DATE | BY WHOM | DATE | BY WHOM
11-22-47 R.H.
1-47 R.H.
1-10-48 M.V.K.
1-51 P.H.M.
1-52 P.H.M.
THE HUDSON COAL CO
WILKES-BARRE DIVISION
LAFLIN COLLIERY
And Adjoining Workings
BOTT. ROSS BED
Scale 1" = 400'
Office of
Mining Engineer
Scranton Pa.
Jan. 1947