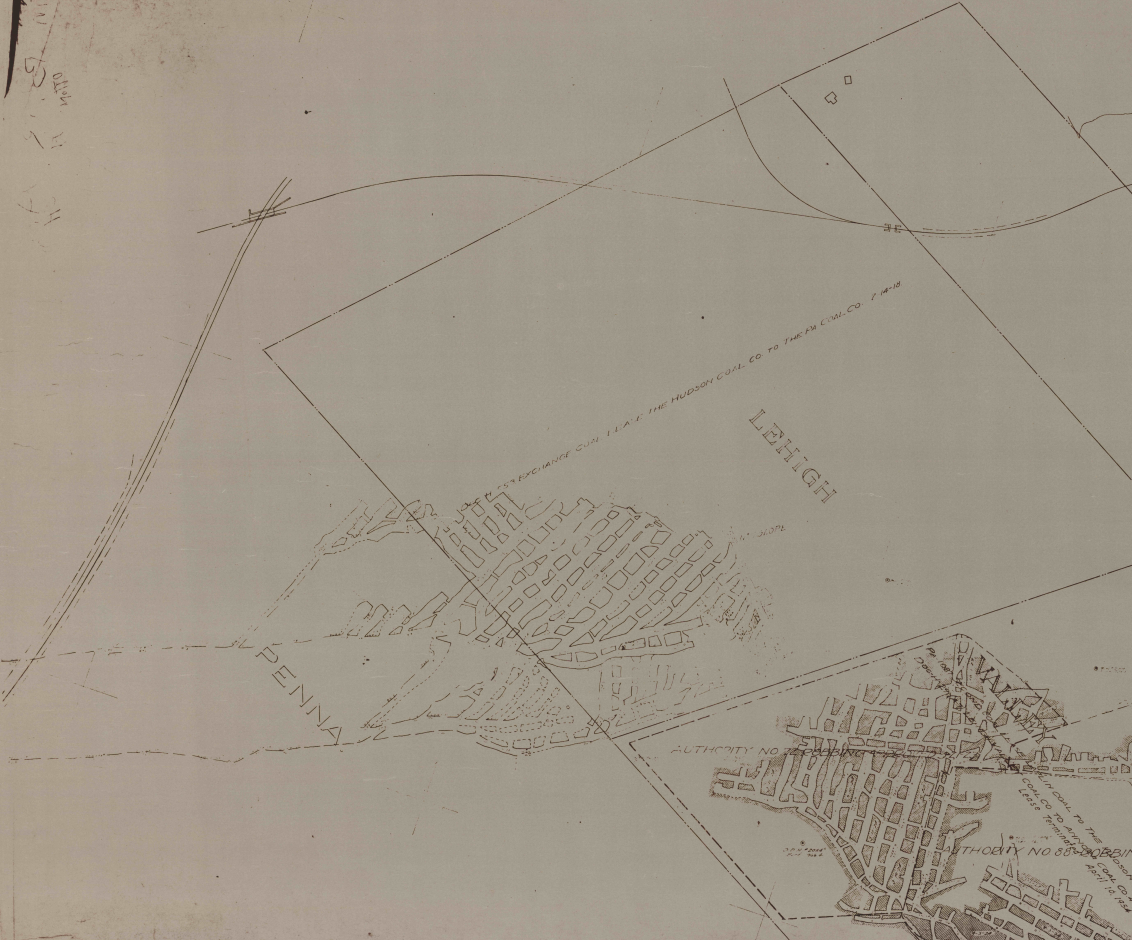
D.C.H. 553 EXCHANGE COAL LEASE THE HUDSON COAL CO. TO THE PA COAL CO. 7-14-18.
LEHIGH
SLOPE
PENNA
AUTHORITY NO 72 ROBBING
AUTHORITY NO 88 ROBBING
COAL CO TO ANNORA COAL CO
Lease Terminated April 10, 1954
D.D.H. #2056
9664

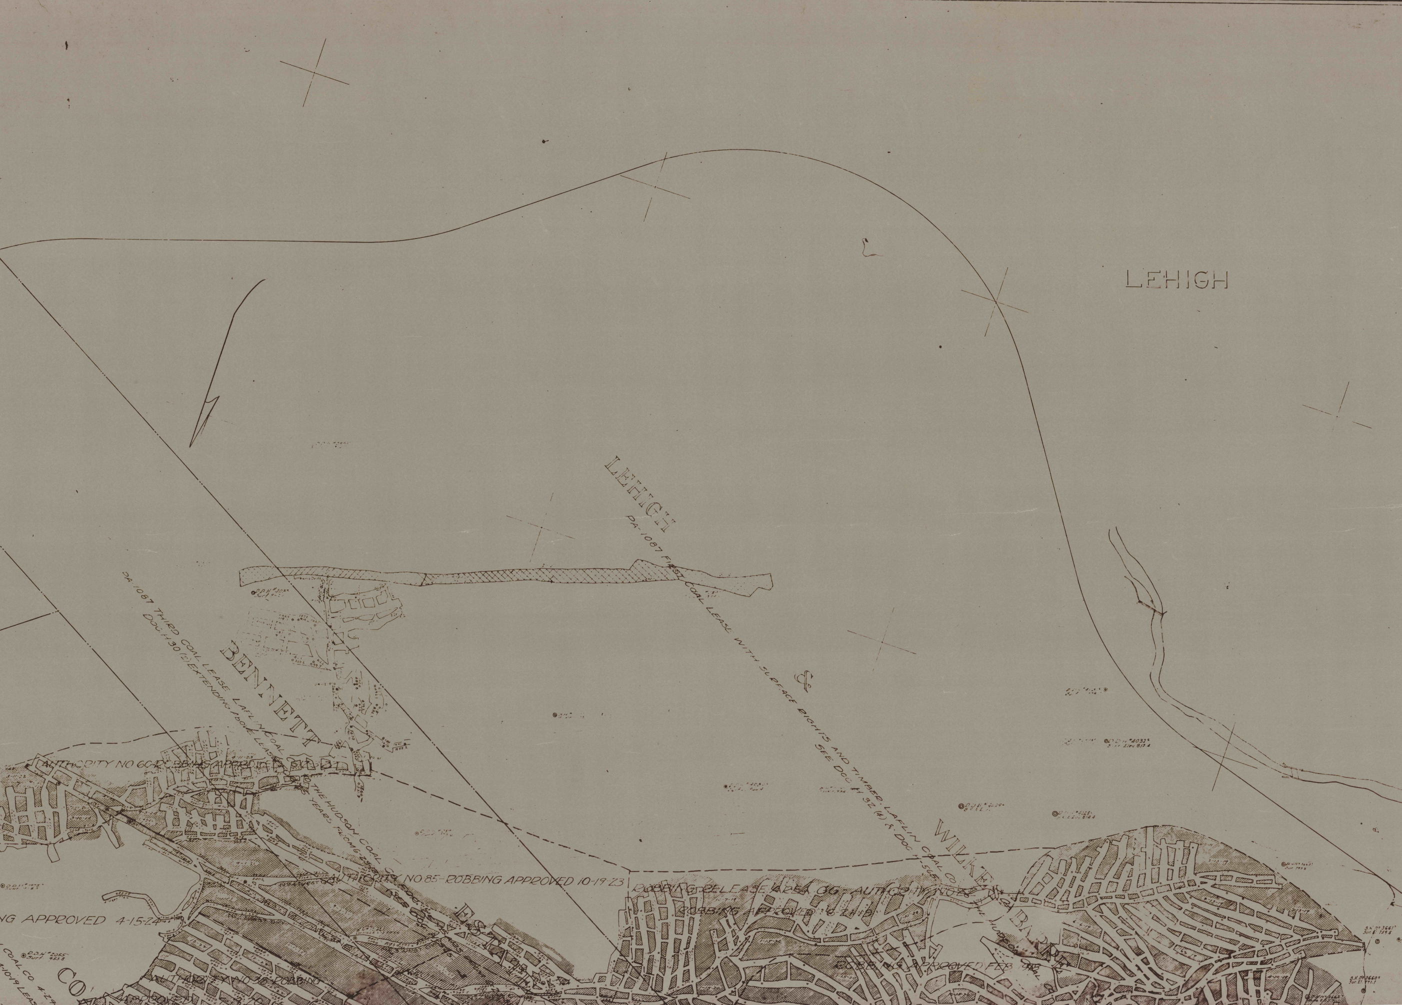
LEHIGH
LEHIGH
&
WILKES-BARRE
BENNETT
PA 1087 FIRST COAL LEASE WITH SURFACE RIGHTS AND TIMBER. LAFLIN COAL CO TO THE HUDSON COAL CO
SEE DOC H 32 (4) & DOC H 565
PA 1087 THIRD COAL LEASE LAFLIN COAL CO TO THE HUDSON COAL CO
DOC H 30 (2) EXTENDING ABOVE LEASE 15 YEARS FROM 6-25
Urbans Drift
AUTHORITY NO 60-ROBBING APPROVED
AUTHORITY NO 85-ROBBING APPROVED 10-19-23
ROBBING RELEASE AREA GG - AUTHORITY NO 28
ROBBING APPROVED 6-24-19
ROBBING APPROVED FEB
NG APPROVED 4-15-24
AUTHORITY NO 38 ROBBING
D.D.H. 2055 Surf 953.8
COAL CO
10-19 LEAS
CO

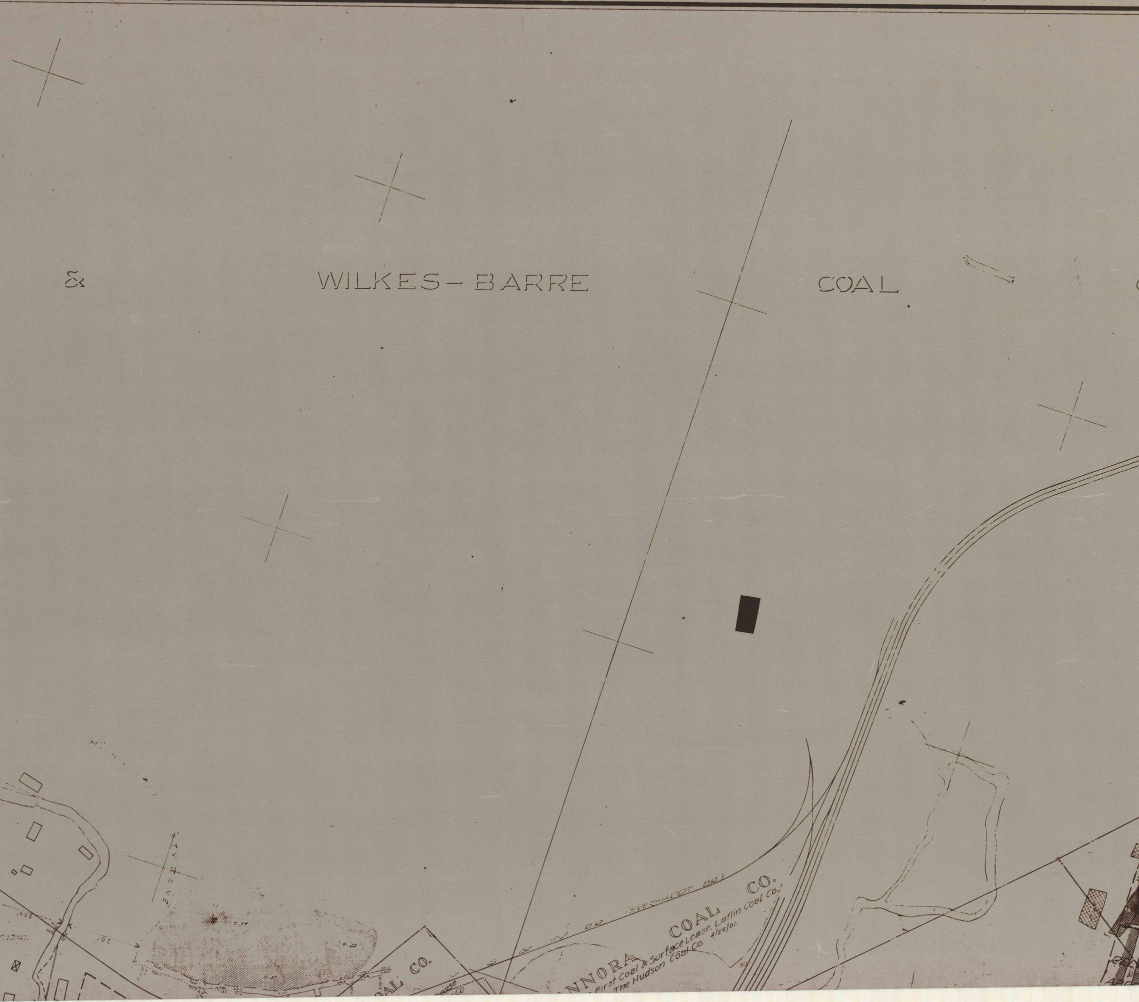
&
WILKES-BARRE
COAL
(EVERHARDT BR.)
L. V. S. & W. RR.
ANNORA COAL CO.
First Coal & Surface Lease, Laflin Coal Co.
The Hudson Coal Co. 4/29/01.
COAL CO.
9-20
7-37

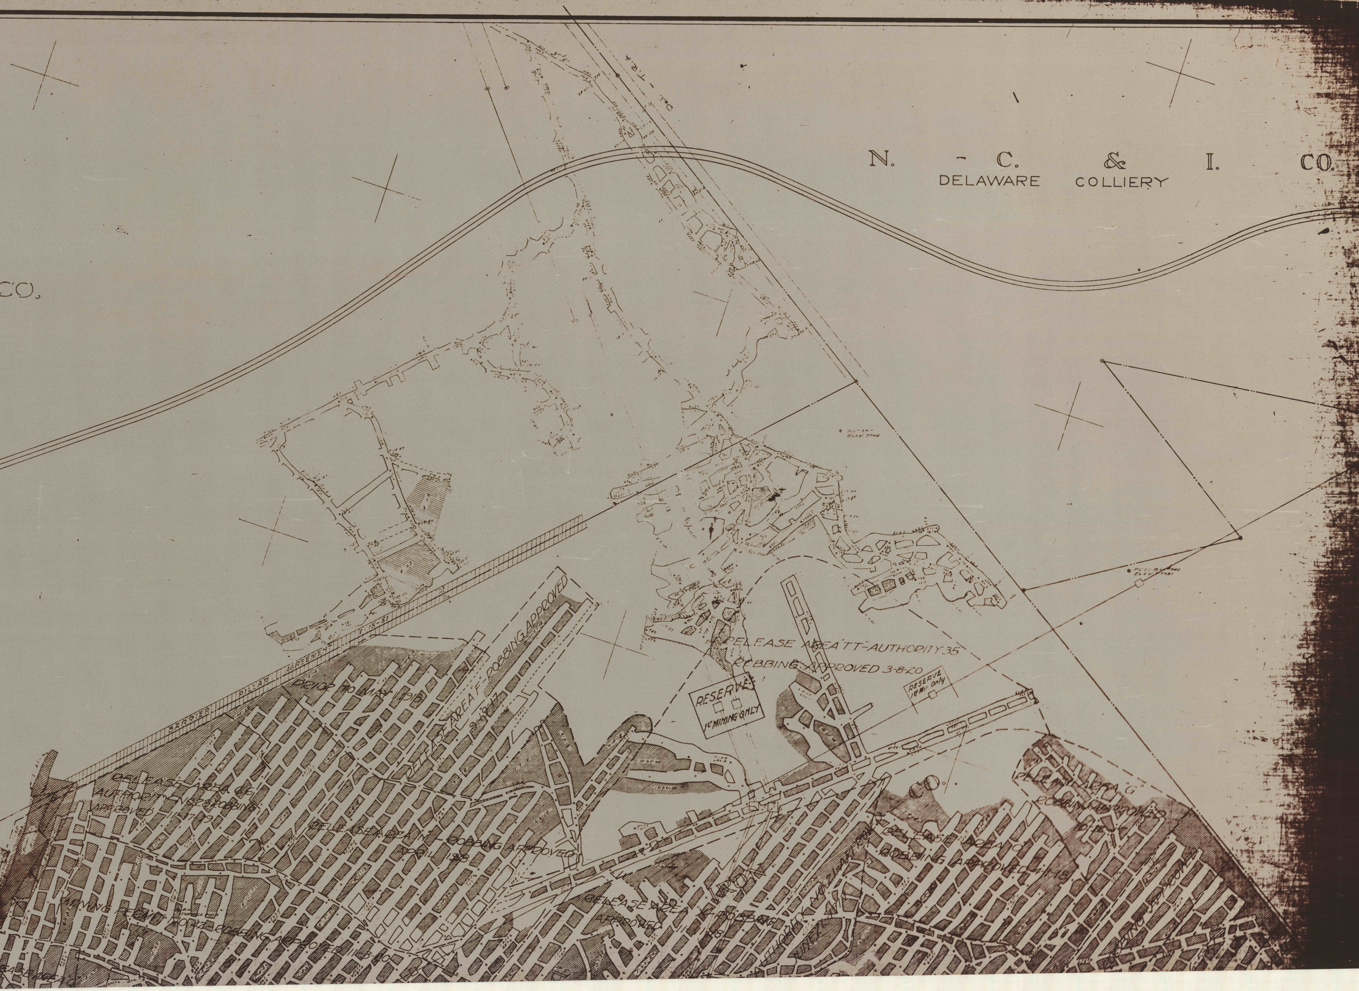
N. - C. & I. CO.
DELAWARE COLLIERY
CO.
BARRIER PILLAR AGREEMENT
1-15-51
PRIOR TO MAY 1918
RELEASE AREA "F" - ROBBING APPROVED
2-19-17
RELEASE AREA "TT" - AUTHORITY 35
ROBBING APPROVED 3-8-20
RESERVE
1st MINING ONLY
RESERVE
1st Min. Only
RELEASE AREA 66
AUTHORITY NO. 28 ROBBING
APPROVED 1-17-19
RELEASE AREA "M" - ROBBING APPROVED
APRIL 1918
RELEASE AREA "K" - ROBBING
APPROVED 11-18
IRON
RELEASE AREA "O"
ROBBING APPROVED 4-1-18
RELEASE AREA "G"
ROBBING APPROVED
10-18
ROBBING APPROVED
MINING PERMIT NO. 22 - ROBBING APPROVED 11-13-20
ELEV. 7736
ELEV. 7731