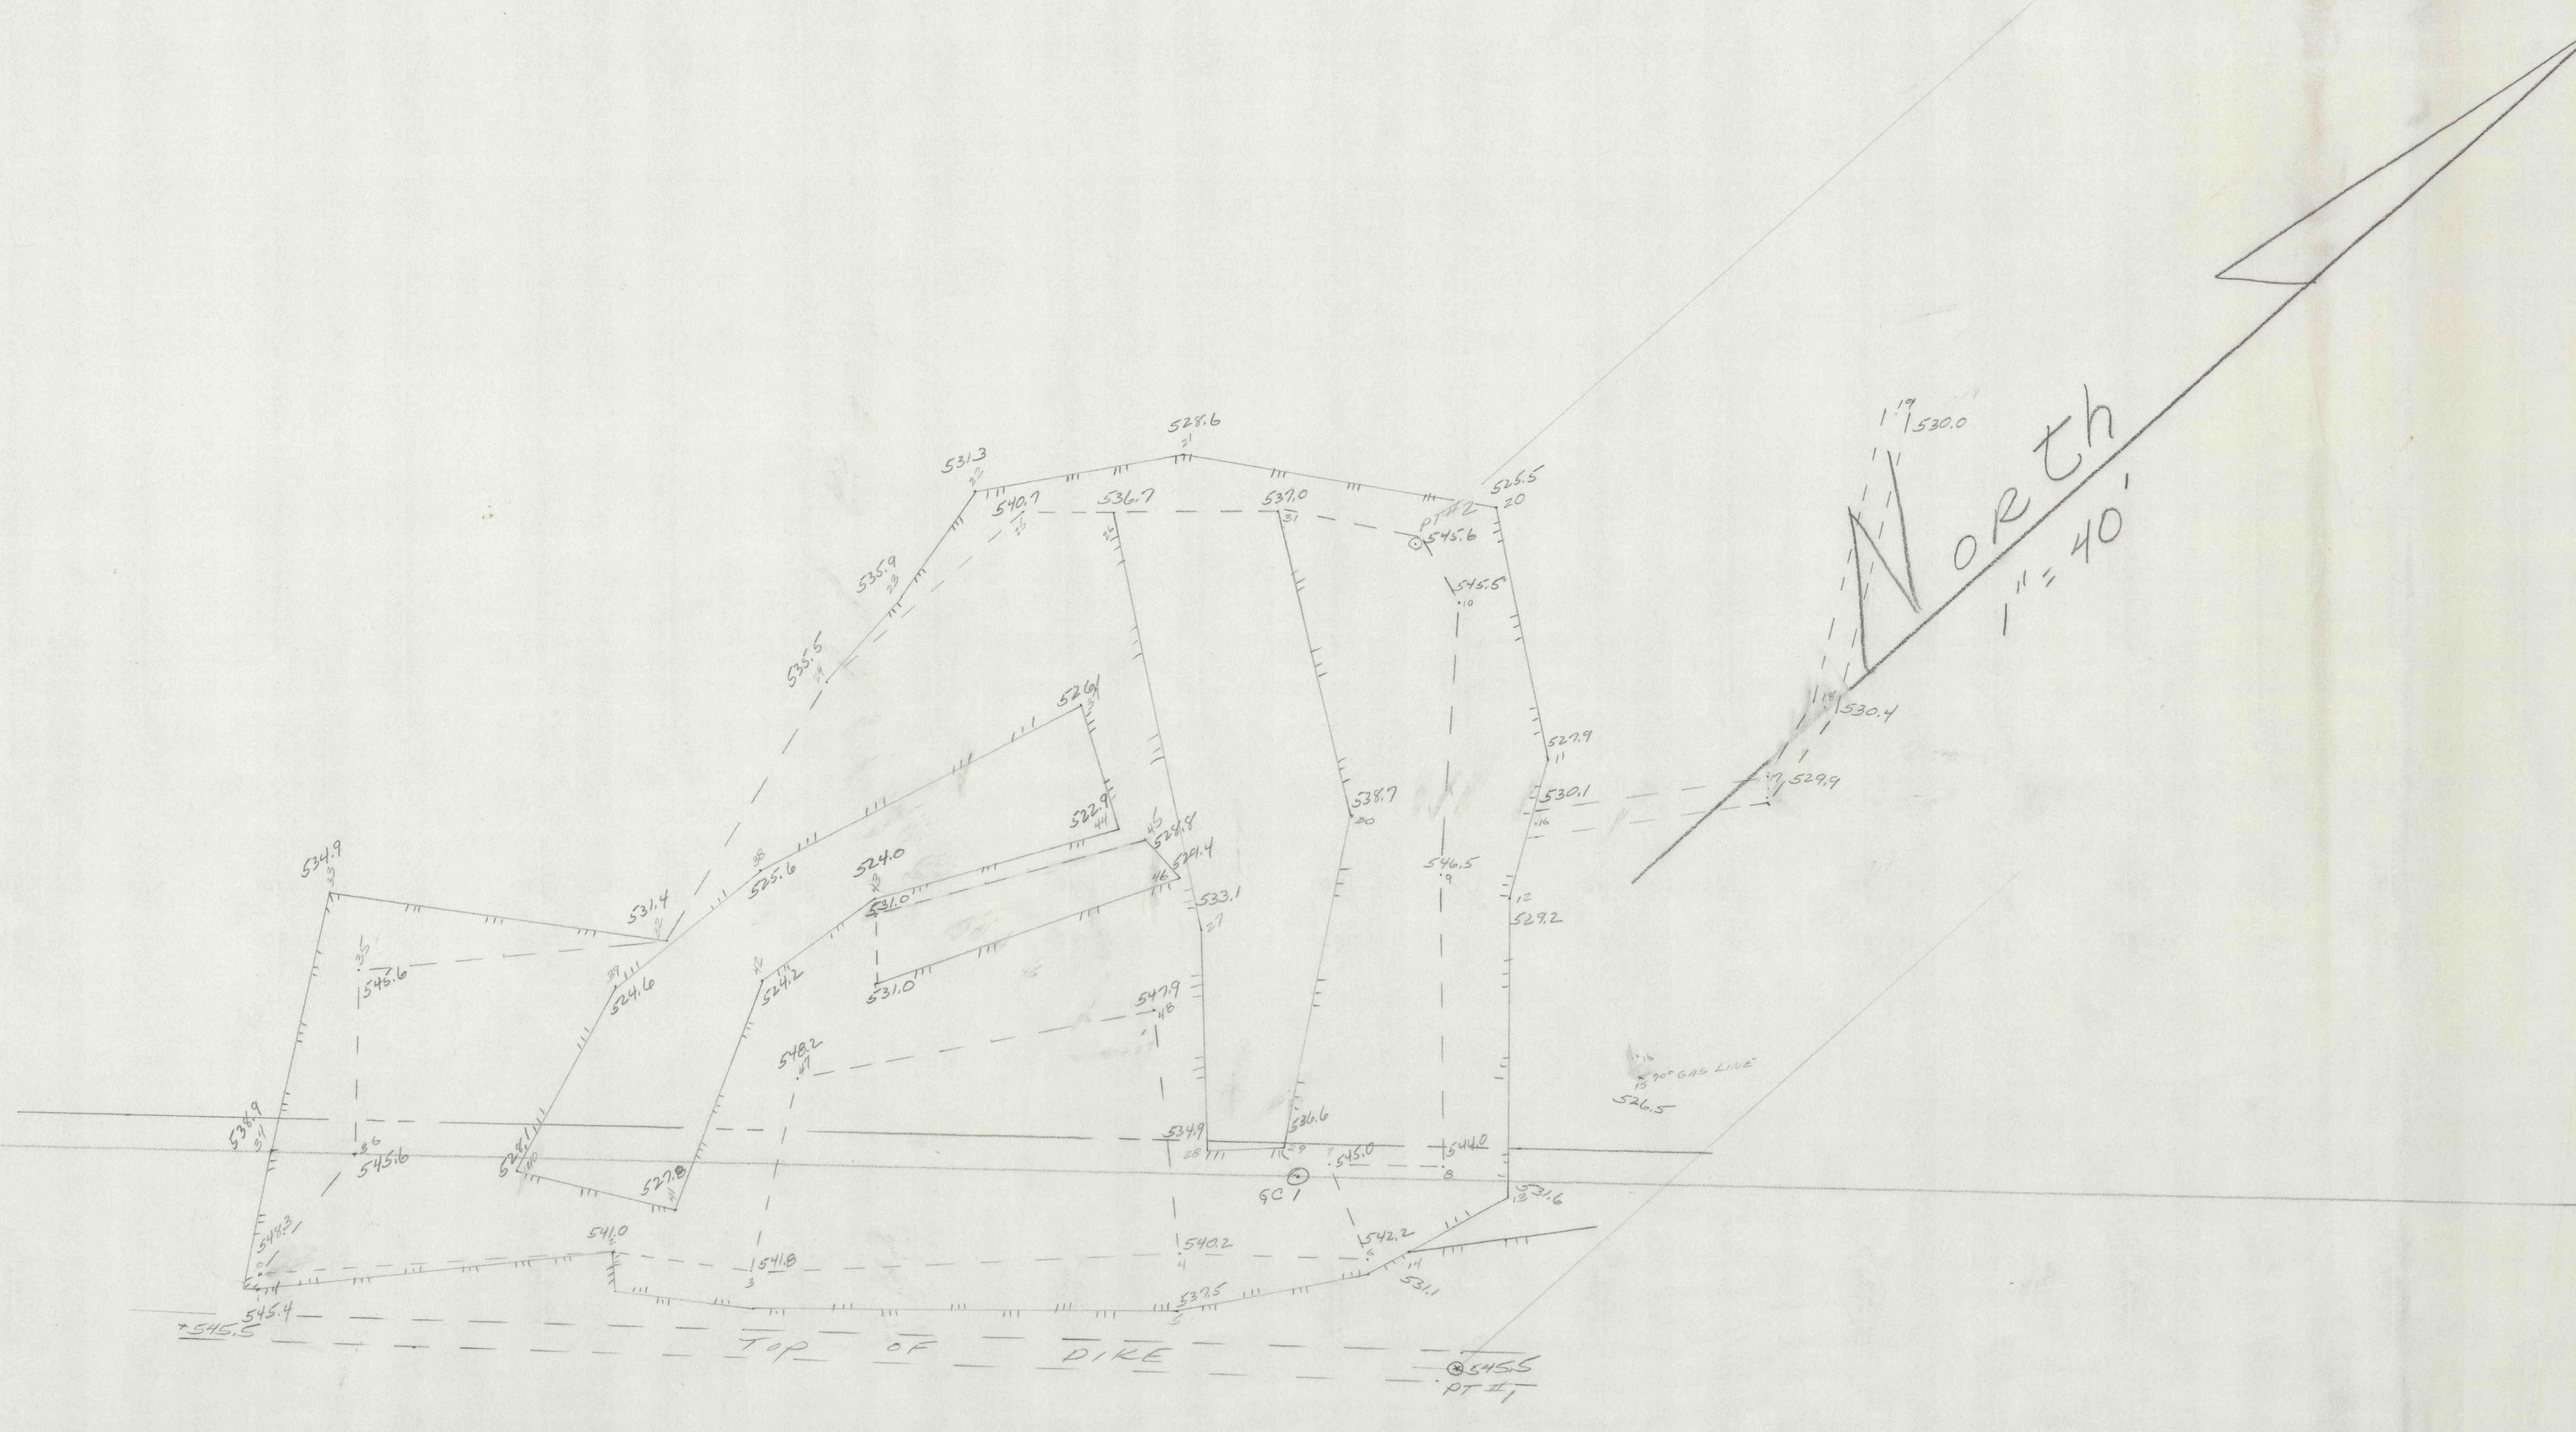
North
1" = 40'
TOP OF DIKE
PT #1
PT #2
SC 1
545.6
545.5
530.0
530.4
529.9
528.6
531.3
540.7
536.7
537.0
525.5
535.9
535.6
526.1
522.9
524.8
524.0
531.4
525.6
534.9
531.0
533.1
527.9
530.1
538.7
546.5
529.2
524.6
524.2
547.9
548.2
545.6
538.9
545.6
548.1
527.8
534.9
536.6
545.0
544.0
531.6
541.0
543.1
540.2
542.2
541.8
537.5
545.4
545.5
530.0
530.4
529.9
527.9
530.1
529.2
90° GAS LINE
526.5