


SCALE 1" = 100'

SURFACE

CORE DRILLING

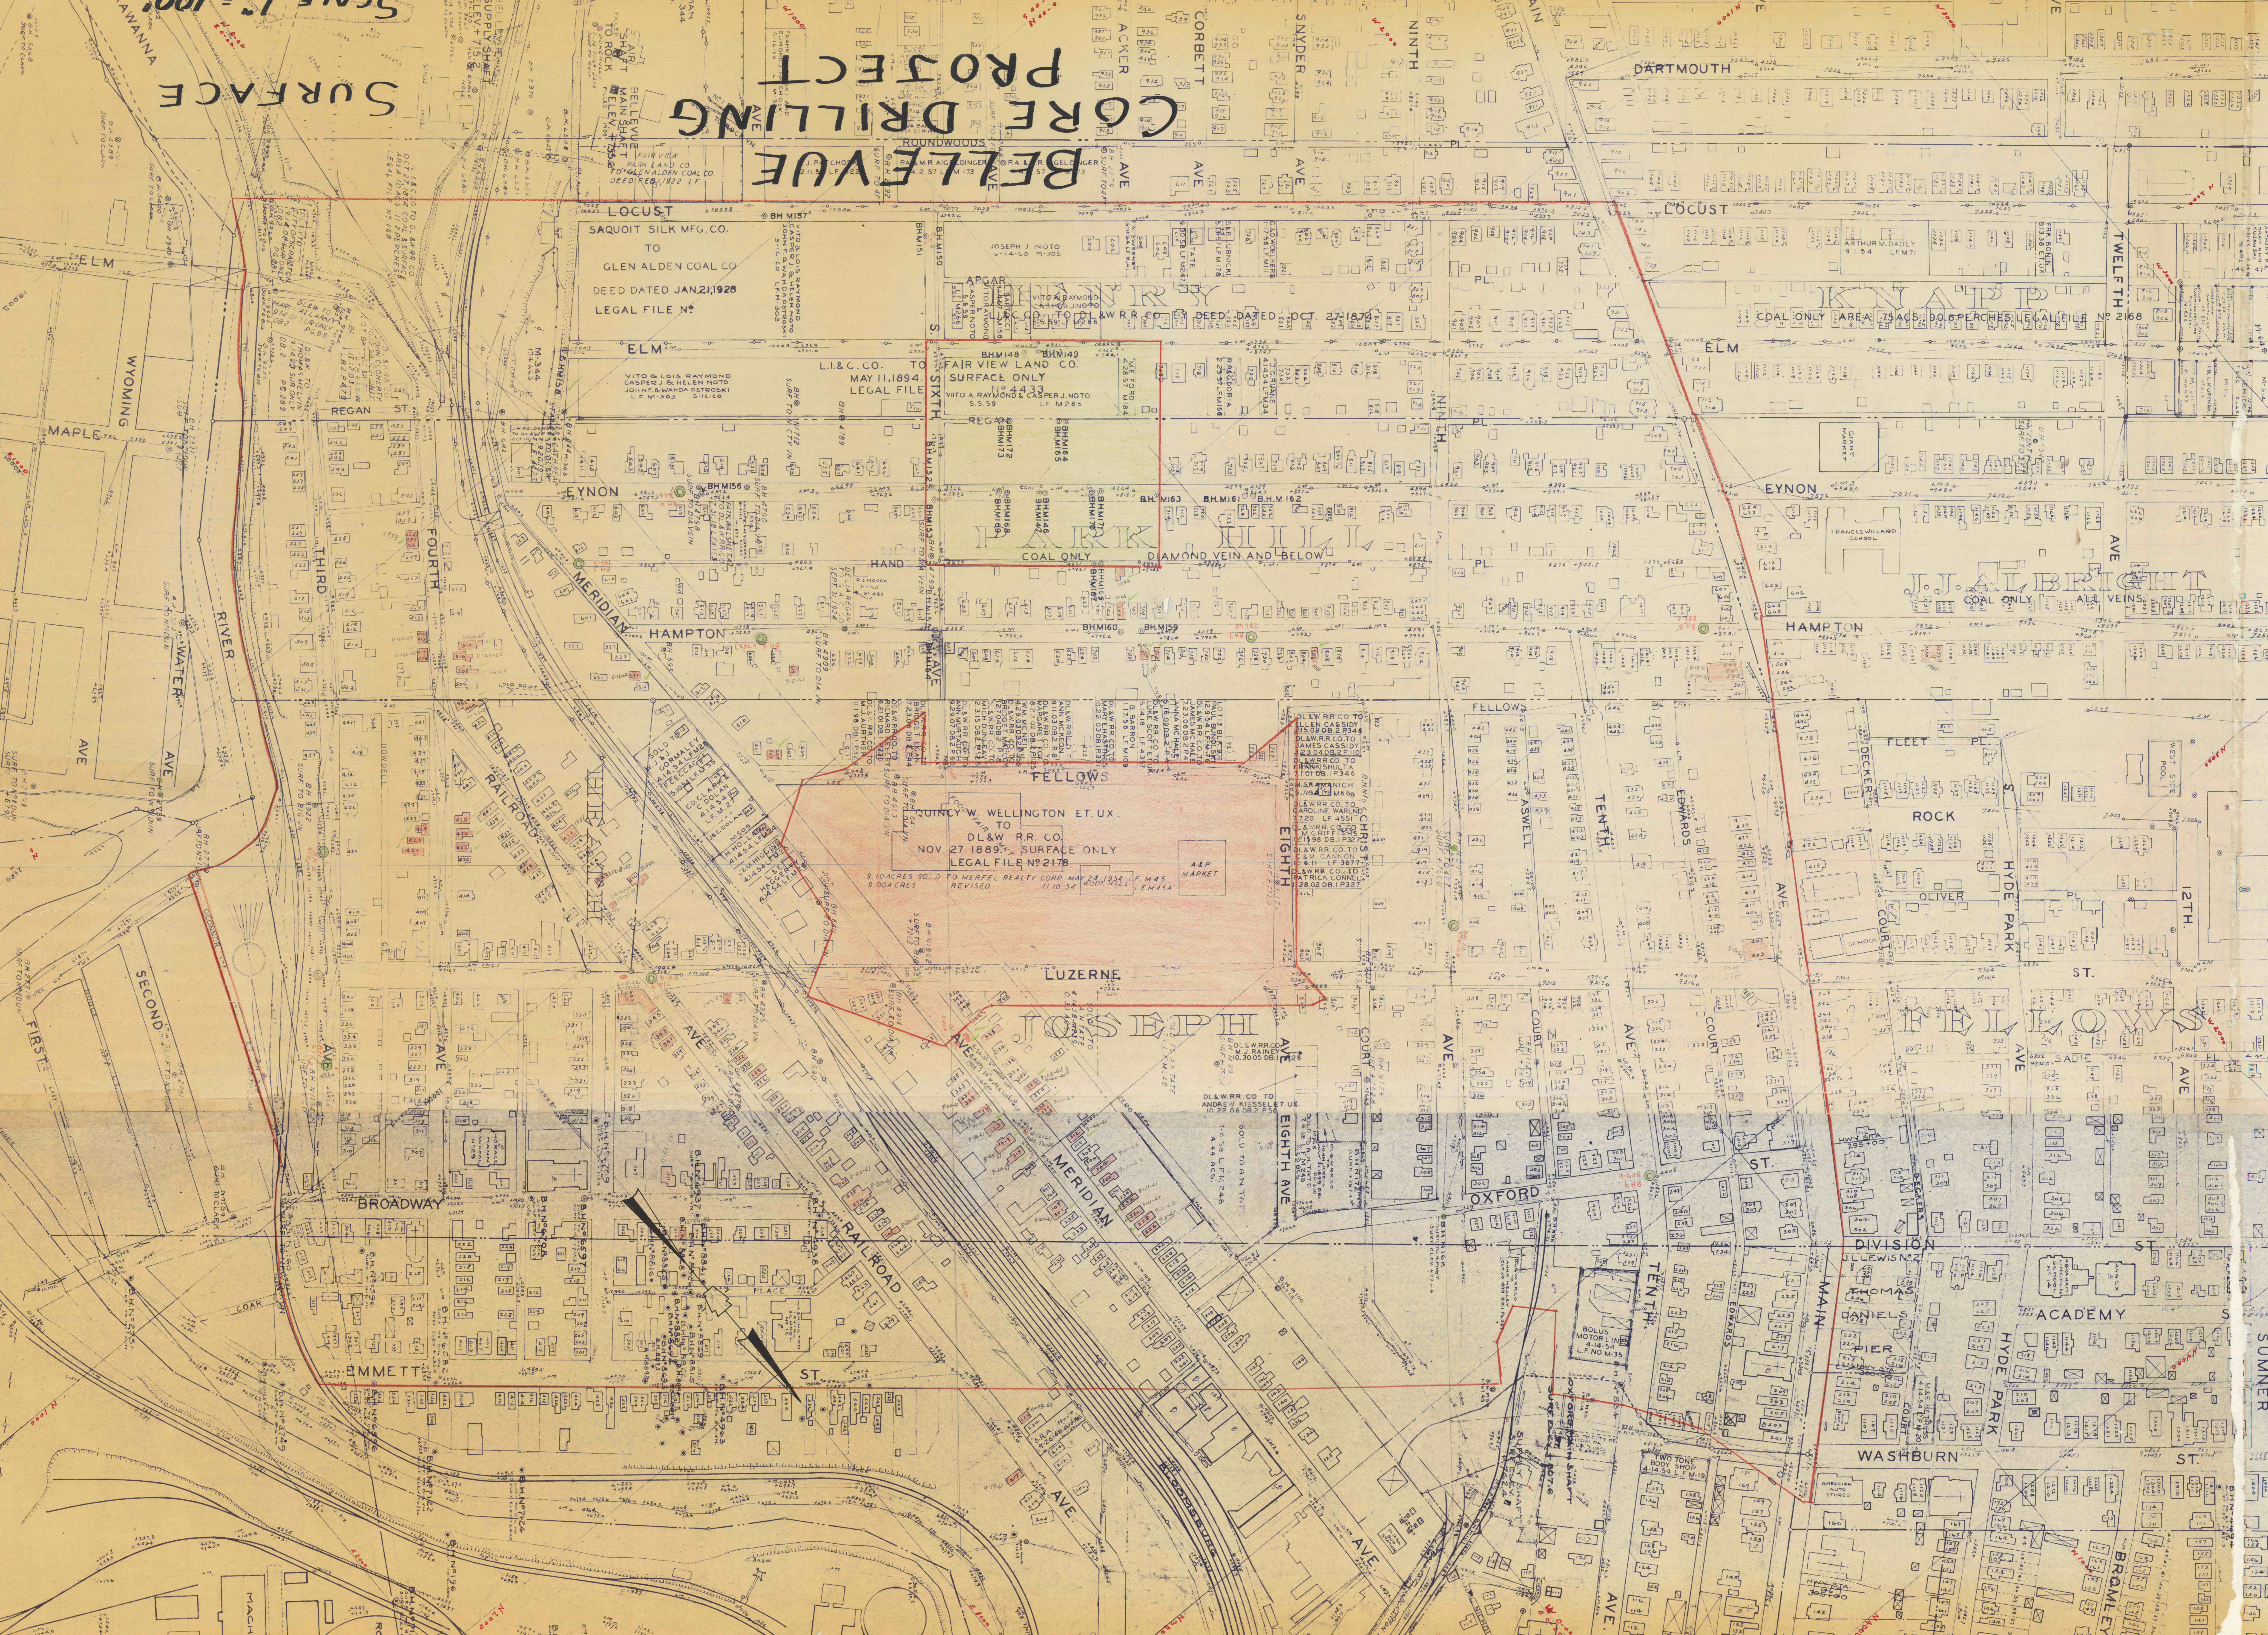

LOCUST
SAQUIOT SILK MFG. CO.
TO
GLEN ALDEN COAL CO.
DEED DATED JAN. 21, 1928
LEGAL FILE NO.

ELM
VITO & LOIS RAYMOND
CASPER J. & HELEN NOTO
JOHN F. & WANDA OSTROSKI
L.F. M. 353

FAIR VIEW LAND CO.
SURFACE ONLY
VITO & RAYMOND CASPER J. NOTO
L.F. M. 260

QUINCY W. WELLINGTON ET. UX.
TO
DL & W. R. R. CO.
NOV. 27 1889 SURFACE ONLY
LEGAL FILE NO. 2178

ASWELL
TENTH
EDWARDS
ROCK
HYDE PARK
OLIVER
COURT

JOSEPH AVE


BROADWAY

EMMETT ST

ST

AVE

AVE

AVE

WASHBURN ST

ST

SUNNER

HYDE PARK

ACADEMY

DIVISION ST

ST

OXFORD

TENTH

EDWARDS

ST

MAIN



















































