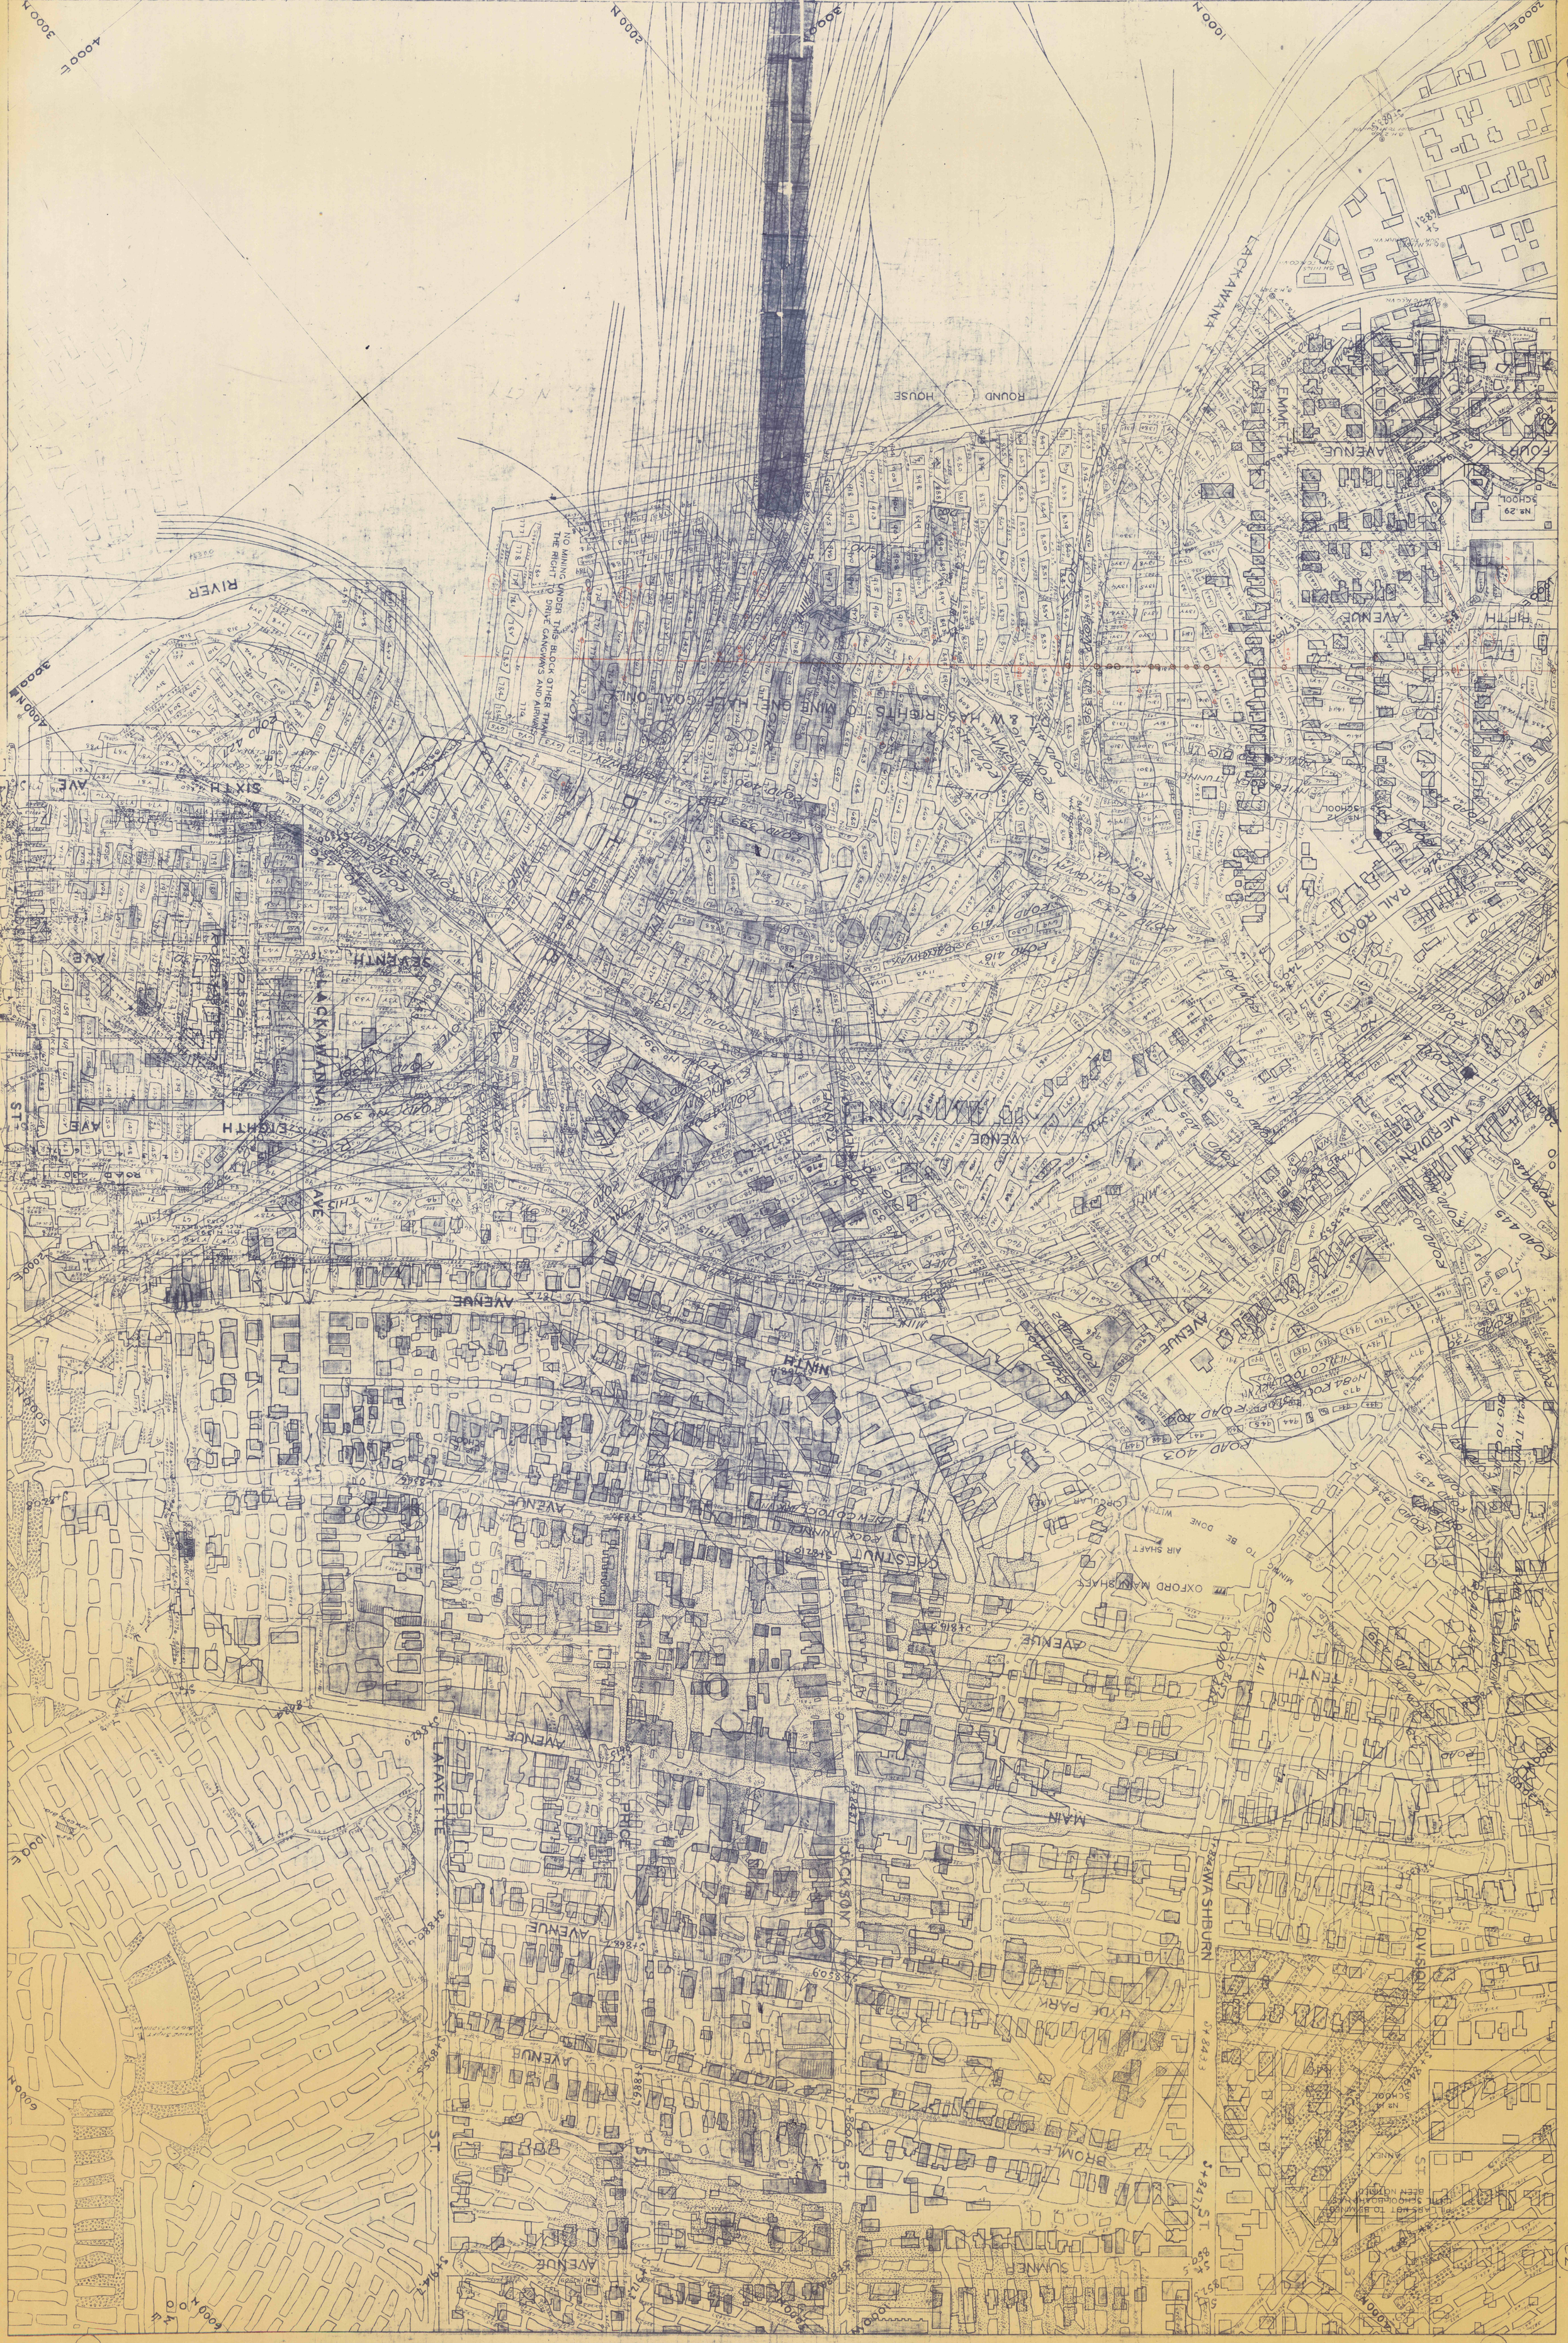
4000E
3000N
2000N
3000E
1000N
2000E
RIVER
ROUND HOUSE
LACKAWANNA
EMMET
AVENUE
FOURTH
SCHOOL
NO MINING UNDER THIS BLOCK OTHER THAN THE RIGHT TO DRIVE GANGWAYS AND AIRWAYS
ONE HALF COAL ONLY
D&H HAS RIGHTS TO MINE
SIXTH
AVE
SEVENTH
EIGHTH
ROAD 392
ROAD 419
ROAD 403
ROAD 436
ROAD 441
ROAD 445
RAIL ROAD
MERIDIAN
NEW CO LOCK TUNNEL
CHESTNUT
OXFORD MAIN SHAFT
AIR SHAFT
TO BE DONE WITH
MINING
MAIN
WASHBURN
DIVISION
JACKSON
HYDE PARK
BROMLEY
SUMNER
ANNEX
ST.
TENTH
ROAD 441
ROAD 403
ROAD 436
ROAD 435
ROAD 445
CIRCULAR
TUNNEL
AVENUE
LAFAYETTE
MINT
OVER
TUNNEL
SCHOOL
NO 29
NO 12
NO 34 ROCK TUNNEL
NO 34 COLD BLACK VN
D&H NI641 N COLD CLARK VN
D&H NI393 ELK CREEK VN
D&H NI642 SLATE DALE VN
D&H