

NO.	DATE	REVISION	APP.


COMMONWEALTH OF PENNSYLVANIA
DEPARTMENT OF ENVIRONMENTAL RESOURCES
OFFICE OF RESOURCES MANAGEMENT

PROJECT NO.
**EXPLORATORY DRILLING
SUBSURFACE INVESTIGATION**
DURYEA BOROUGH
LUZERNE COUNTY, PENNSYLVANIA

NO. 9 - BARNUM - SENECA - HALLSTEAD
COLLIERIES
SURFACE MAP

SCALE: 1" = 100'

I.1 B

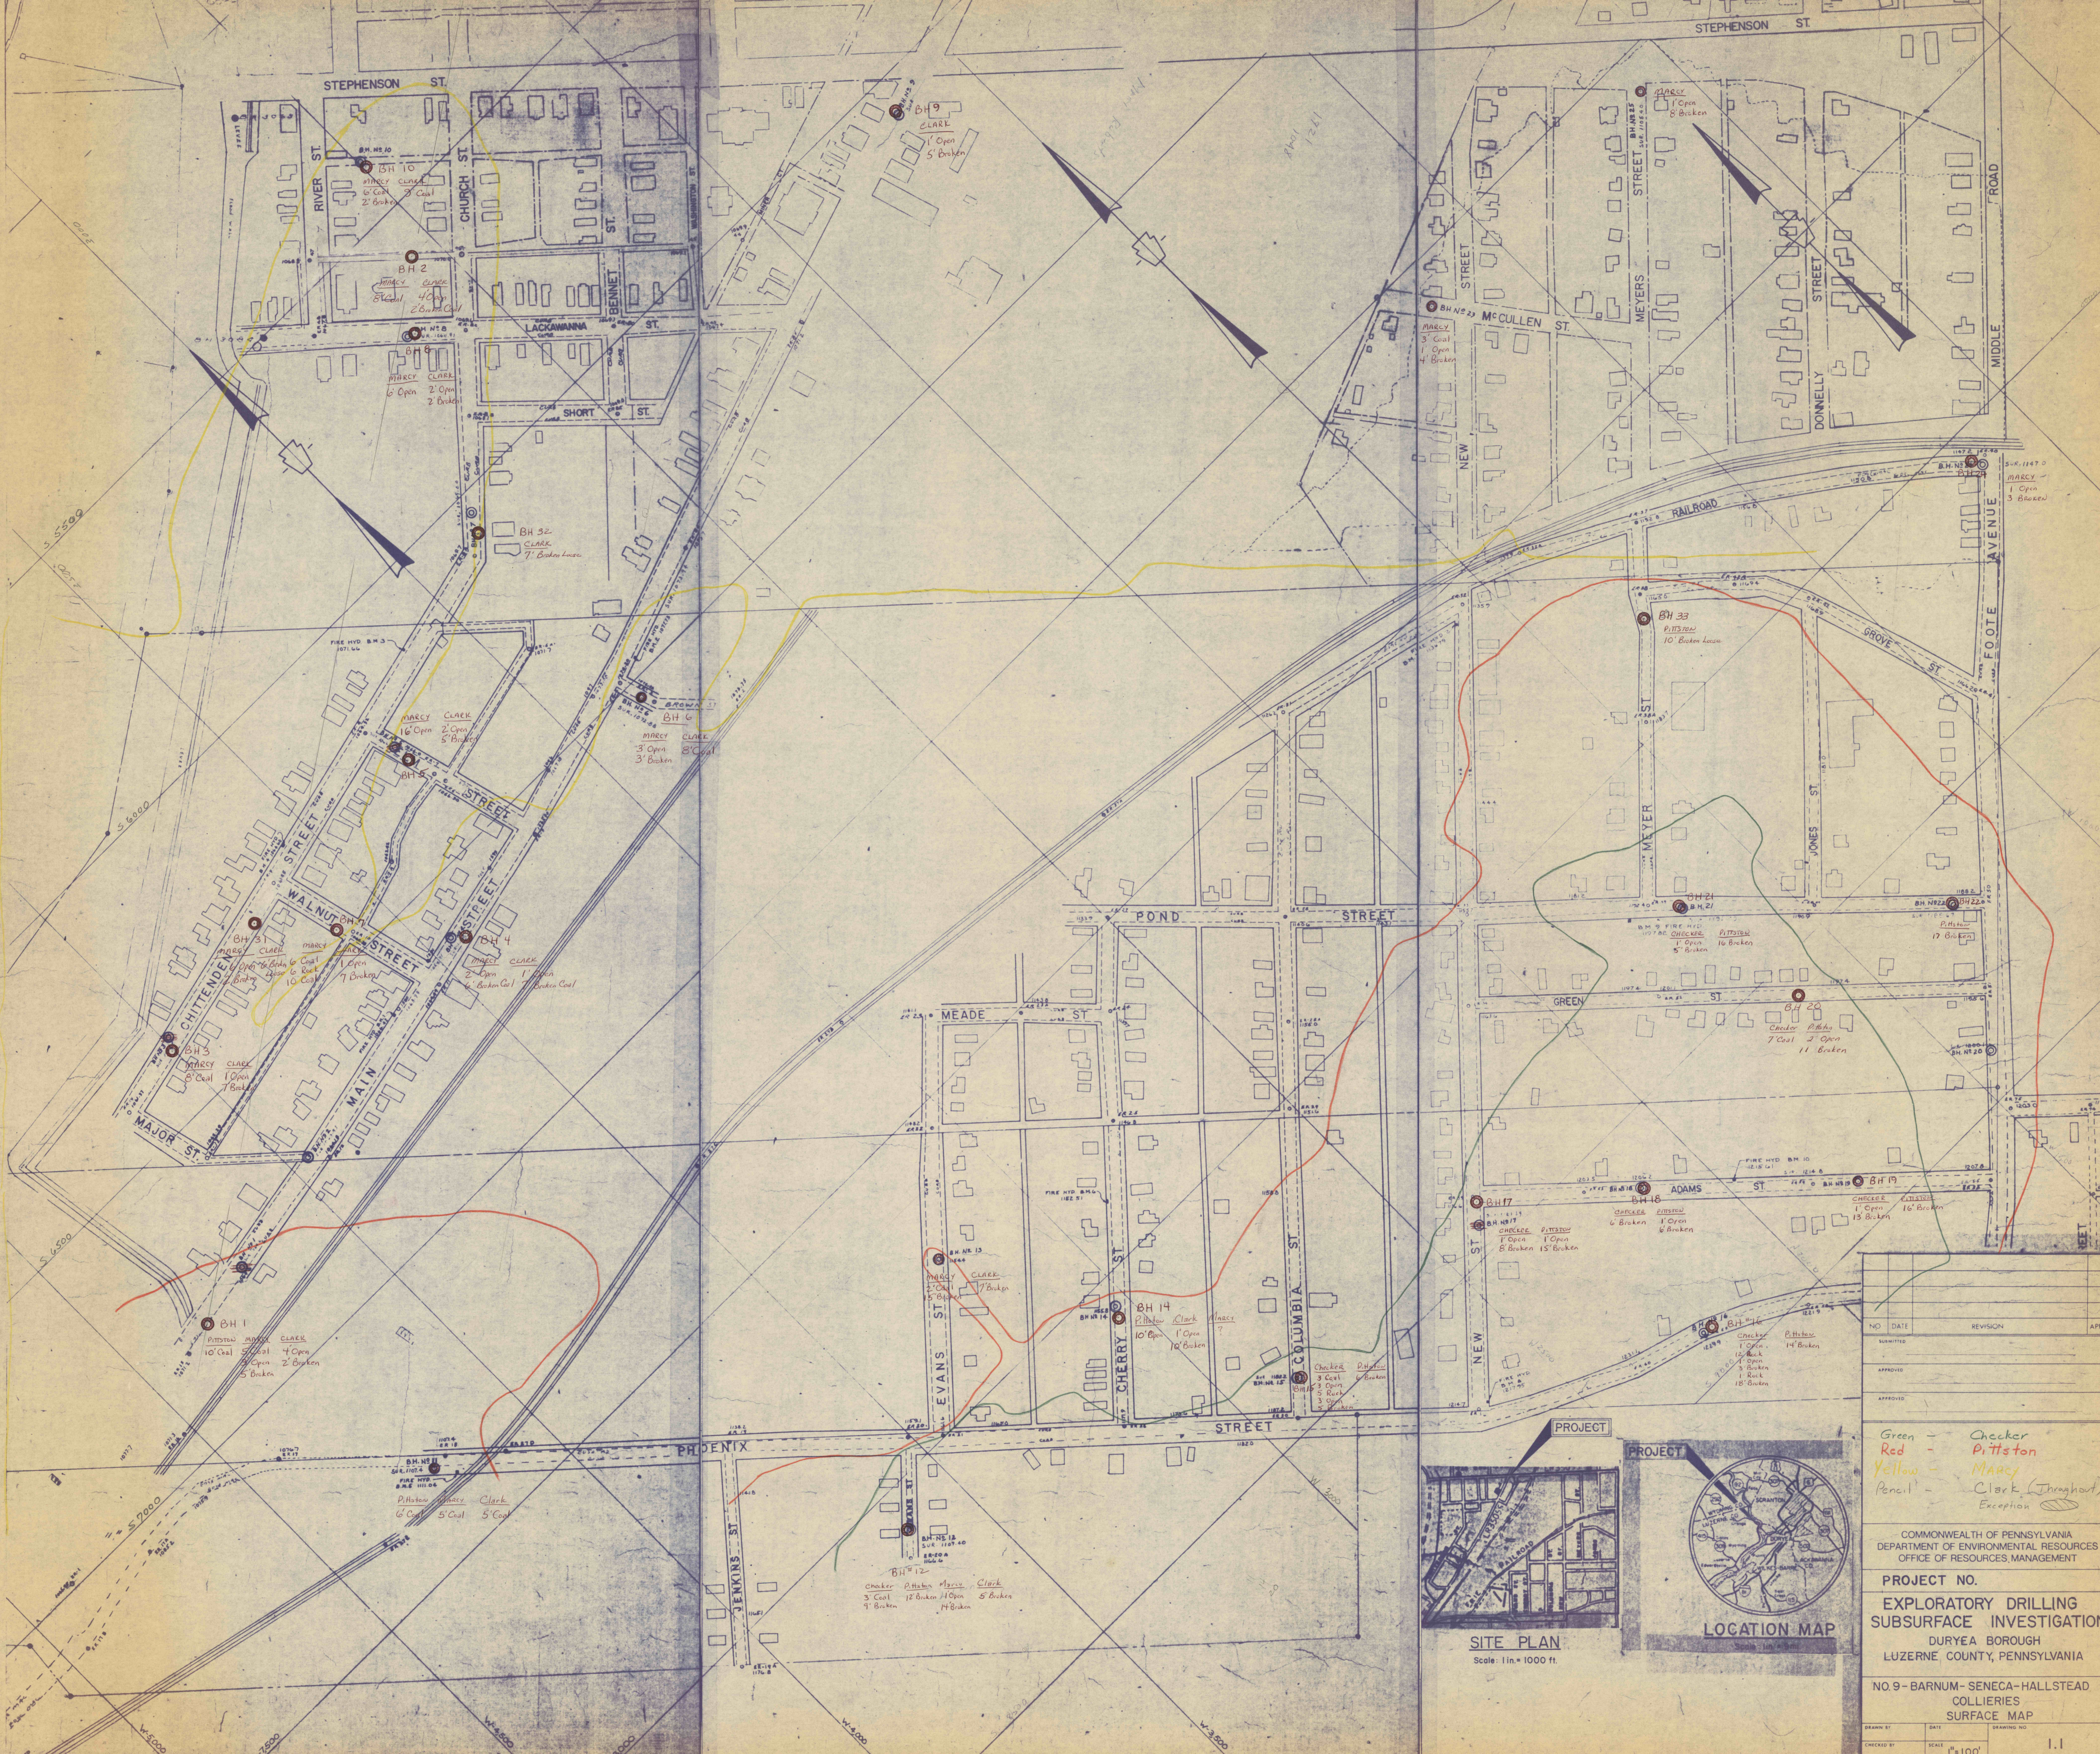

NO.	DATE	REVISION	APP.

Green - Checker
Red - Pittston
Yellow - Marcy
Pencil - Clark (throughout)
Exception

COMMONWEALTH OF PENNSYLVANIA
DEPARTMENT OF ENVIRONMENTAL RESOURCES
OFFICE OF RESOURCES MANAGEMENT

PROJECT NO.
**EXPLORATORY DRILLING
SUBSURFACE INVESTIGATION**
DURYEA BOROUGH
LUZERNE COUNTY, PENNSYLVANIA

NO. 9 - BARNUM - SENECA - HALLSTEAD
COLLIERIES
SURFACE MAP

SCALE: 1" = 100'

I.1