


HAZLE TWP.
FOSTER TWP.

9

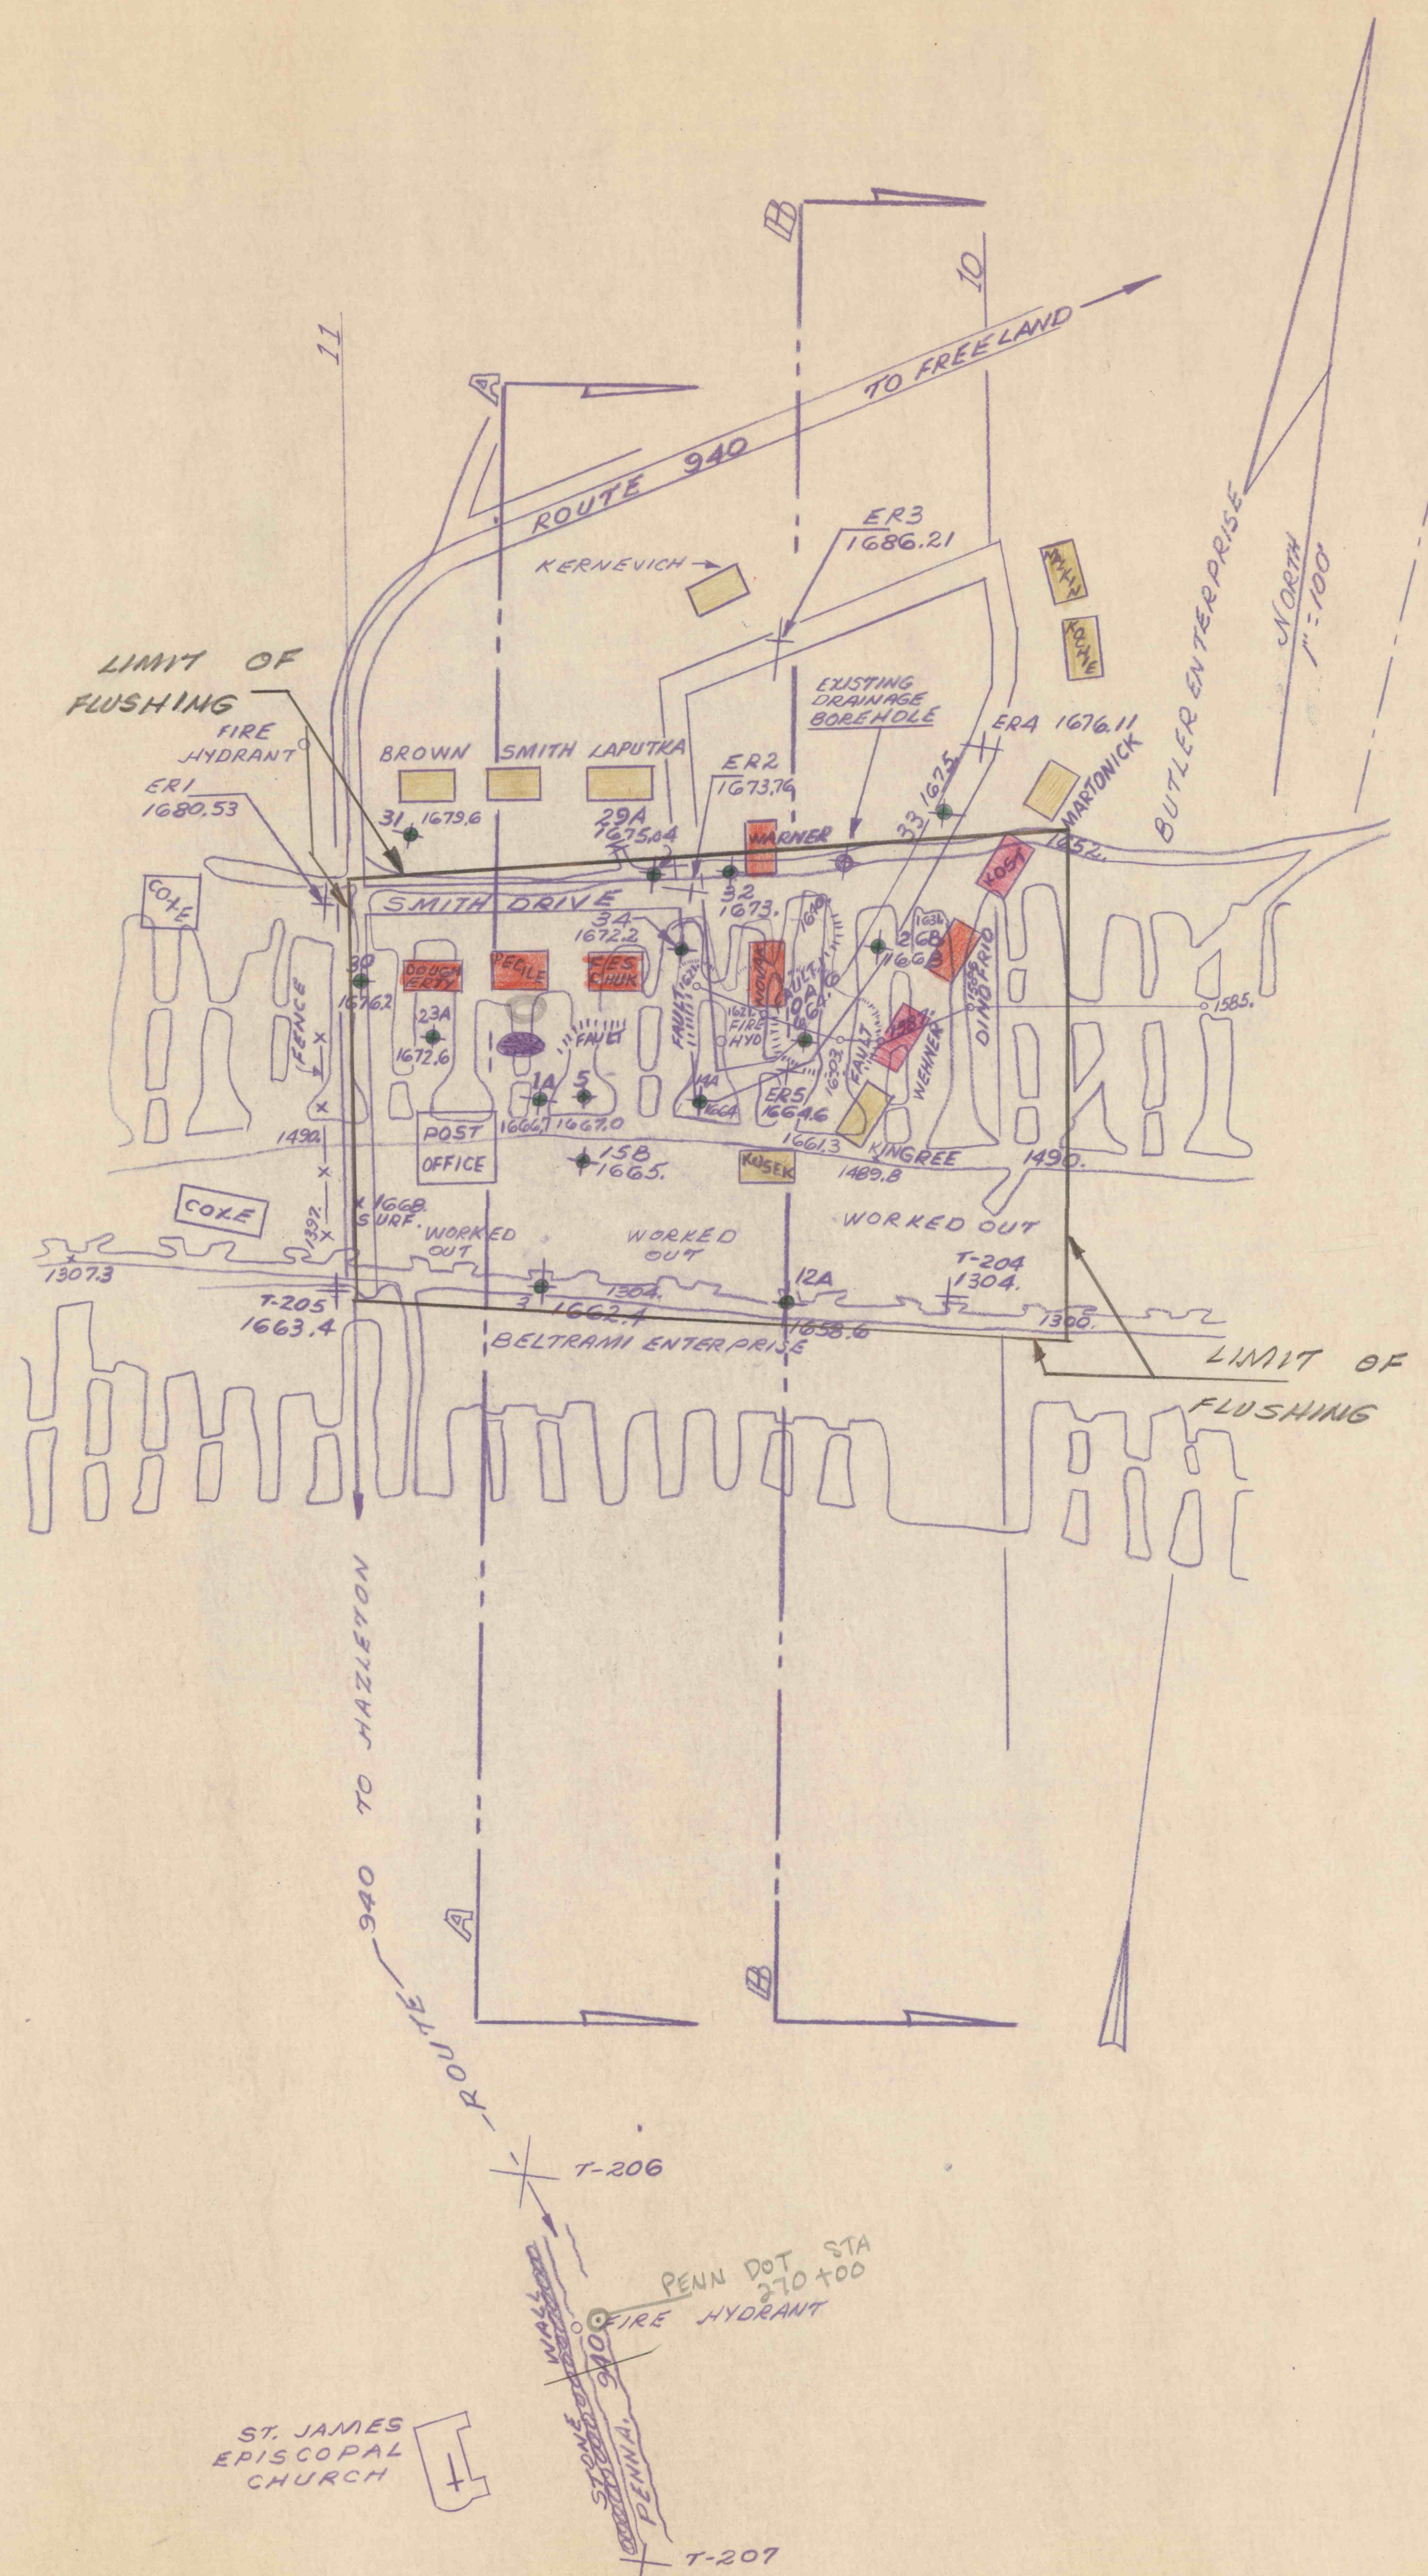

- ÷ LEGEND ÷
- RED = AFFECTED
 - BROWN OCHRE = OFF MEASURES
 - ROSE = POTENTIAL
 - GREEN = BOREHOLES
 - PURPLE = CAVE IN

EXPLORATORY BOREHOLE DRILLING
 ABANDONED DRIFTON COLLIERY MINE
 TOP AND BOTTOM BUCK MTN. VEINS
 AND SURFACE, VILLAGE OF DRIFTON,
 HAZLE TOWNSHIP, LUZERNE COUNTY, PA.
 SCALE 1" = 100' APRIL 20, 1979
 PROJECT NO. **SL483-101.5**
KEEP IN OFFICE

ST. JAMES
 EPISCOPAL
 CHURCH

T-206
 WALL
 STONE
 PENNA.
 FIRE HYDRANT
 T-207