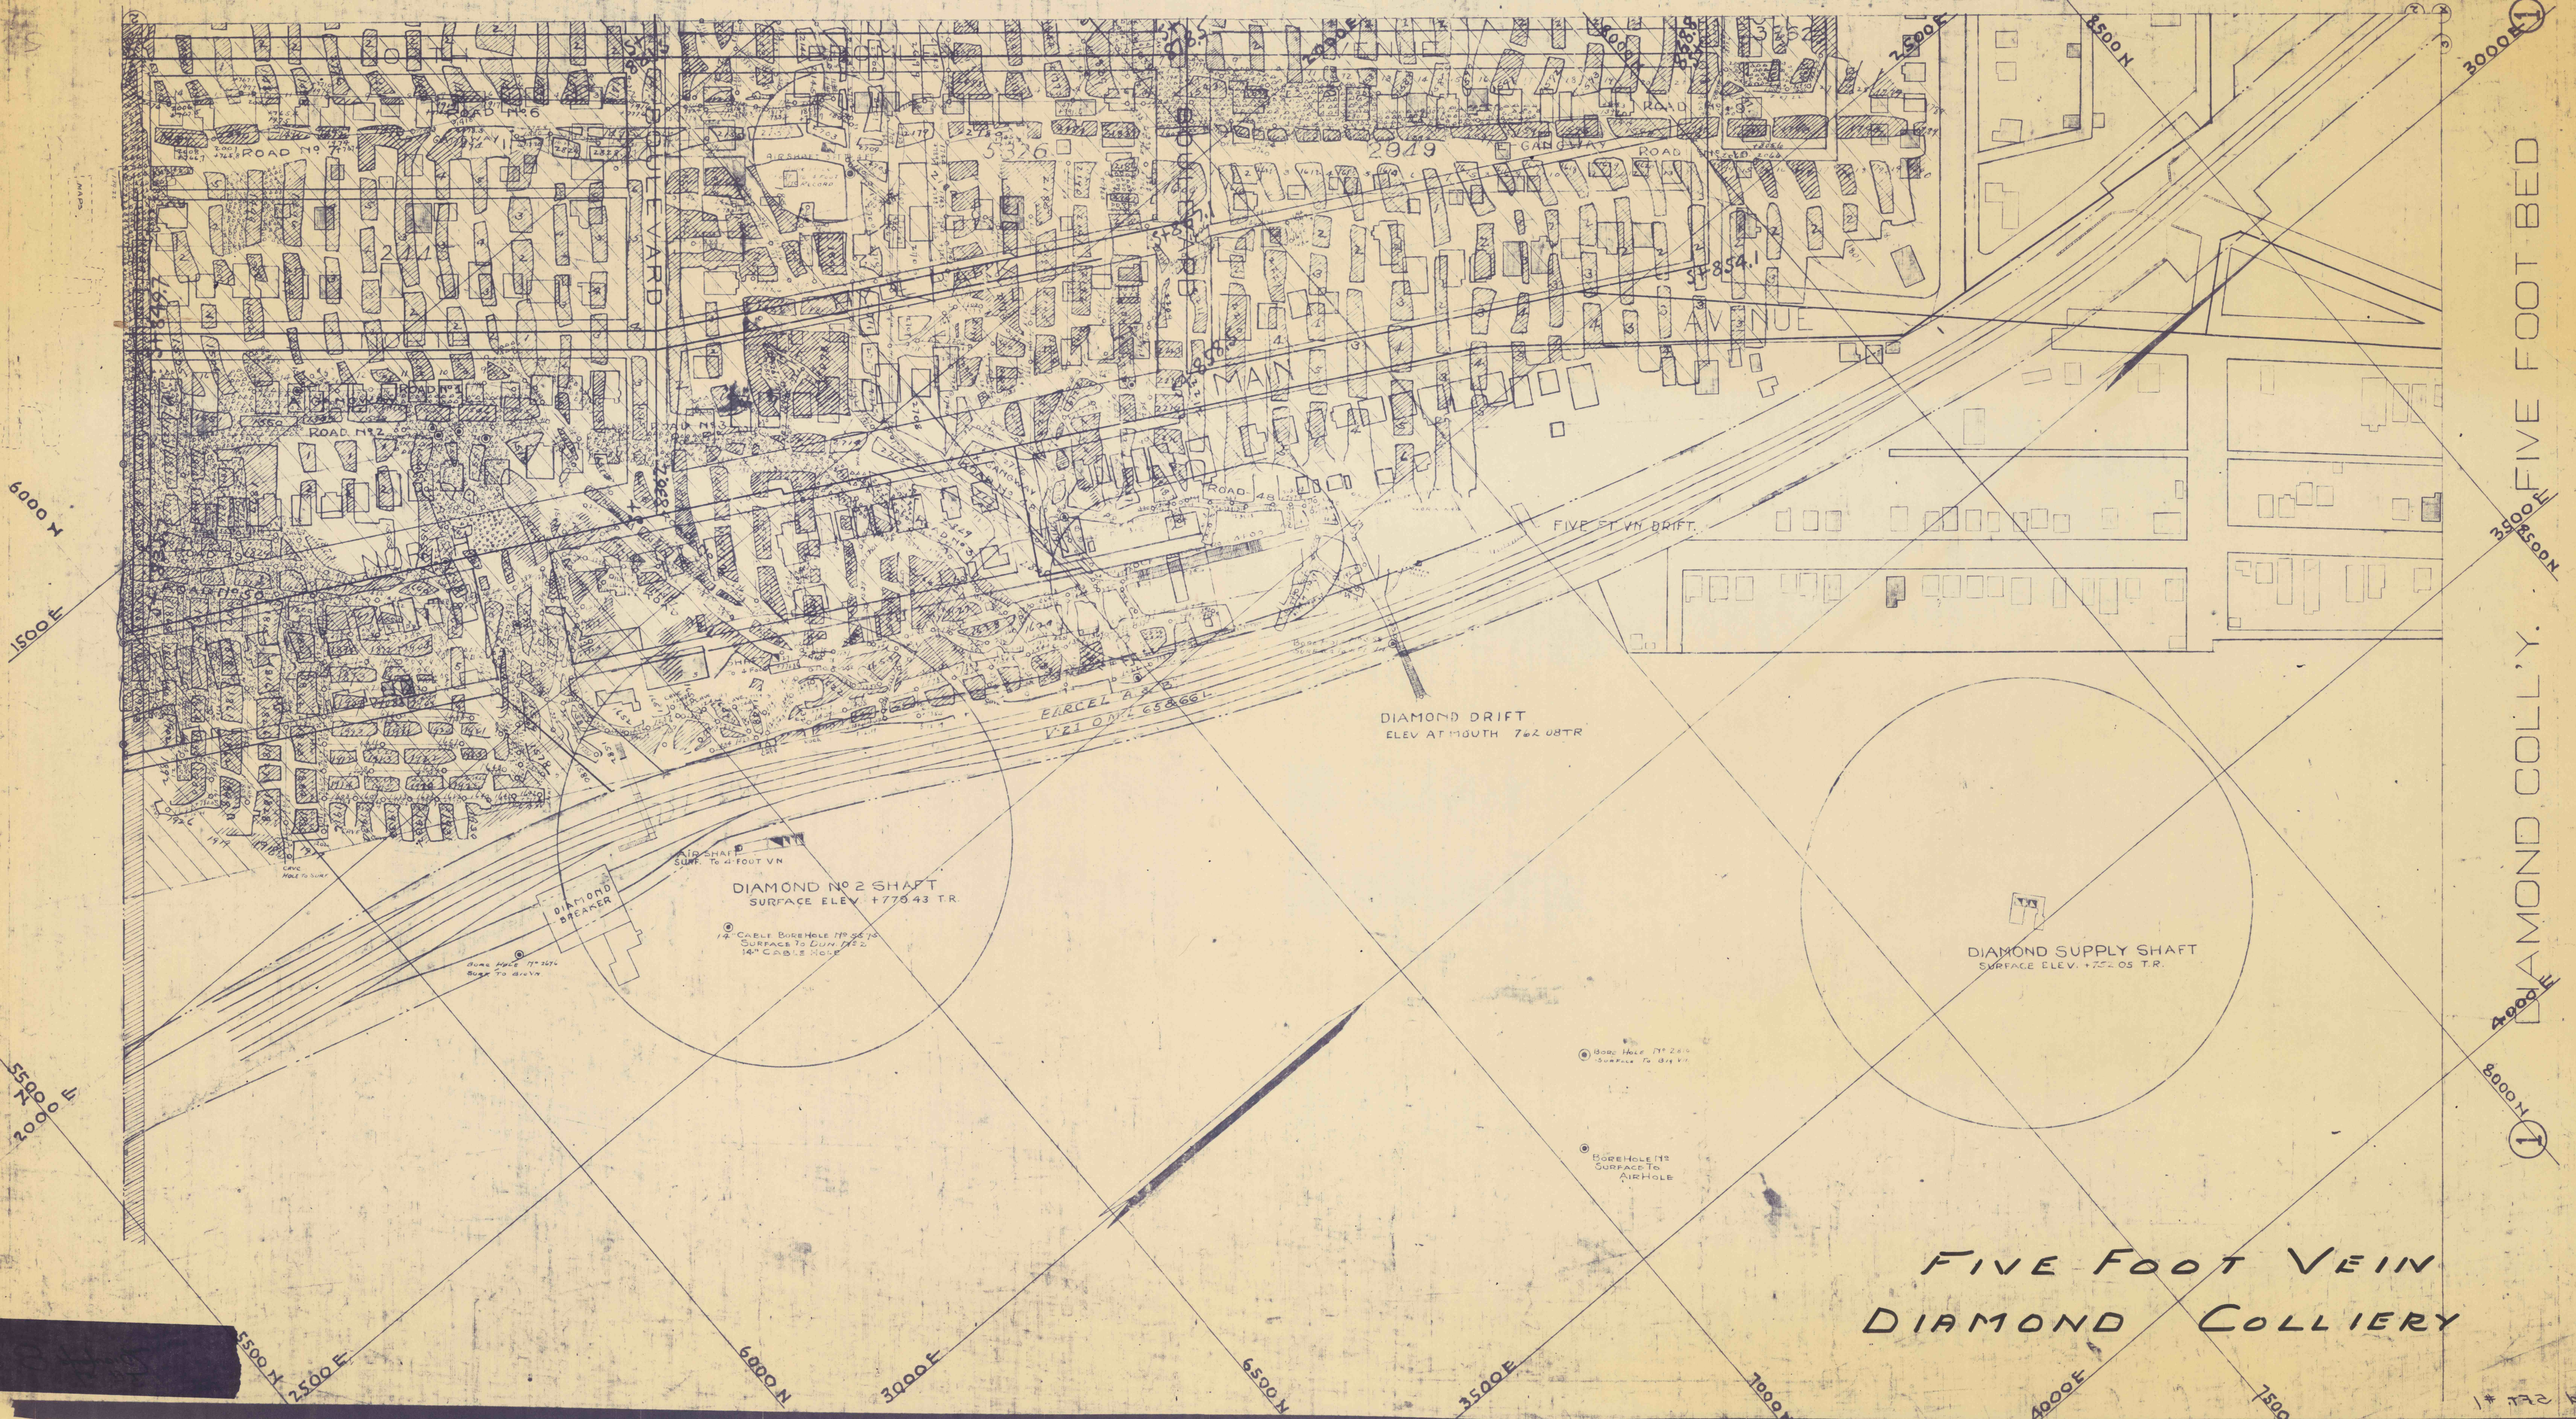
FIVE FOOT VEIN
DIAMOND COLLIERY
DIAMOND COLL'Y. FIVE FOOT BED
MAIN AVENUE
BOULEVARD
ROAD No 7
ROAD No 6
ROAD No 2
ROAD No 3
ROAD 48
CANOVAY ROAD
FIVE FT VN DRIFT
DIAMOND DRIFT
ELEV AT MOUTH 762.08 TR
DIAMOND No 2 SHAFT
SURFACE ELEV. +770.43 T.R.
AIR SHAFT
SURF. TO 41 FOOT VN
DIAMOND BREAKER
14" CABLE BOREHOLE
SURFACE TO DUN
14" CABLE HOLE
DIAMOND SUPPLY SHAFT
SURFACE ELEV. +765.05 T.R.
BOREHOLE No
SURFACE TO
AIR HOLE
6000 N
1500 E
5500 N
2000 E
5500 N
2500 E
6000 N
3000 E
6500 N
3500 E
7000 N
4000 E
7500
8500 N
2500 E
3000 E
3500 E
4000 E
8000 N