


PEARL ST.

LAUREL ST.

BOWMAN ST.

ALLEY

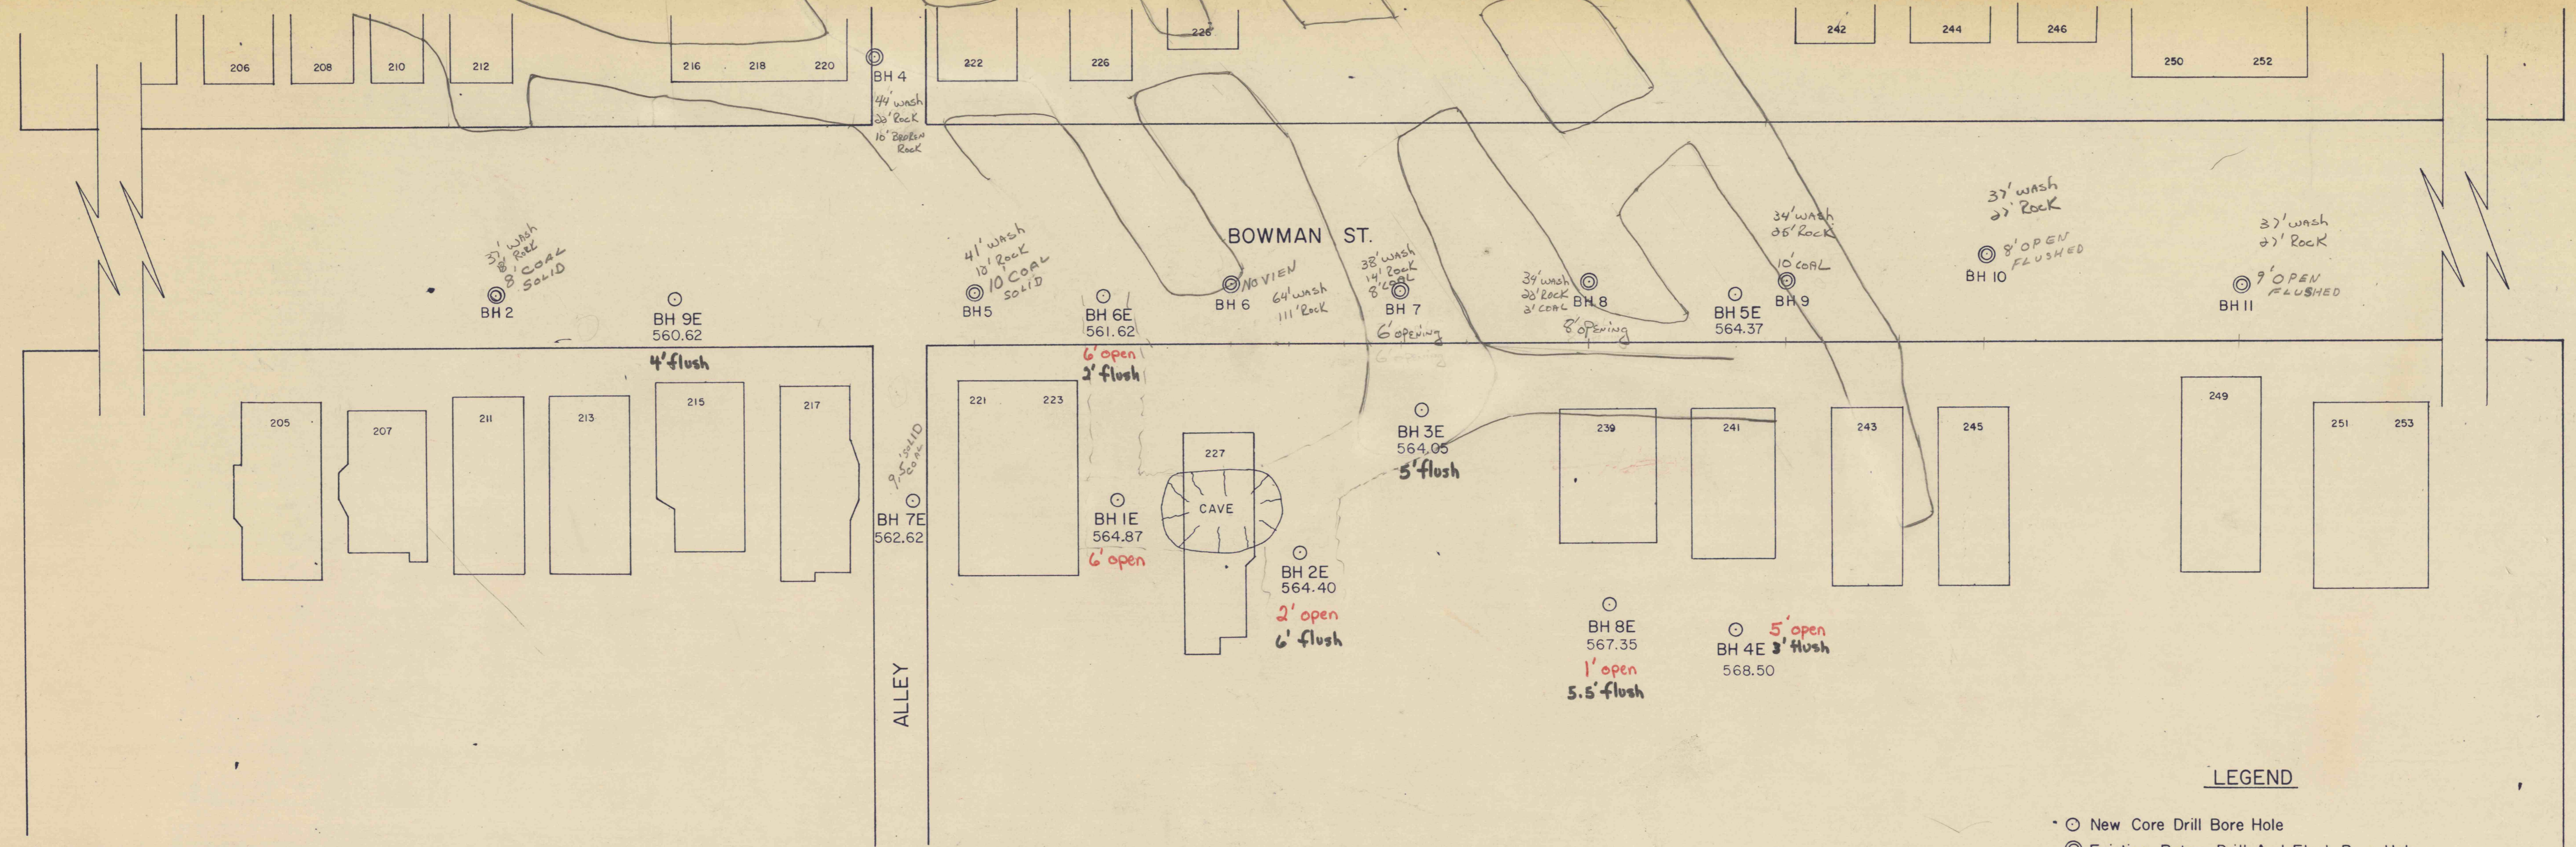


LEGEND

- New Core Drill Bore Hole
- ⊙ Existing Rotary Drill And Flush Bore Hole

SCALE
1" = 20'

570
560
550
540
530
520
510
500
490

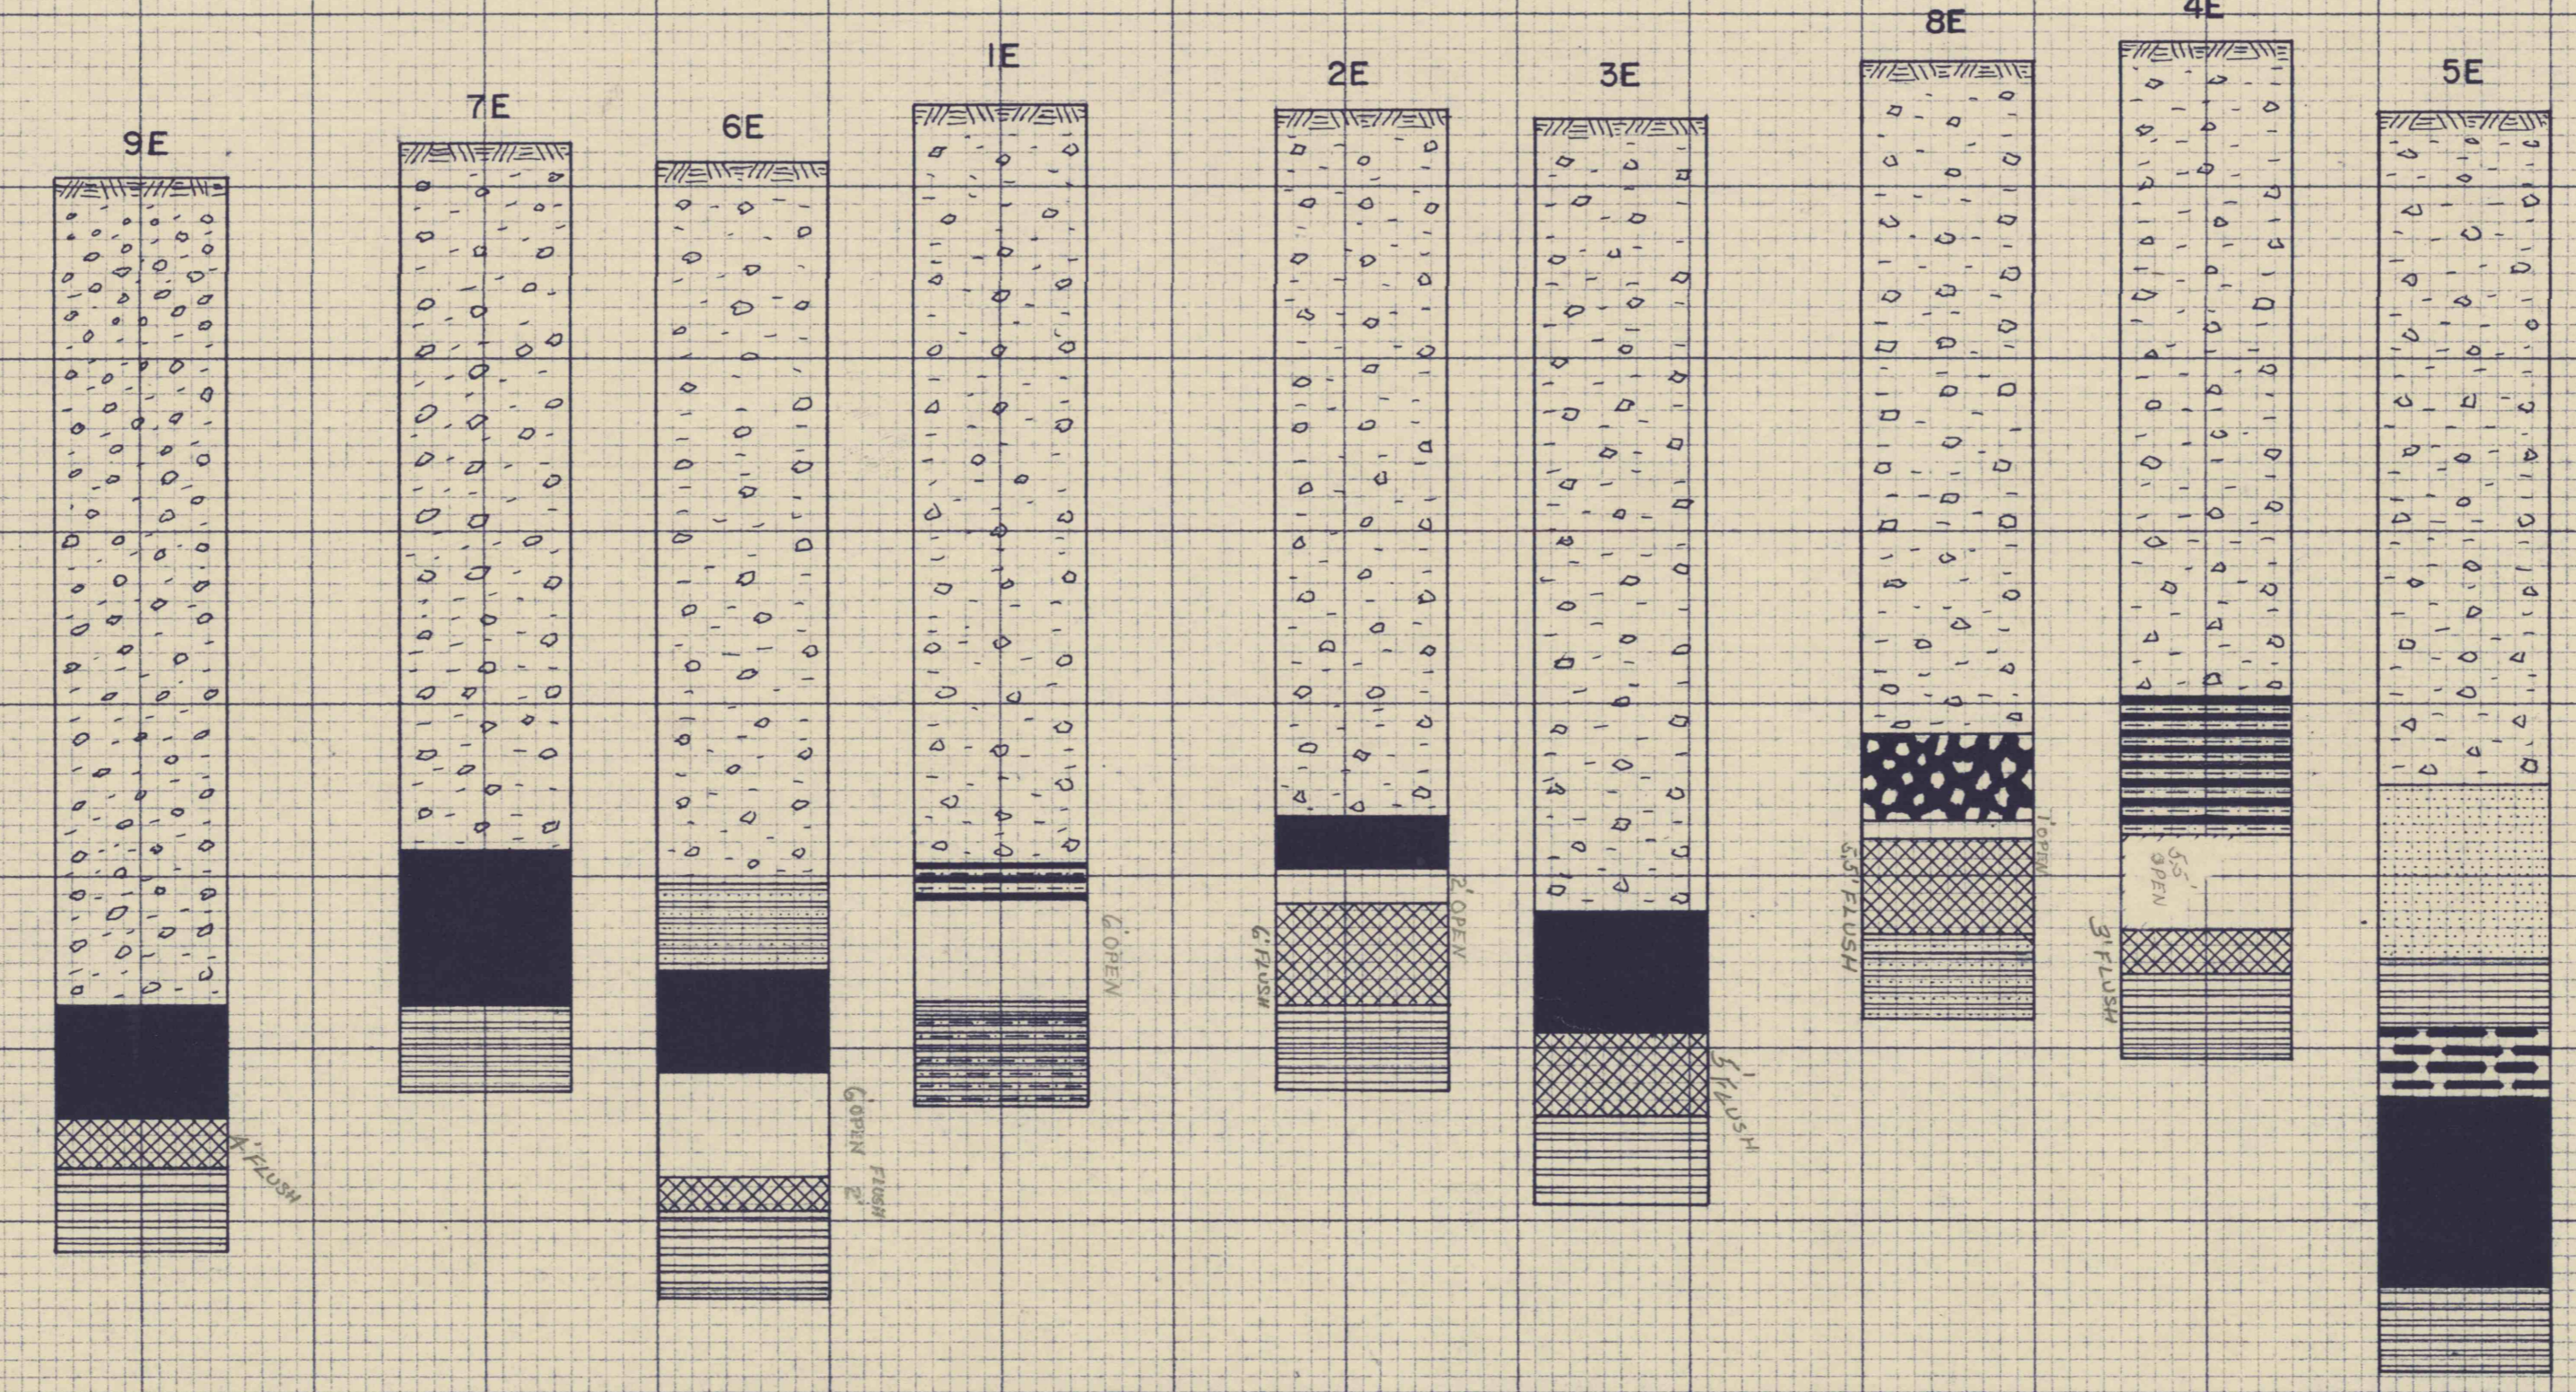

LEGEND

- VOID
- ▨ FLUSH
- COAL
- ▤ COAL (with clay seams)
- ▥ BROKEN COAL
- ▧ BROKEN COAL (with siltstone)
- ▩ SILTSTONE
- SILTSTONE (with clay seams)
- SANDY SILTSTONE
- ▬ GRAYWACKE

SCALE
1" = 10'

STRATIGRAPHIC CROSS SECTION
BOWMAN STREET
CITY OF WILKES BARRE
LUZERNE COUNTY, PENNSYLVANIA
SL 479-101.5