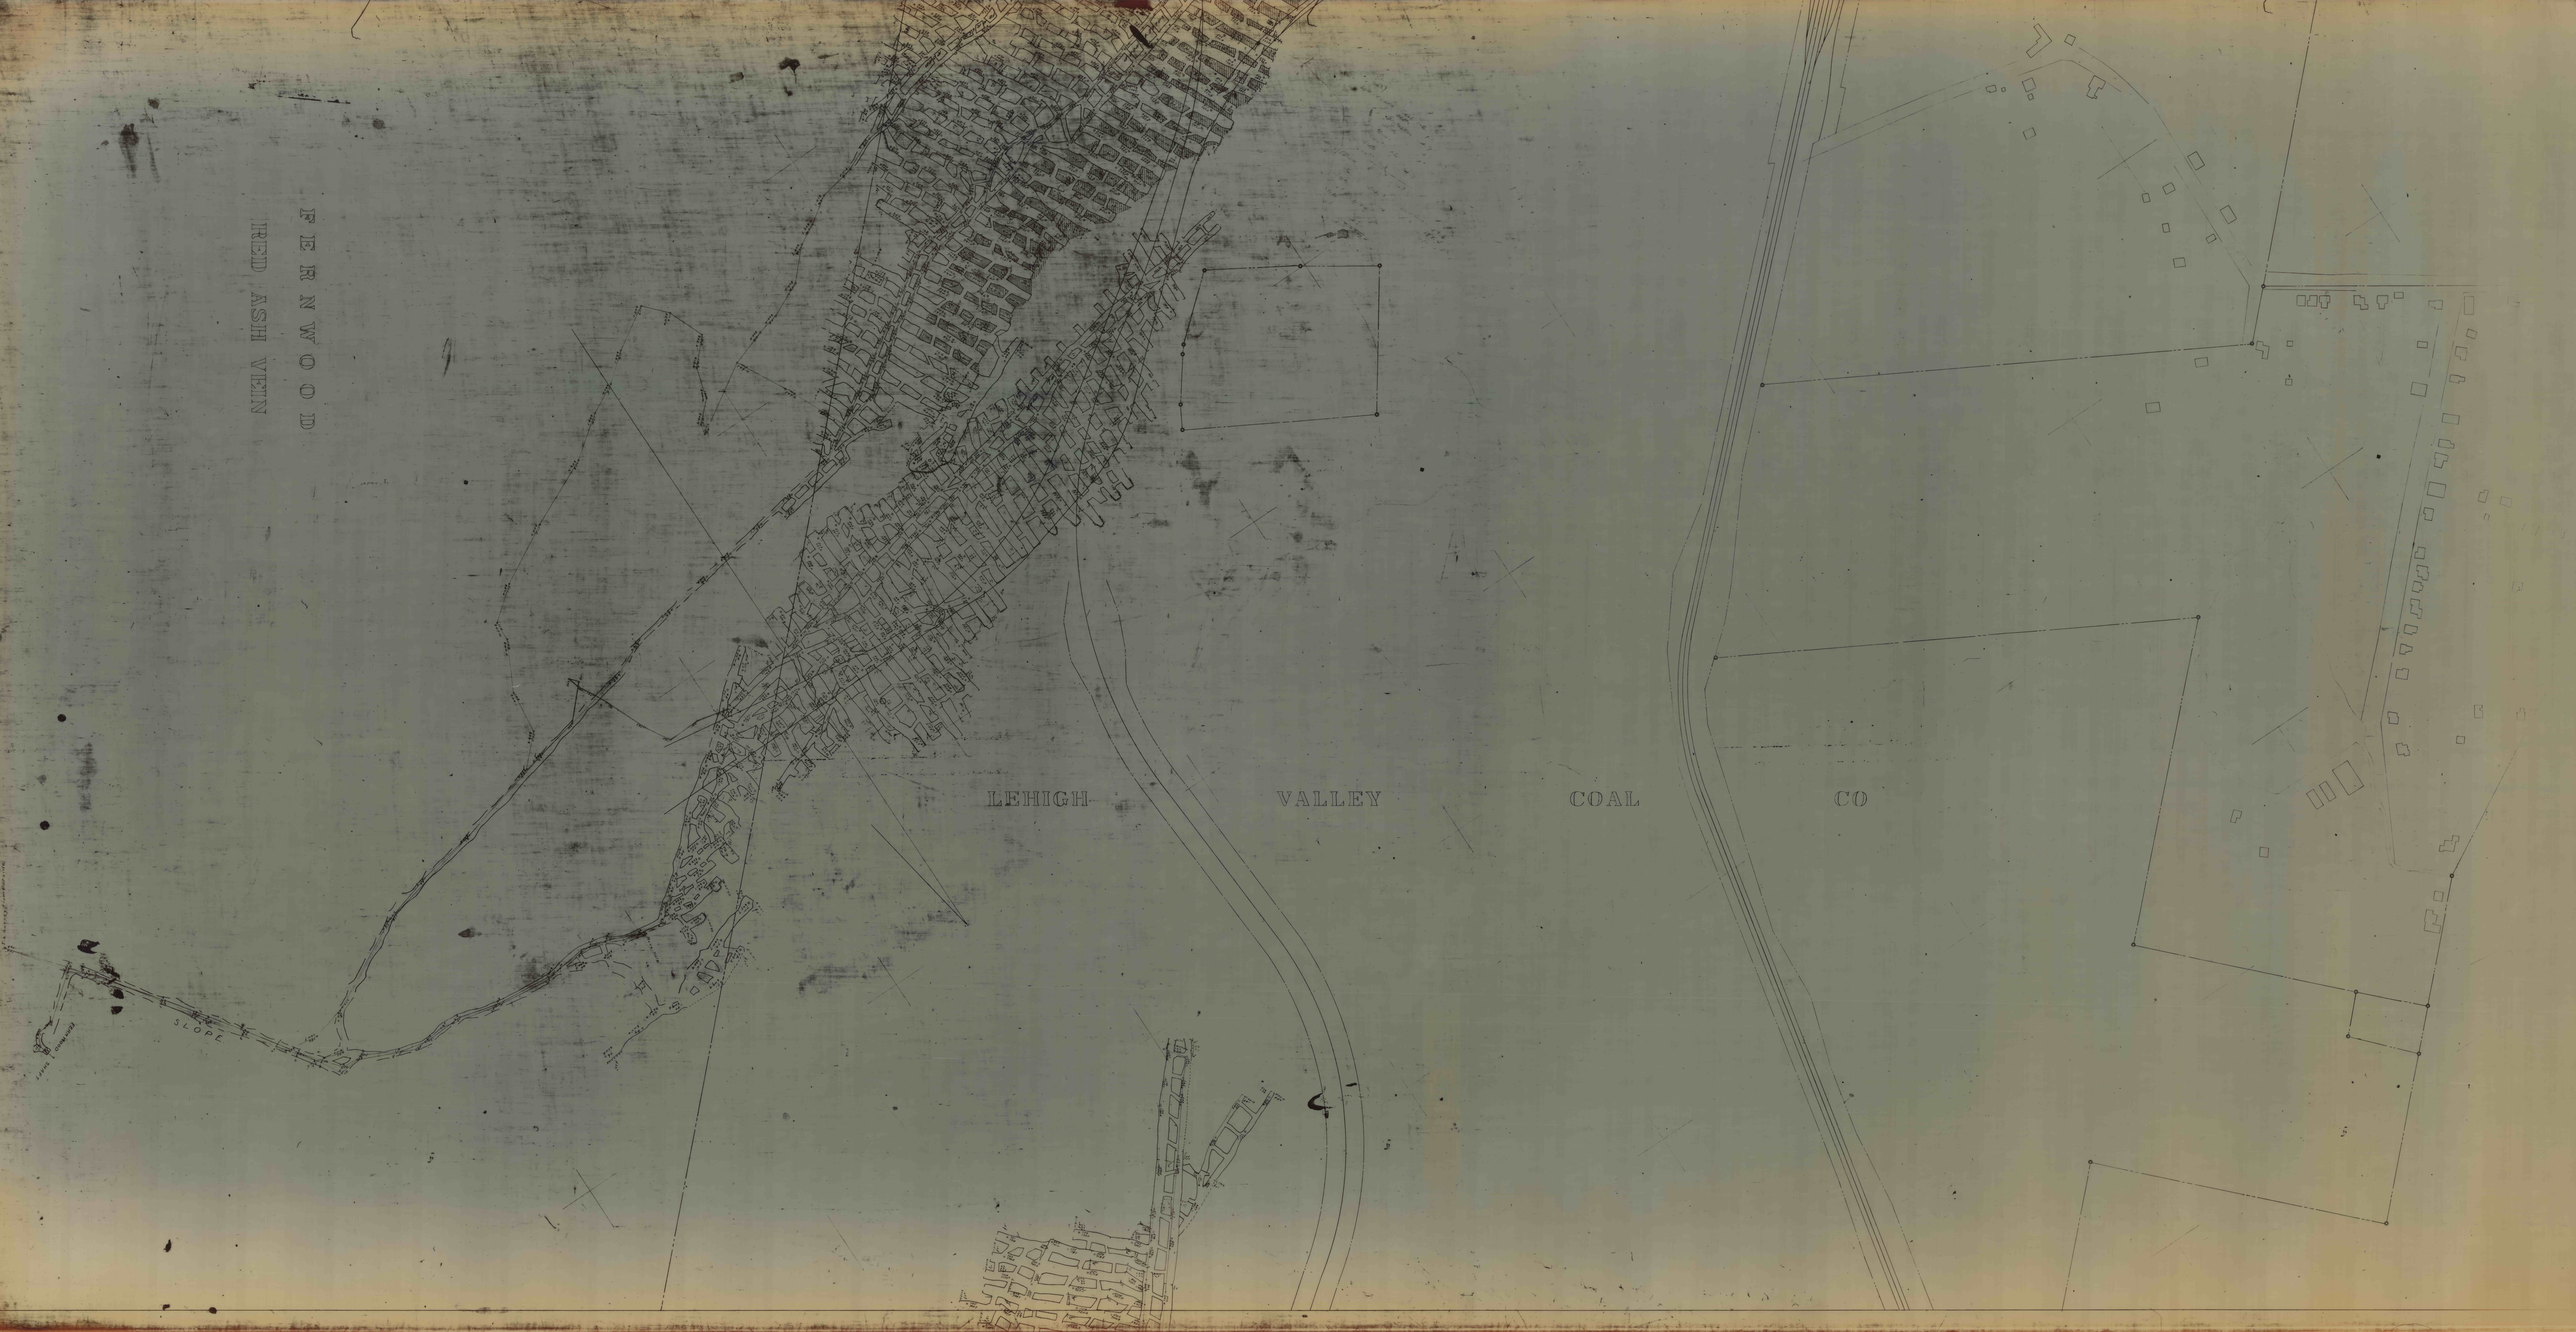
FERNWOOD
RED ASH VEIN
LEHIGH VALLEY COAL CO
SLOPE