


WALKER

MERRIMAN

1888

EVERHART

1868

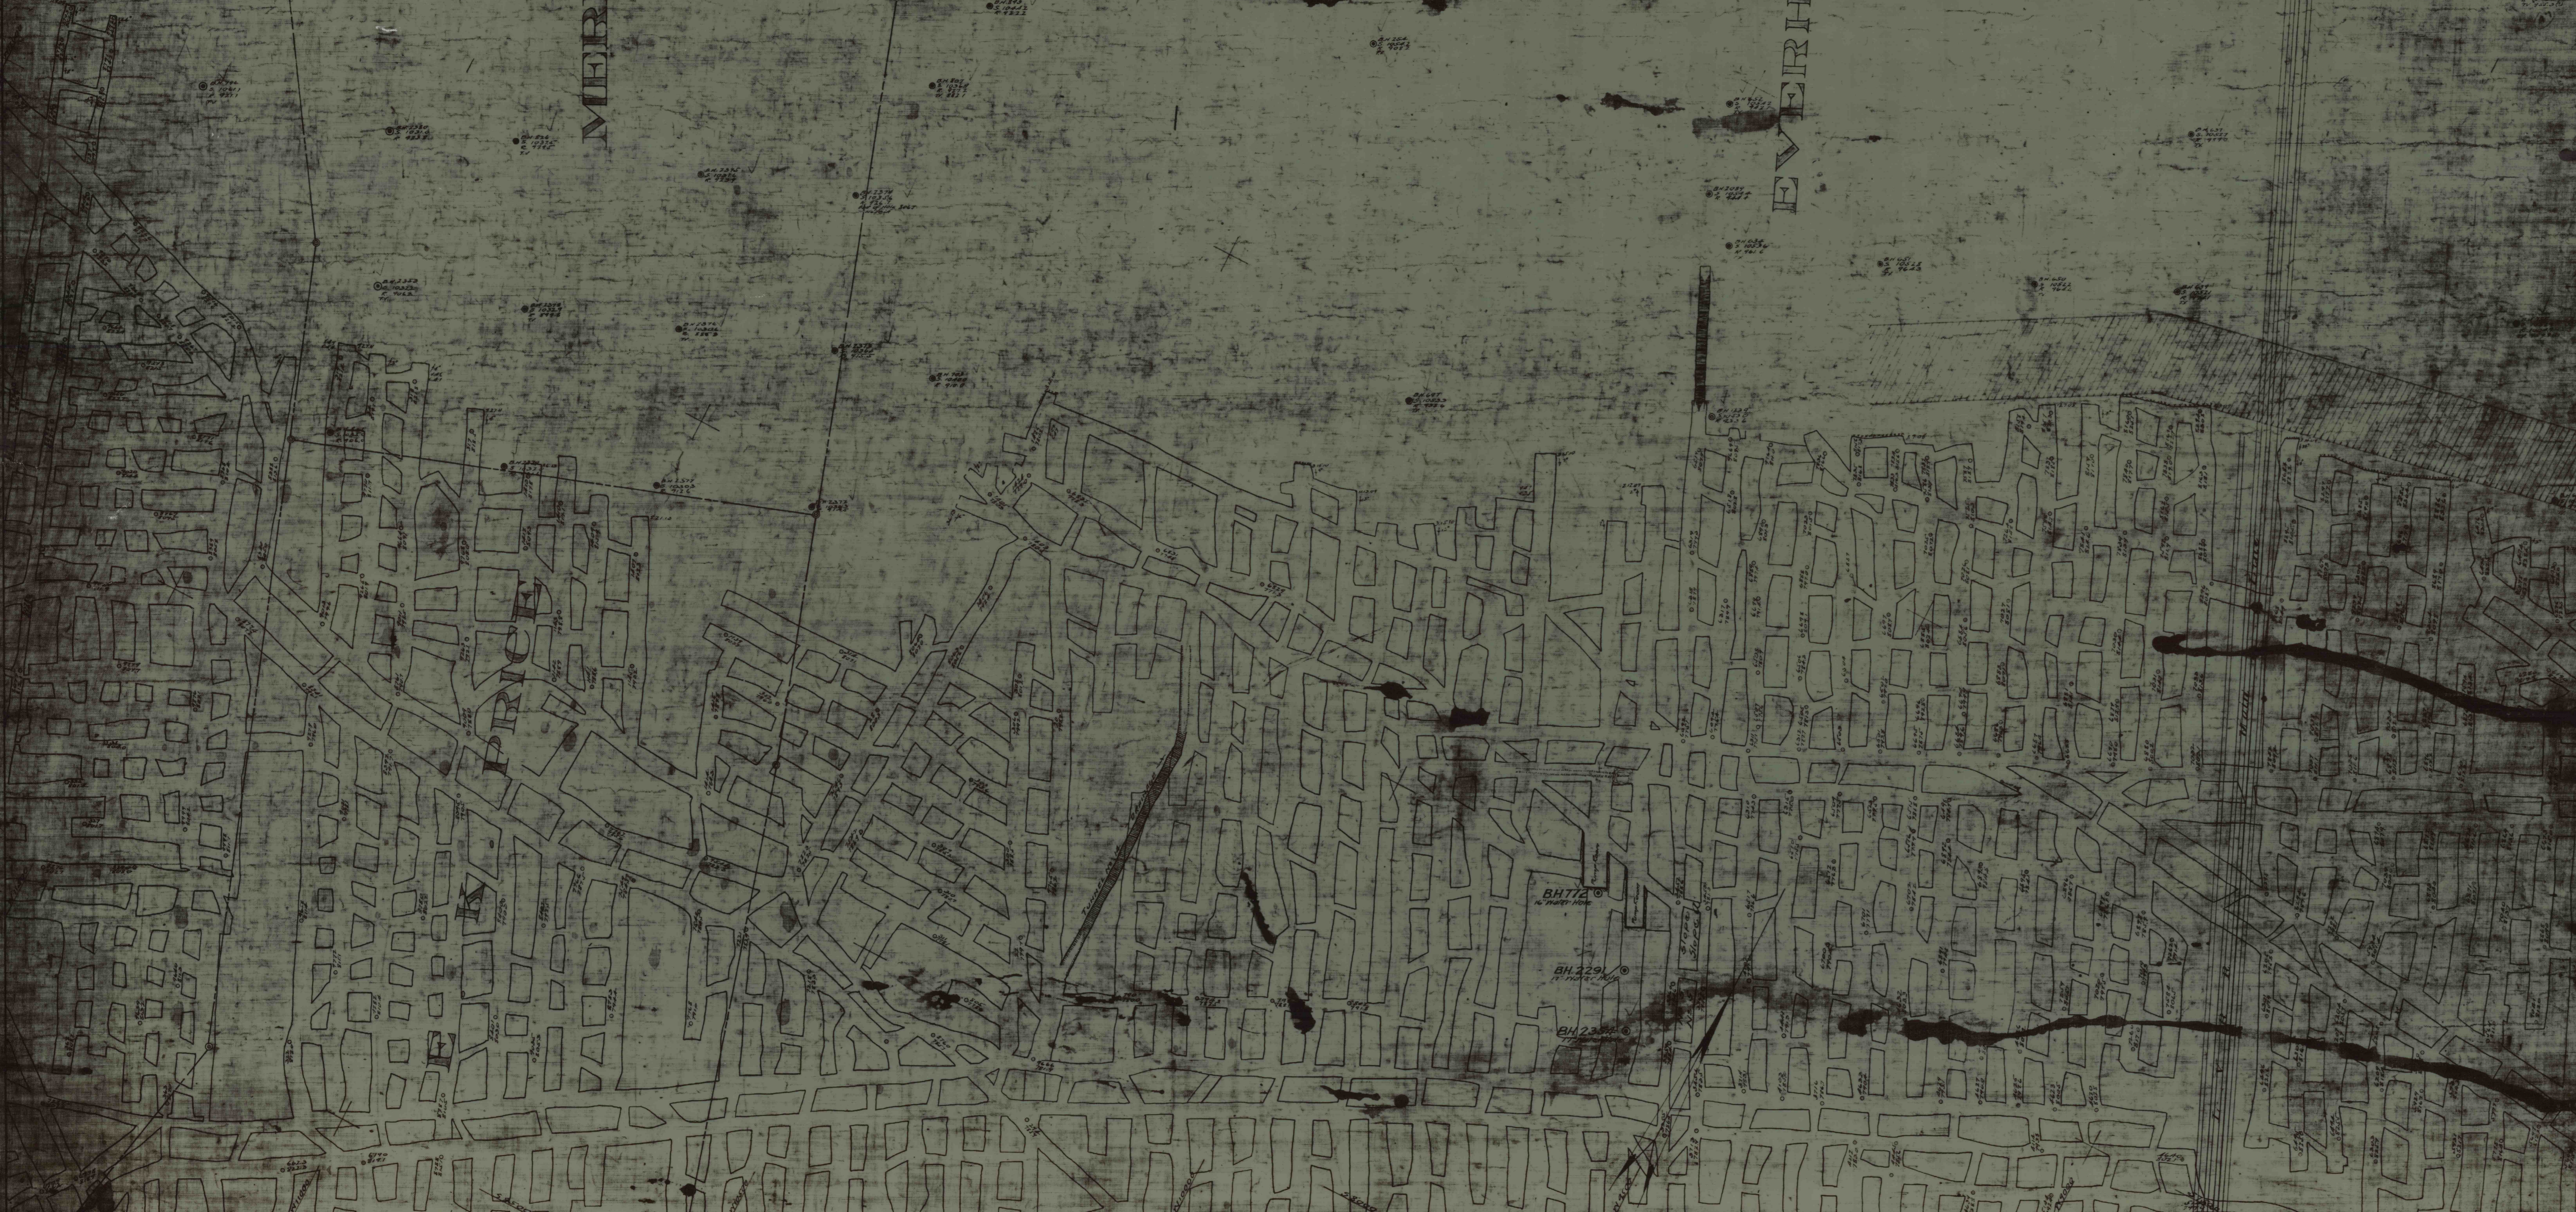

WM A CO
MARCY VEN W