

S

T

R

E

B

Q

R

R

O

N

A

A

R

R

C

O

N














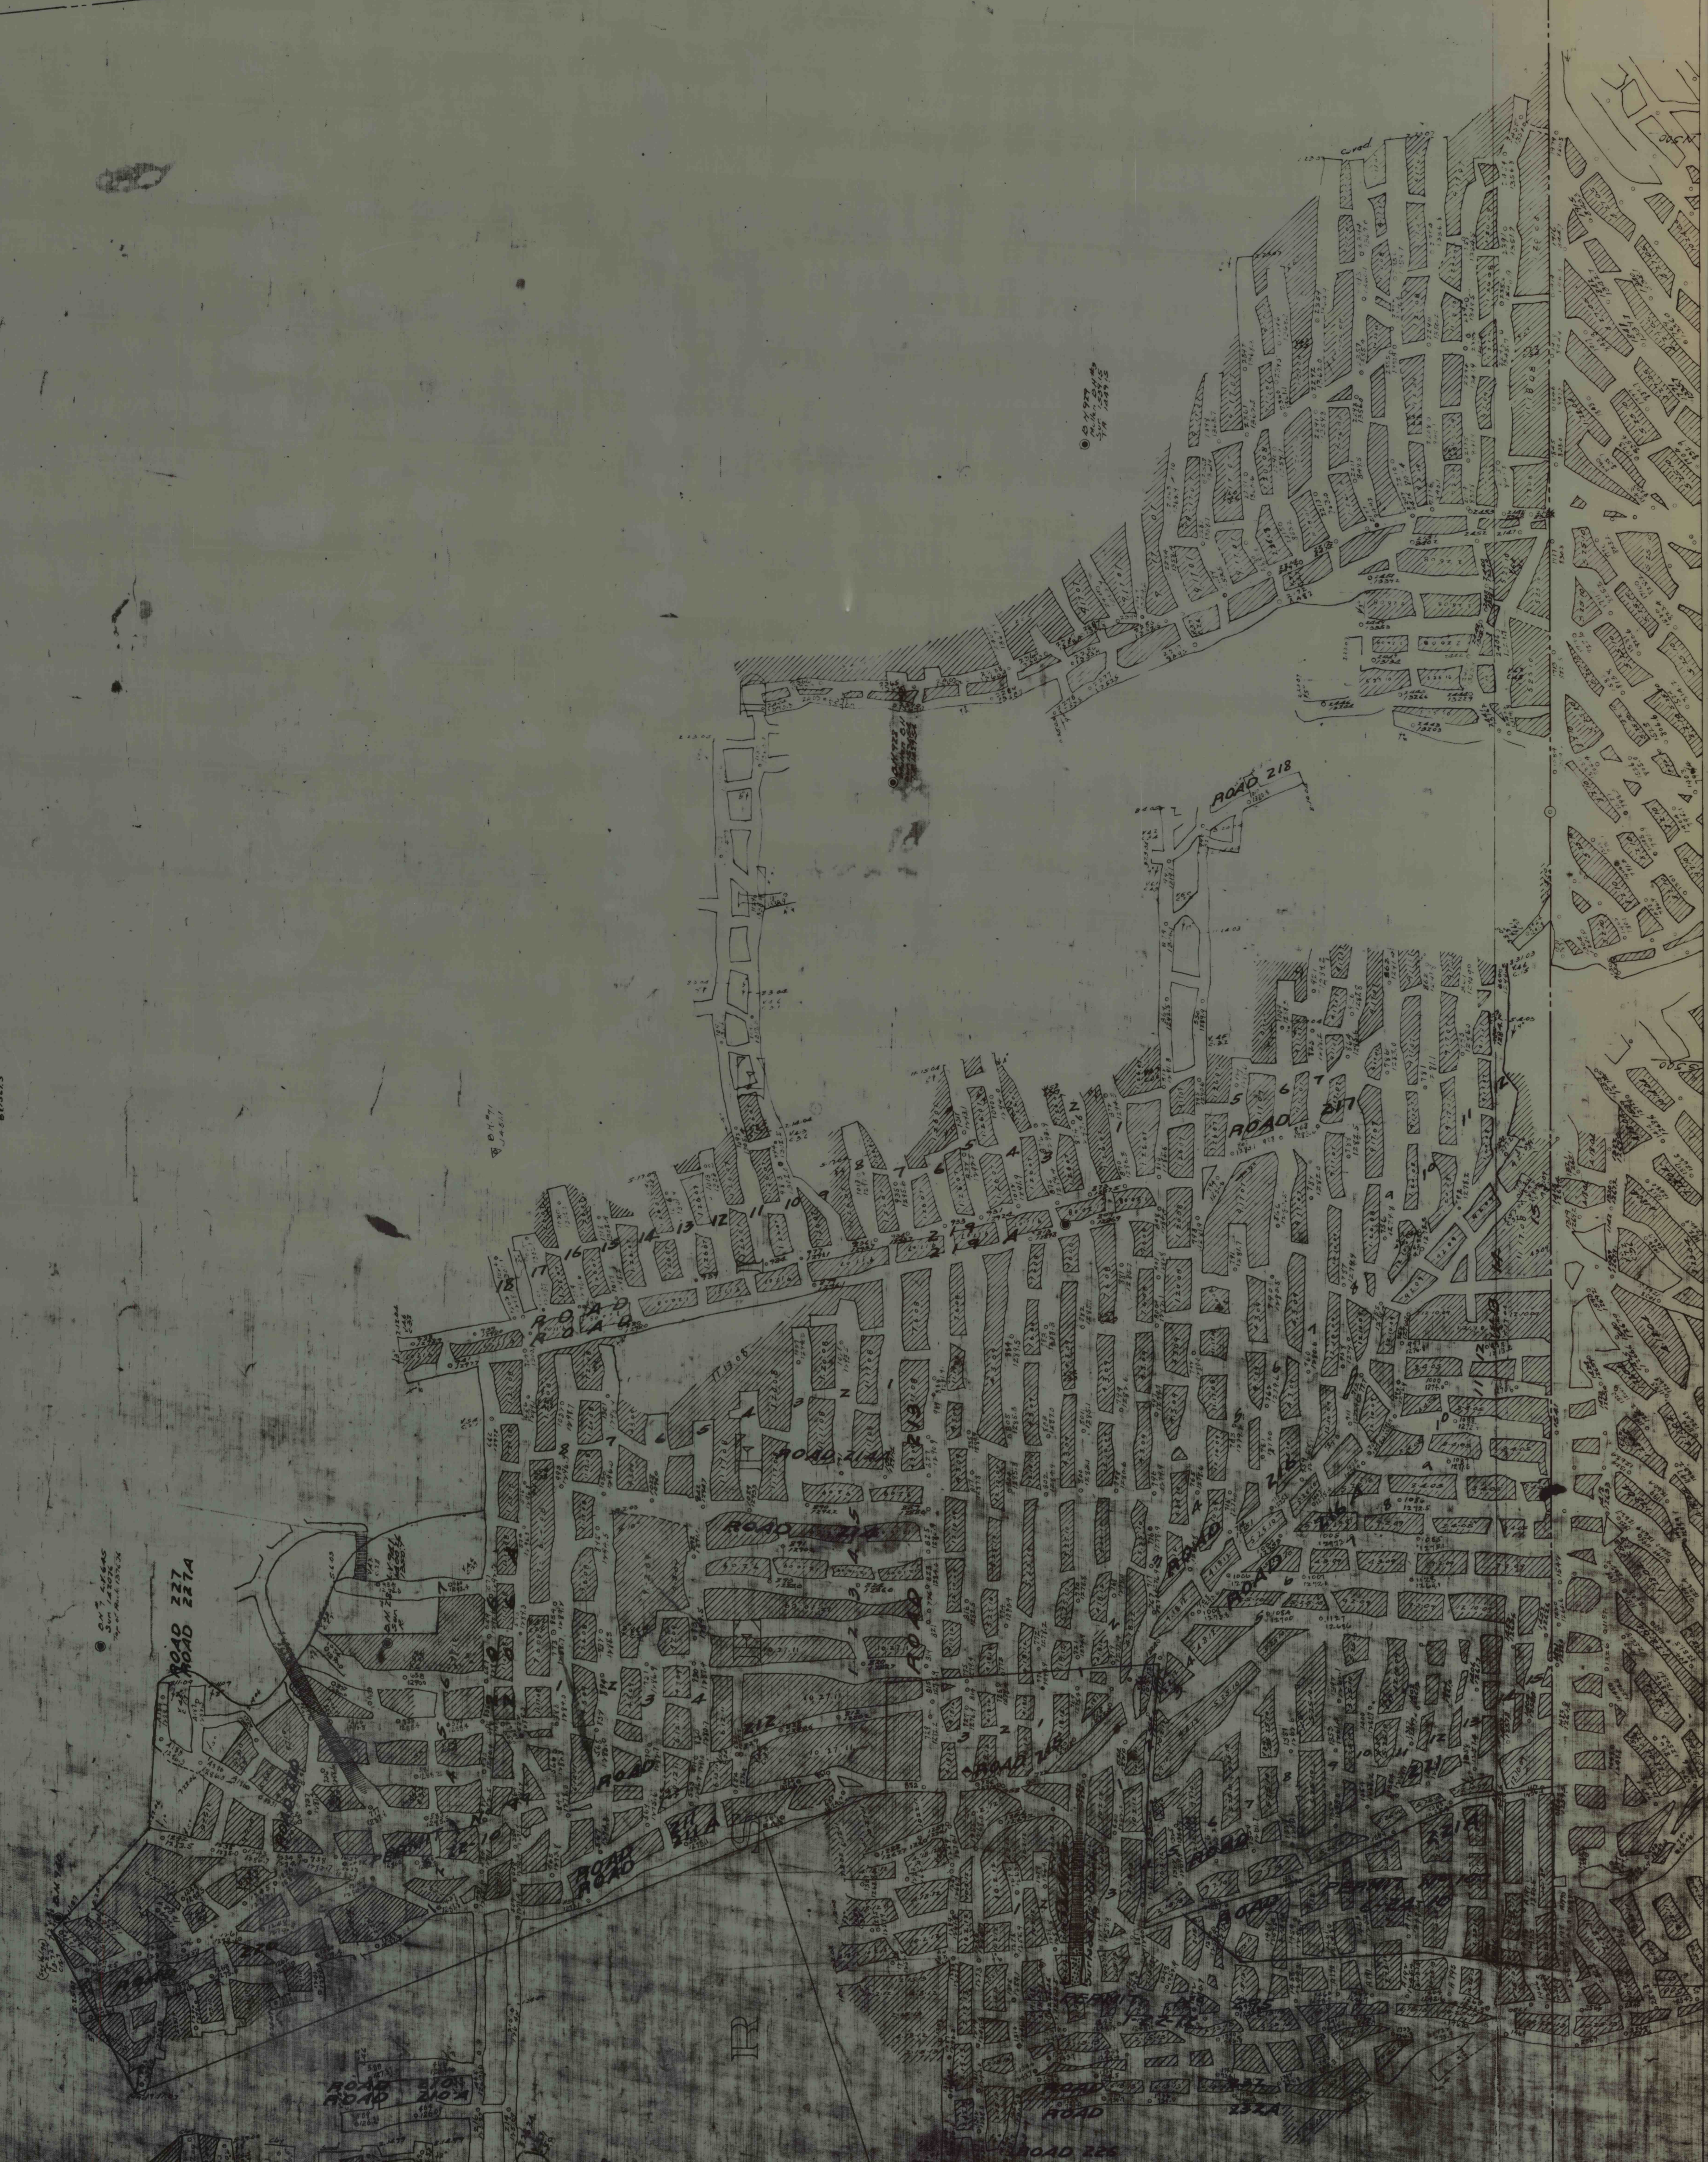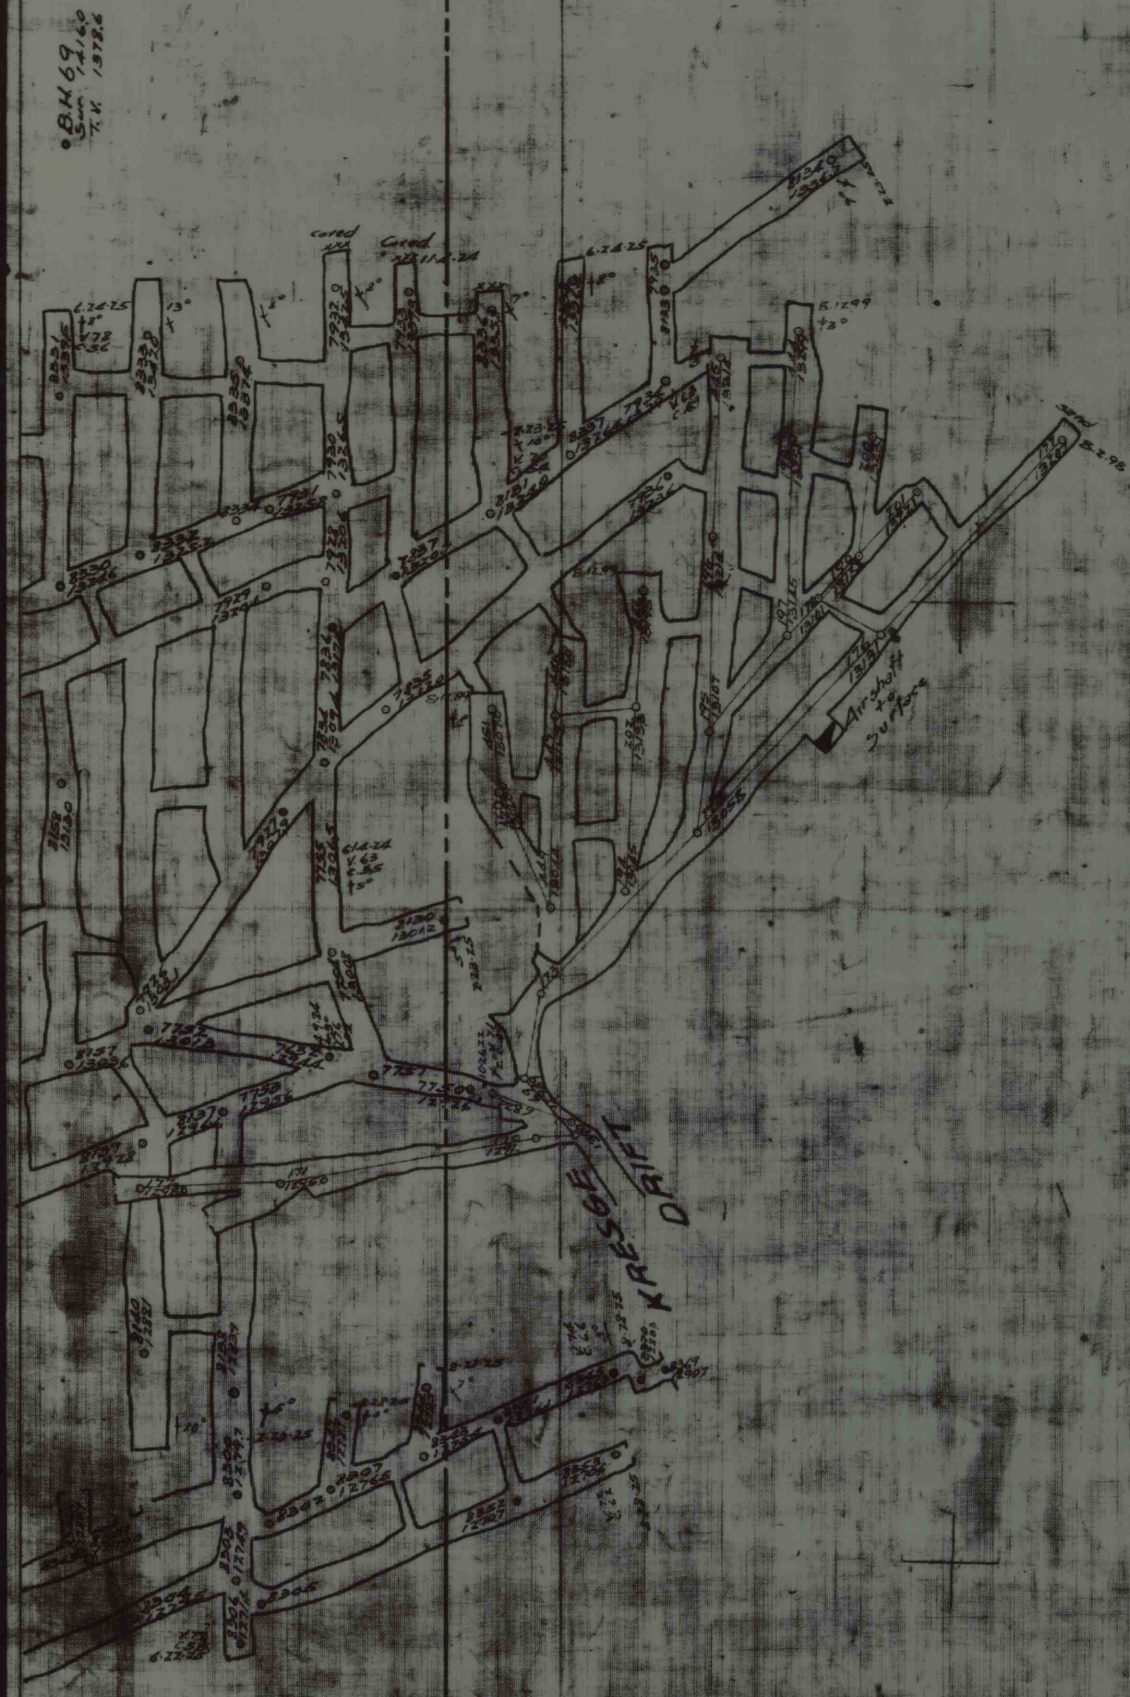





