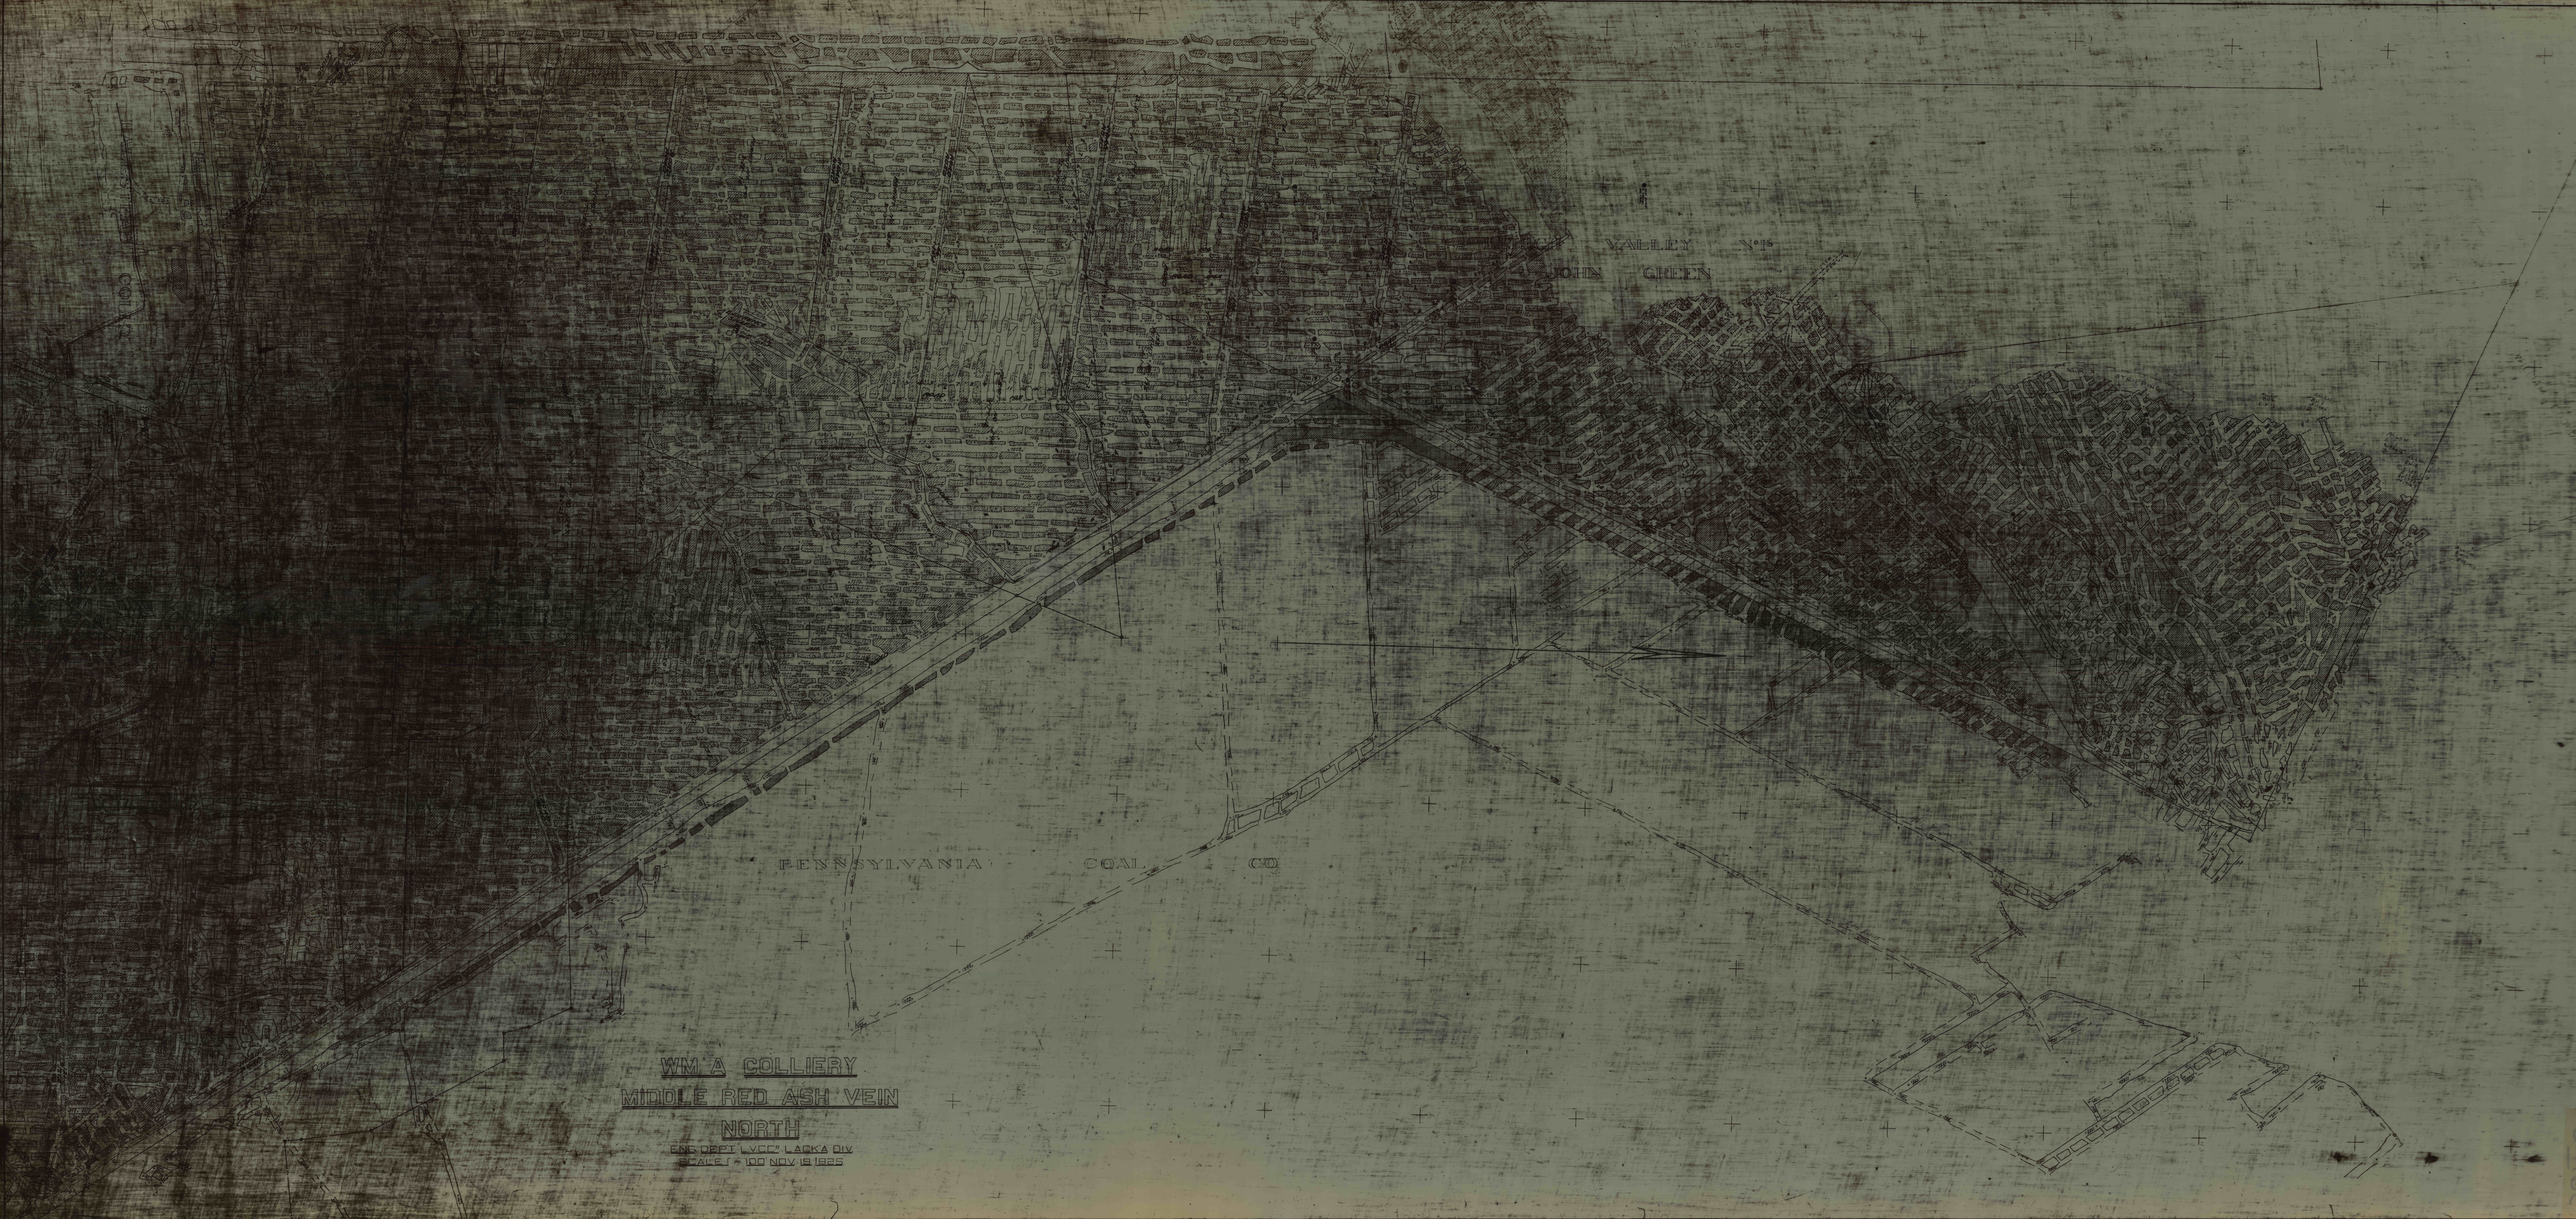
VALLEY No 15
JOHN GREEN
PENNSYLVANIA COAL CO
WM A COLLIERY
MIDDLE RED ASH VEIN
NORTH
ENG DEPT LVCC's LACKA DIV
SCALE 1" = 100' NOV 19 1925