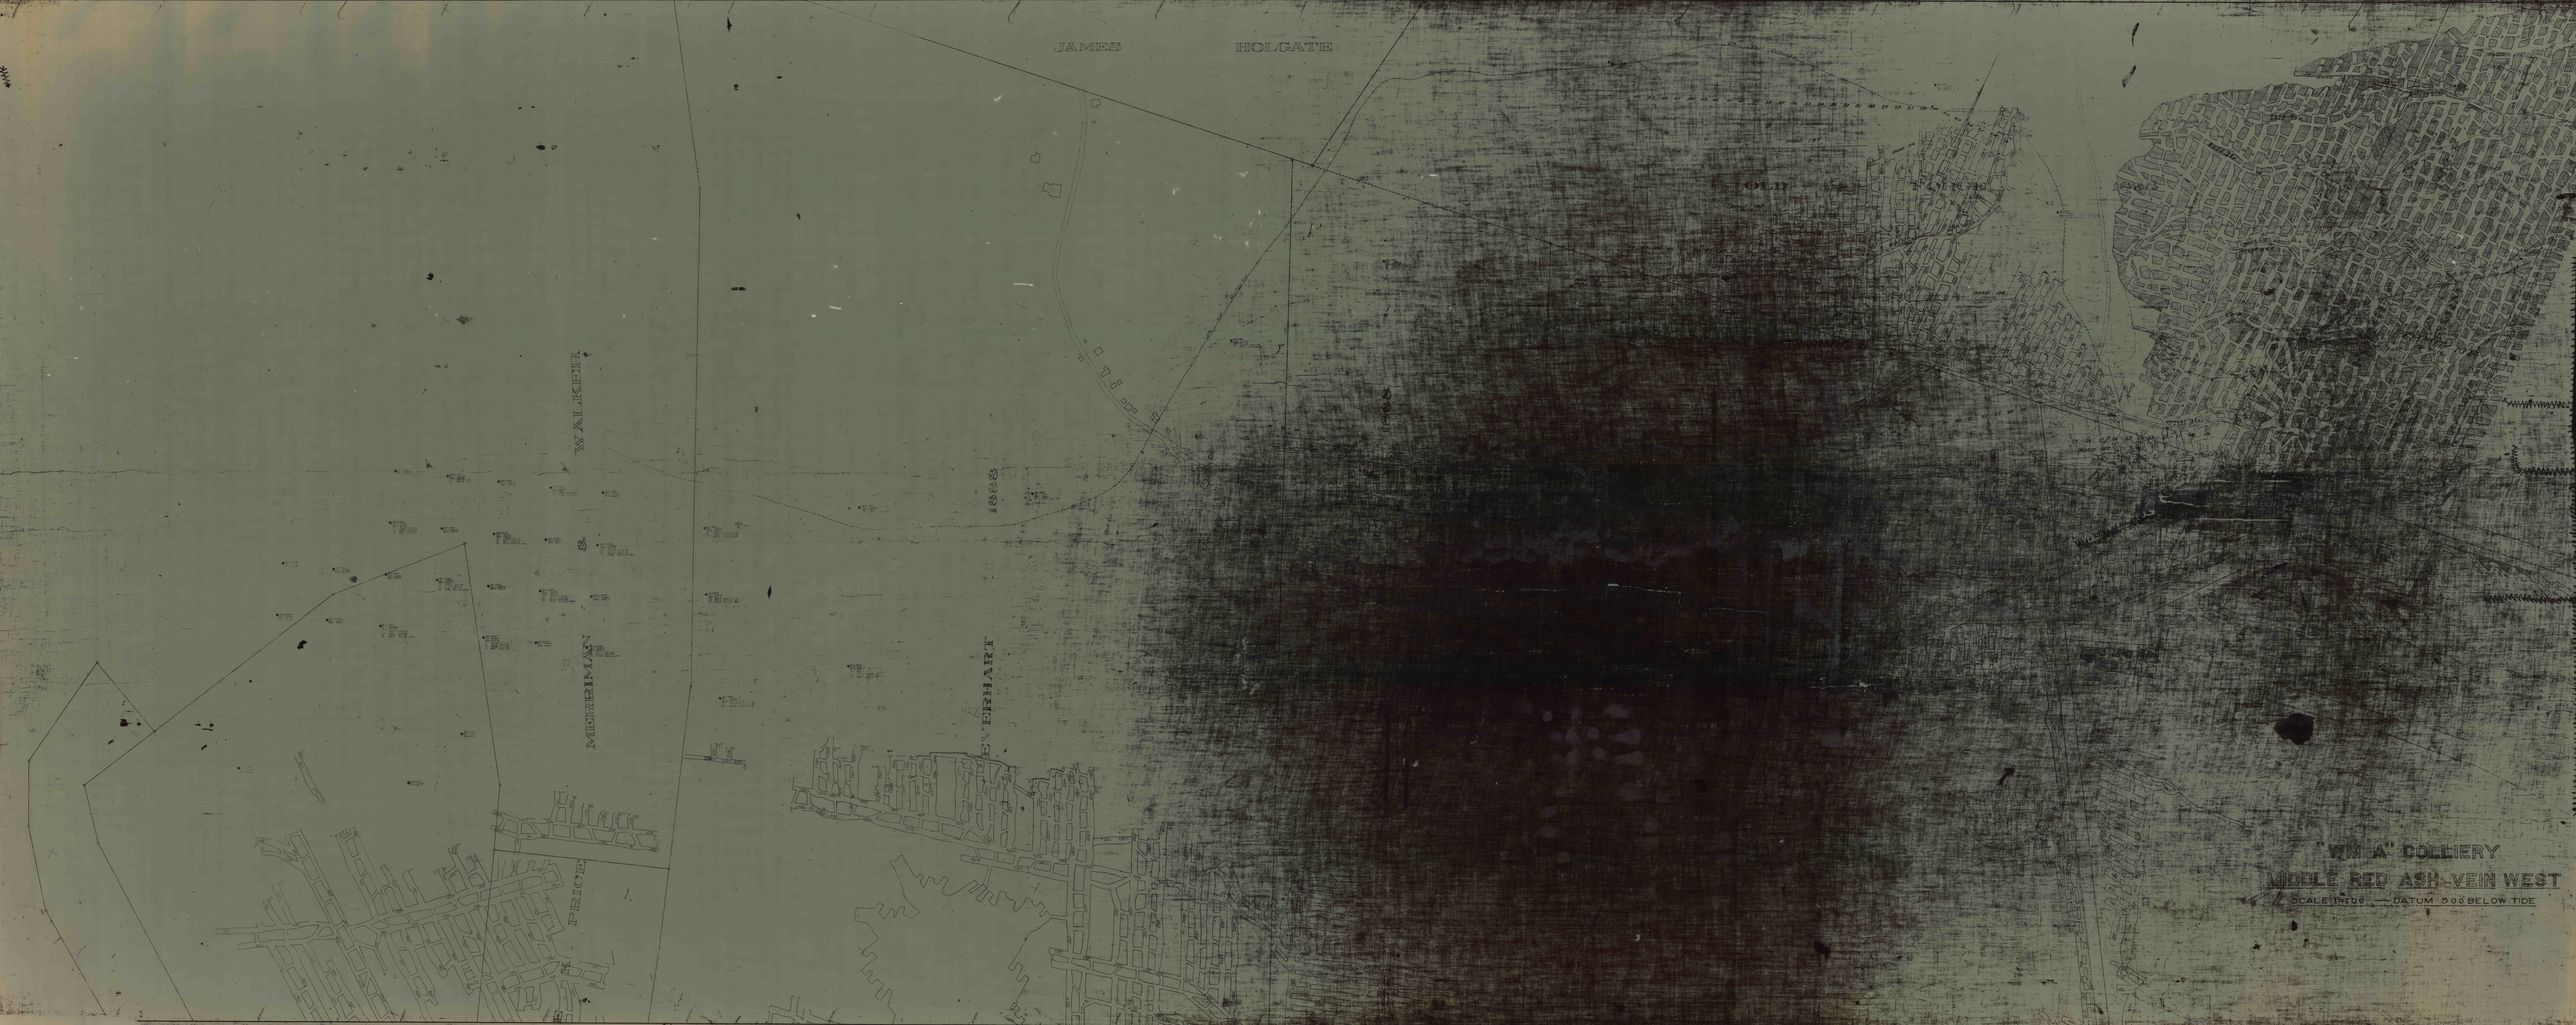
JAMES
HOLGATE
OLD
WALKER
MERRIMAN
1868
EVERHART
PRICE
"VM A" COLLIERY
MIDDLE RED ASH VEIN WEST
SCALE 1"=100' — DATUM 500 BELOW TIDE