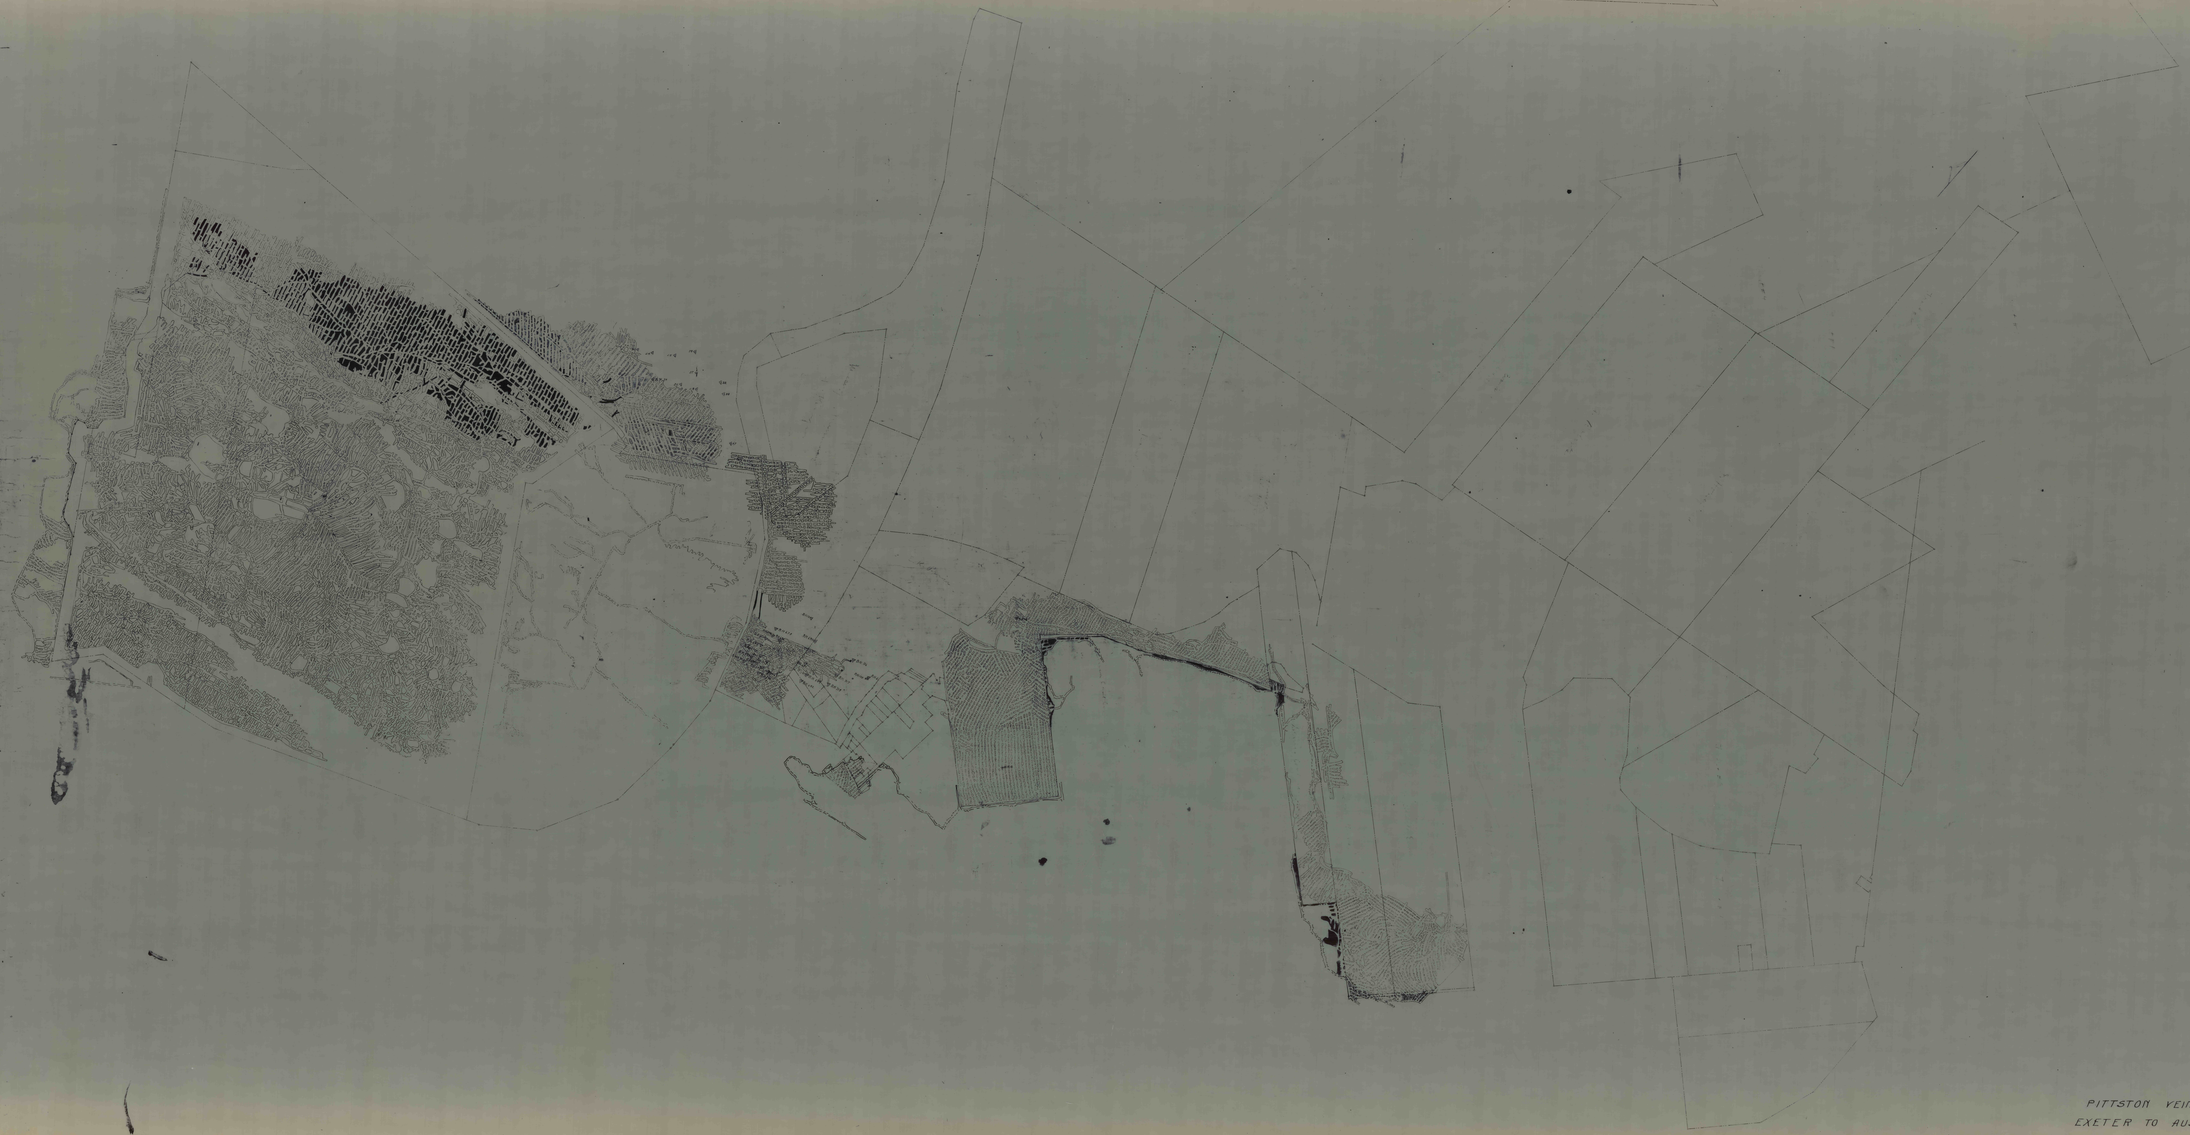

PITTSTON VEIN
EXETER TO AUSTIN